

MATCH LINE SHEET 37

PIN ID# 16x605

**horizons**  
Engineering Inc.

17 Sunset Terrace  
Newport, Vermont 05855  
Phone 802.334.6434 - Fax 802.334.5602

STATUTORY SURVEY PREPARED FOR

**VERMONT AGENCY OF TRANSPORTATION**

1 NATIONAL LIFE DRIVE  
MONTPELIER, VT 05633-5001

OF U.S. ROUTE 7  
TOWN OF ST. ALBANS, TOWN OF SWANTON  
FRANKLIN COUNTY, VERMONT


	DATE:	PROJECT #:
	1/12/2017	15522
	SURV'D BY:	DRAWN BY:
	JN, AN, JB	JN, NN
CHECK'D BY:	SCALE:	
AN	1"=40'	
SHEET 36 OF 43		

MONUMENT DETAIL TABLE			
MON. NO.	COORDINATE	STATION	DESCRIPTION
1848	N 876127.97 E 1485743.36	300+75.17 49.50' RIGHT	FENO TYPE MONUMENT SET AT GRADE
2481	N 876093.80 E 1485650.44	300+75.17 49.50' LEFT	FENO TYPE MONUMENT SET AT GRADE
1849	N 876235.28 E 1485703.29	301+89.24 49.50' RIGHT	5/8" REBAR SET AT GRADE
2482	N 876200.19 E 1485610.72	301+89.24 49.50' LEFT	5/8" REBAR SET AT GRADE
1850	N 876431.82 E 1485628.79	303+99.42 49.50' RIGHT	5/8" REBAR SET AT GRADE
2483	N 876396.73 E 1485536.22	303+99.42 49.50' LEFT	5/8" REBAR SET AT GRADE

MONUMENT DETAIL TABLE			
MON. NO.	COORDINATE	STATION	DESCRIPTION
706	N 876195.56 E 1485612.56	301+84.23 49.42' LEFT	5/8" REBAR FOUND 0.1' BELOW GRADE
705	N 876452.14 E 1485621.83	304+20.89 50.28' RIGHT	5/8" REBAR FOUND 0.3' BELOW GRADE
613	N 876509.02 E 1485493.58	305+19.53 49.57' LEFT	5/8" REBAR FOUND 0.1' BELOW GRADE

NATHAN P. NADEAU, LS

I CERTIFY THAT THIS IS A CORRECT SURVEY TO THE BEST OF MY KNOWLEDGE BASED UPON AN EDM TOTAL STATION AND GPS FIELD SURVEY AND TOWN OF SAINT ALBANS, TOWN OF SWANTON AND REFERENCED LAND AND HIGHWAY RECORDS. THIS PLAT MEETS THE REQUIREMENTS OF 27 VSA SECTION 1403.

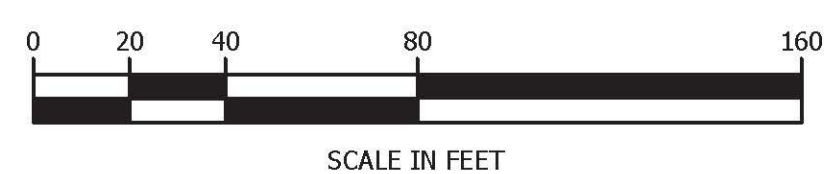

© 2017  
horizons  
Engineering  
All rights reserved

HORIZONS ENGINEERING INC. CERTIFIES THAT THIS DRAWING WAS PRODUCED AS AN ORIGINAL INK ON MYLAR SIGNATURE