

SWANTON VILLAGE
BOOK 133, PAGES 94-95

N 75°09'00" W
342.62'

N 73°40'15" W
377.36'

5 6

N 73°41'10" W
371.72'

752.53'
N 68°21'00" W

GERMAIN BOURDEAU
BOOK 125, PAGES 147-148

GERMAIN BOURDEAU
BOOK 125, PAGES 147-148

horizons
Engineering Inc.

17 Sunset Terrace
Newport, Vermont 05855
Phone 802.334.6434 - Fax 802.334.5602

STATUTORY SURVEY PREPARED FOR


**VERMONT AGENCY
OF TRANSPORTATION**

1 NATIONAL LIFE DRIVE
MONTPELIER, VT 05633-5001


OF U.S. ROUTE 7
TOWN OF ST. ALBANS, TOWN OF SWANTON
FRANKLIN COUNTY, VERMONT

NATHAN P. NADEAU, LS

I CERTIFY THAT THIS IS A CORRECT SURVEY TO THE BEST OF MY KNOWLEDGE BASED UPON AN EDM TOTAL STATION AND GPS FIELD SURVEY AND TOWN OF SAINT ALBANS, TOWN OF SWANTON AND REFERENCED LAND AND HIGHWAY RECORDS. THIS PLAT MEETS THE REQUIREMENTS OF 27 VSA SECTION 1403.

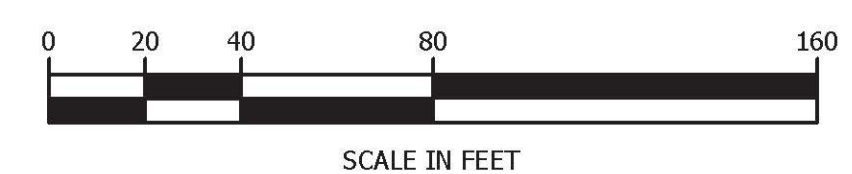

© 2017
horizons
Engineering
All rights reserved

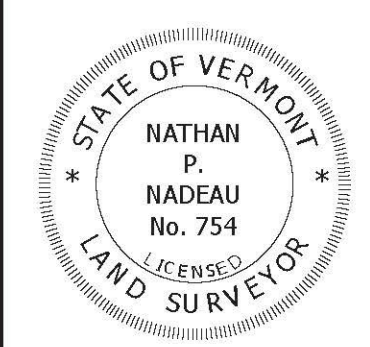

DATE:	PROJECT #:
1/12/2017	15522
SURV'D BY:	DRAWN BY:
JN, AN, JB	JN, NN
CHECK'D BY:	SCALE:
AN	1"=40'

SHEET 40 OF 43

MONUMENT DETAIL TABLE

MON. NO.	COORDINATE	STATION	DESCRIPTION
1863	N 878904.09 E 1484204.69	332+83.67 83.27' RIGHT	FENO TYPE MONUMENT SET AT GRADE
2490	N 878778.22 E 1484081.29	333+61.51 74.83' LEFT	FENO TYPE MONUMENT SET AT GRADE
2491	N 878884.31 E 1483719.15	337+38.87 74.74' LEFT	5/8" REBAR SET 0.7' ABOVE GRADE
1864	N 879181.73 E 1483505.24	340+37.36 140.84' RIGHT	5/8" REBAR SET AT GRADE
2612	N 878972.13 E 1483387.97	340+74.61 96.45' LEFT	5/8" REBAR SET 0.2' ABOVE GRADE

HORIZONS ENGINEERING INC. CERTIFIES THAT THIS DRAWING WAS PRODUCED AS AN ORIGINAL INK ON MYLAR
 SIGNATURE