

PIN ID# 16x605

**horizons**  
Engineering Inc.

17 Sunset Terrace  
Newport, Vermont 05855  
Phone 802.334.6434 - Fax 802.334.5602

STATUTORY SURVEY PREPARED FOR


**VERMONT AGENCY OF TRANSPORTATION**

1 NATIONAL LIFE DRIVE  
MONTPELIER, VT 05633-5001

OF U.S. ROUTE 7  
TOWN OF ST. ALBANS, TOWN OF SWANTON  
FRANKLIN COUNTY, VERMONT


DATE:	PROJECT #:
1/12/2017	15522
SURV'D BY:	DRAWN BY:
JN, AN, JB	JN, NN
CHECK'D BY:	SCALE:
AN	1"=40'
SHEET 43 OF 43	

MONUMENT DETAIL TABLE			
MON. NO.	COORDINATE	STATION	DESCRIPTION
70	N 879845.33 E 1481877.56	358+06.12 49.50' LEFT	5/8" REBAR SET AT GRADE
2613	N 880060.92 E 1481711.41	360+59.66 49.50' RIGHT	FENO TYPE MONUMENT SET AT GRADE
69	N 880113.15 E 1481624.66	361+60.92 49.50' RIGHT	SPIKE SET
71	N 880028.34 E 1481573.60	361+60.92 49.50' LEFT	SPIKE SET

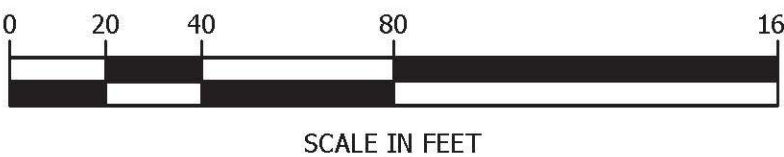

NATHAN P. NADEAU, LS

I CERTIFY THAT THIS IS A CORRECT SURVEY TO THE BEST OF MY KNOWLEDGE BASED UPON AN EDM TOTAL STATION AND GPS FIELD SURVEY AND TOWN OF SAINT ALBANS, TOWN OF SWANTON AND REFERENCED LAND AND HIGHWAY RECORDS. THIS PLAT MEETS THE REQUIREMENTS OF 27 VSA SECTION 1403.

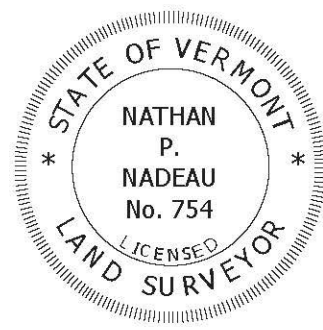

HORIZONS ENGINEERING INC. CERTIFIES THAT THIS DRAWING WAS PRODUCED AS AN ORIGINAL INK ON MYLAR SIGNATURE