


PLAN  
 NOTE BOOK  
 No.

PROFILE  
 NOTE BOOK  
 No.

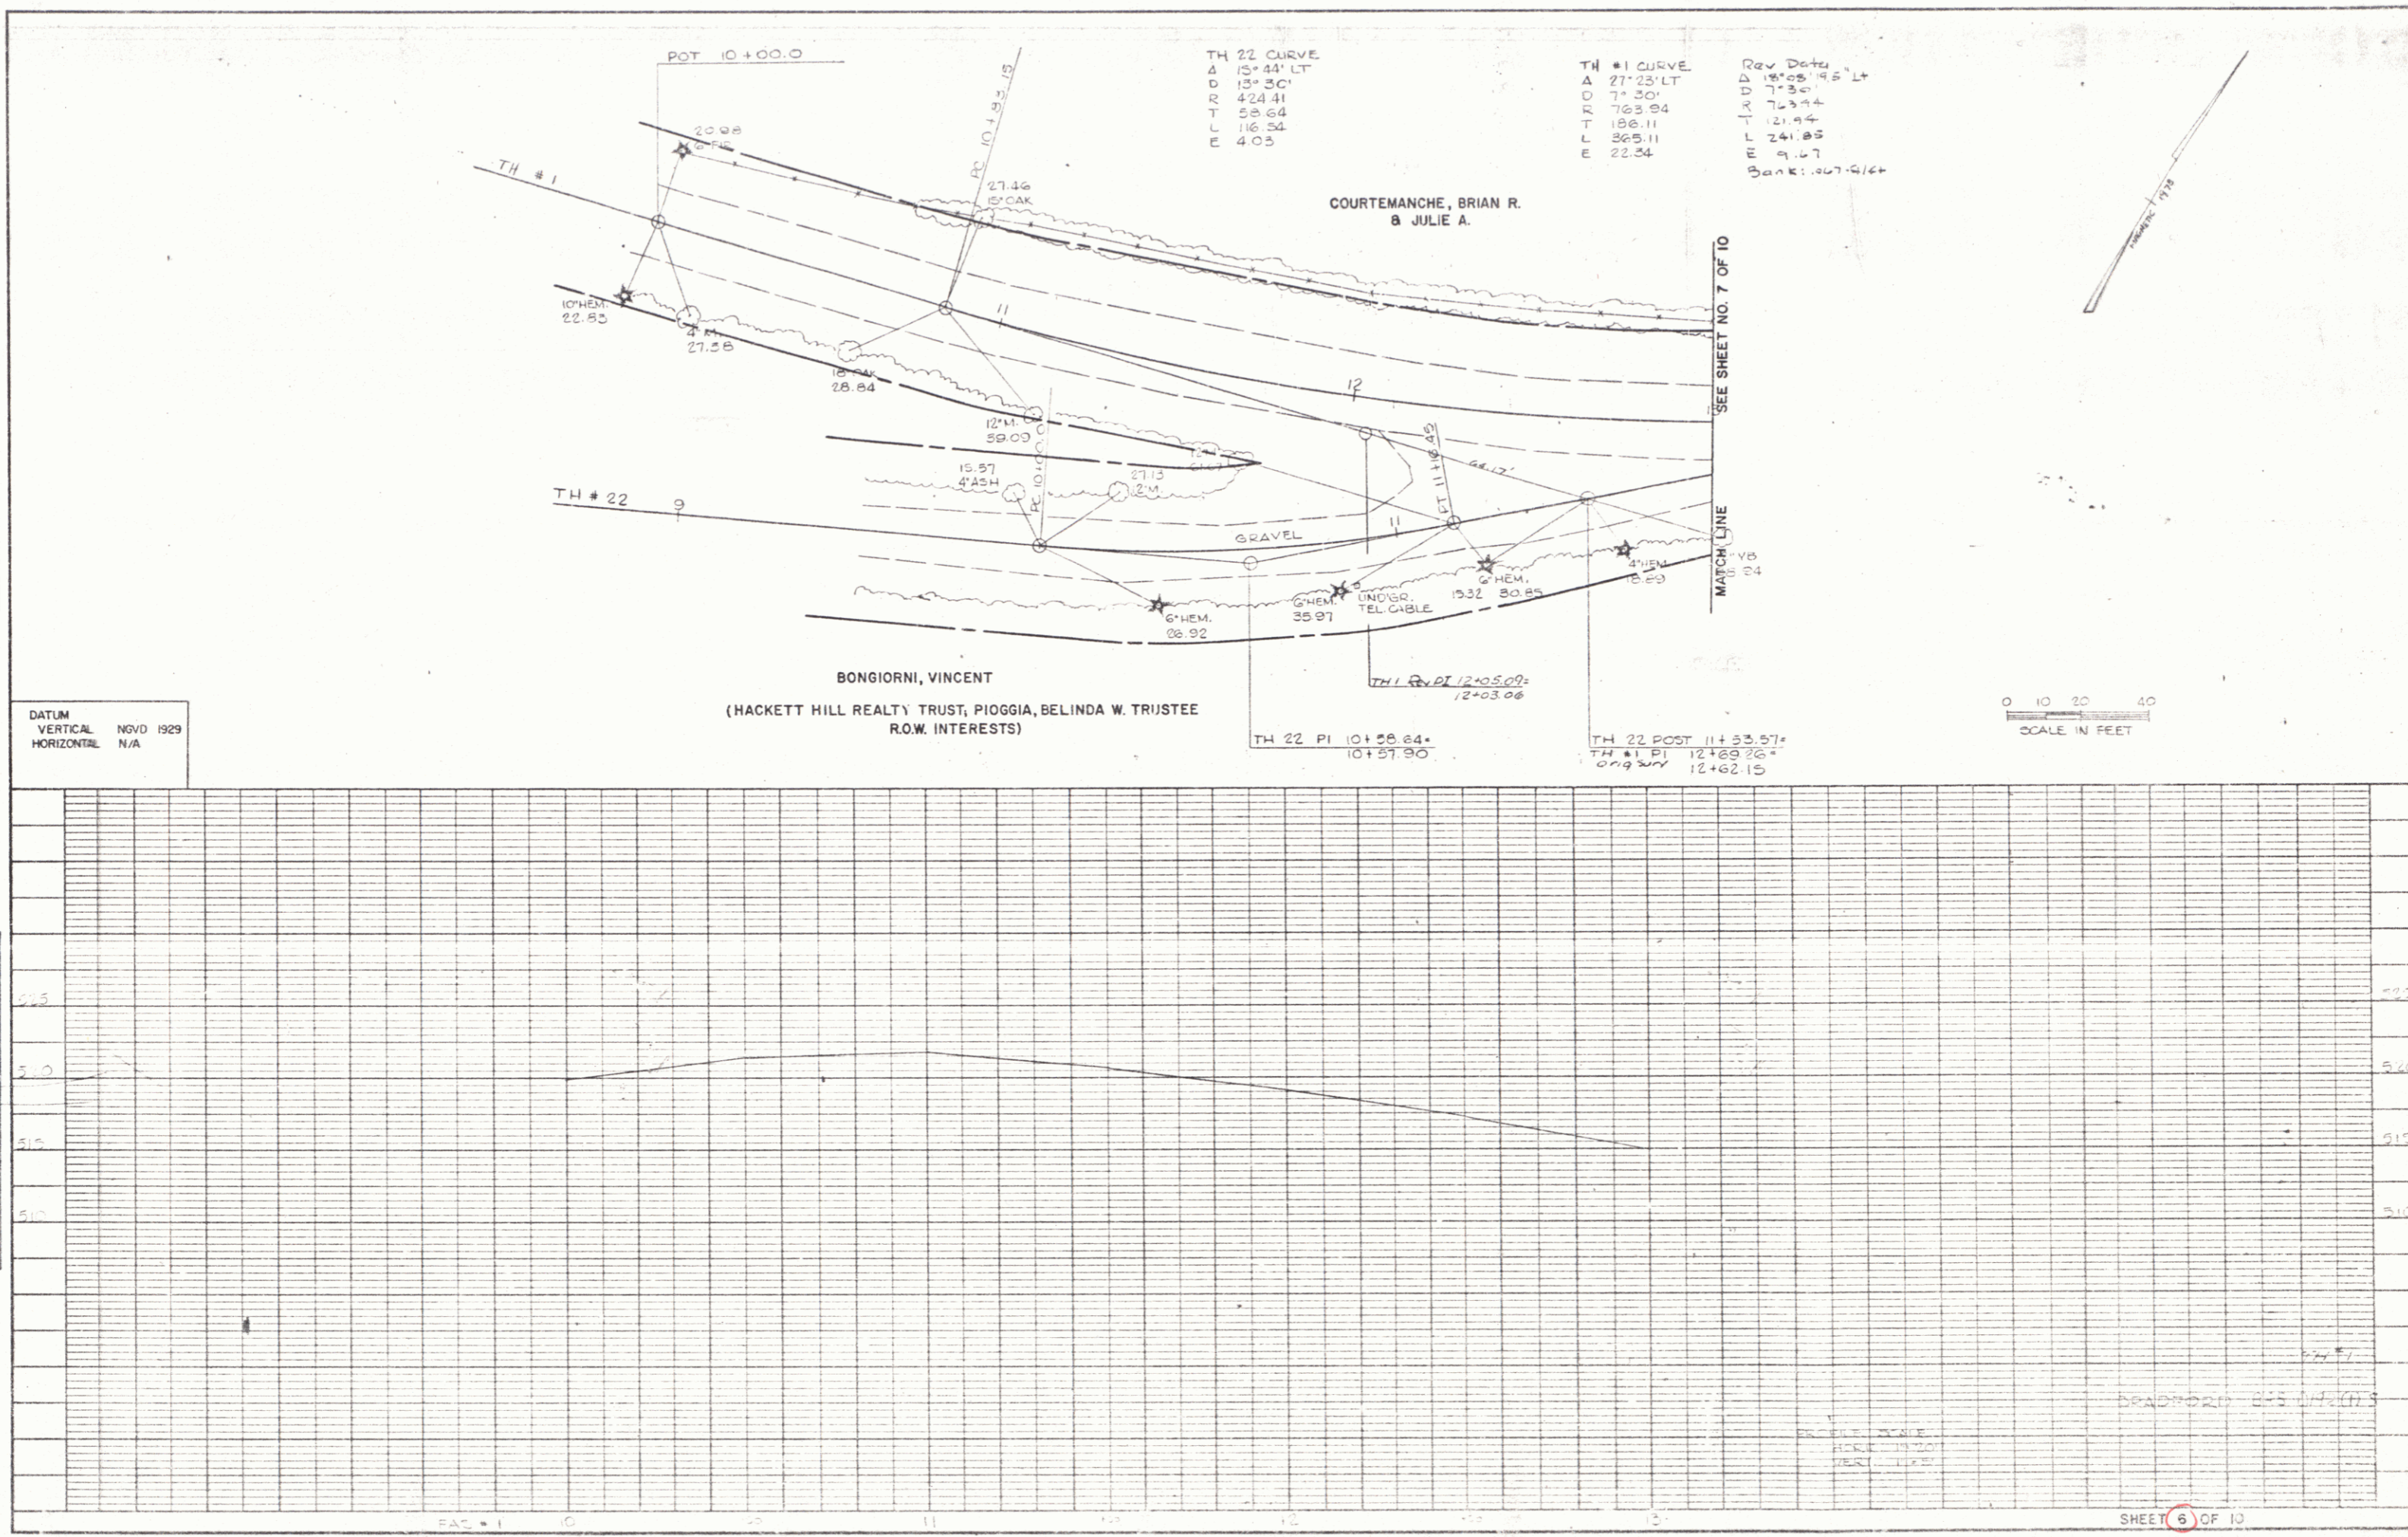

TH #22 CURVE  
 Δ 15°44' LT  
 D 13°30'  
 R 424.41  
 T 58.64  
 L 116.54  
 E 4.05

TH #1 CURVE  
 Δ 27°23' LT  
 D 7°30'  
 R 763.94  
 T 186.11  
 L 365.11  
 E 22.34

Rev Data  
 15.05.95 Lt  
 7.30.95 Lt  
 7.30.94  
 21.96  
 241.85  
 9.67  
 Bank: 207-6/24

DATUM  
 VERTICAL NGVD 1929  
 HORIZONTAL N/A

TH #22 PI 10+58.84+  
 10+57.90

TH #1 POST 11+53.57+  
 TH #1 PI 12+69.26+  
 0.19 207  
 12+62.15

0 10 20 40  
 SCALE IN FEET

SHEET 6 OF 10

K-E PLATE 1, PLAN/PROFILE  
 SCALE 1"=40'