



DATE: 2/24/87
 DRAWN BY: [Signature]
 CHECKED BY: [Signature]
 PLAN
 DATE: [Signature]
 CHECKED BY: [Signature]

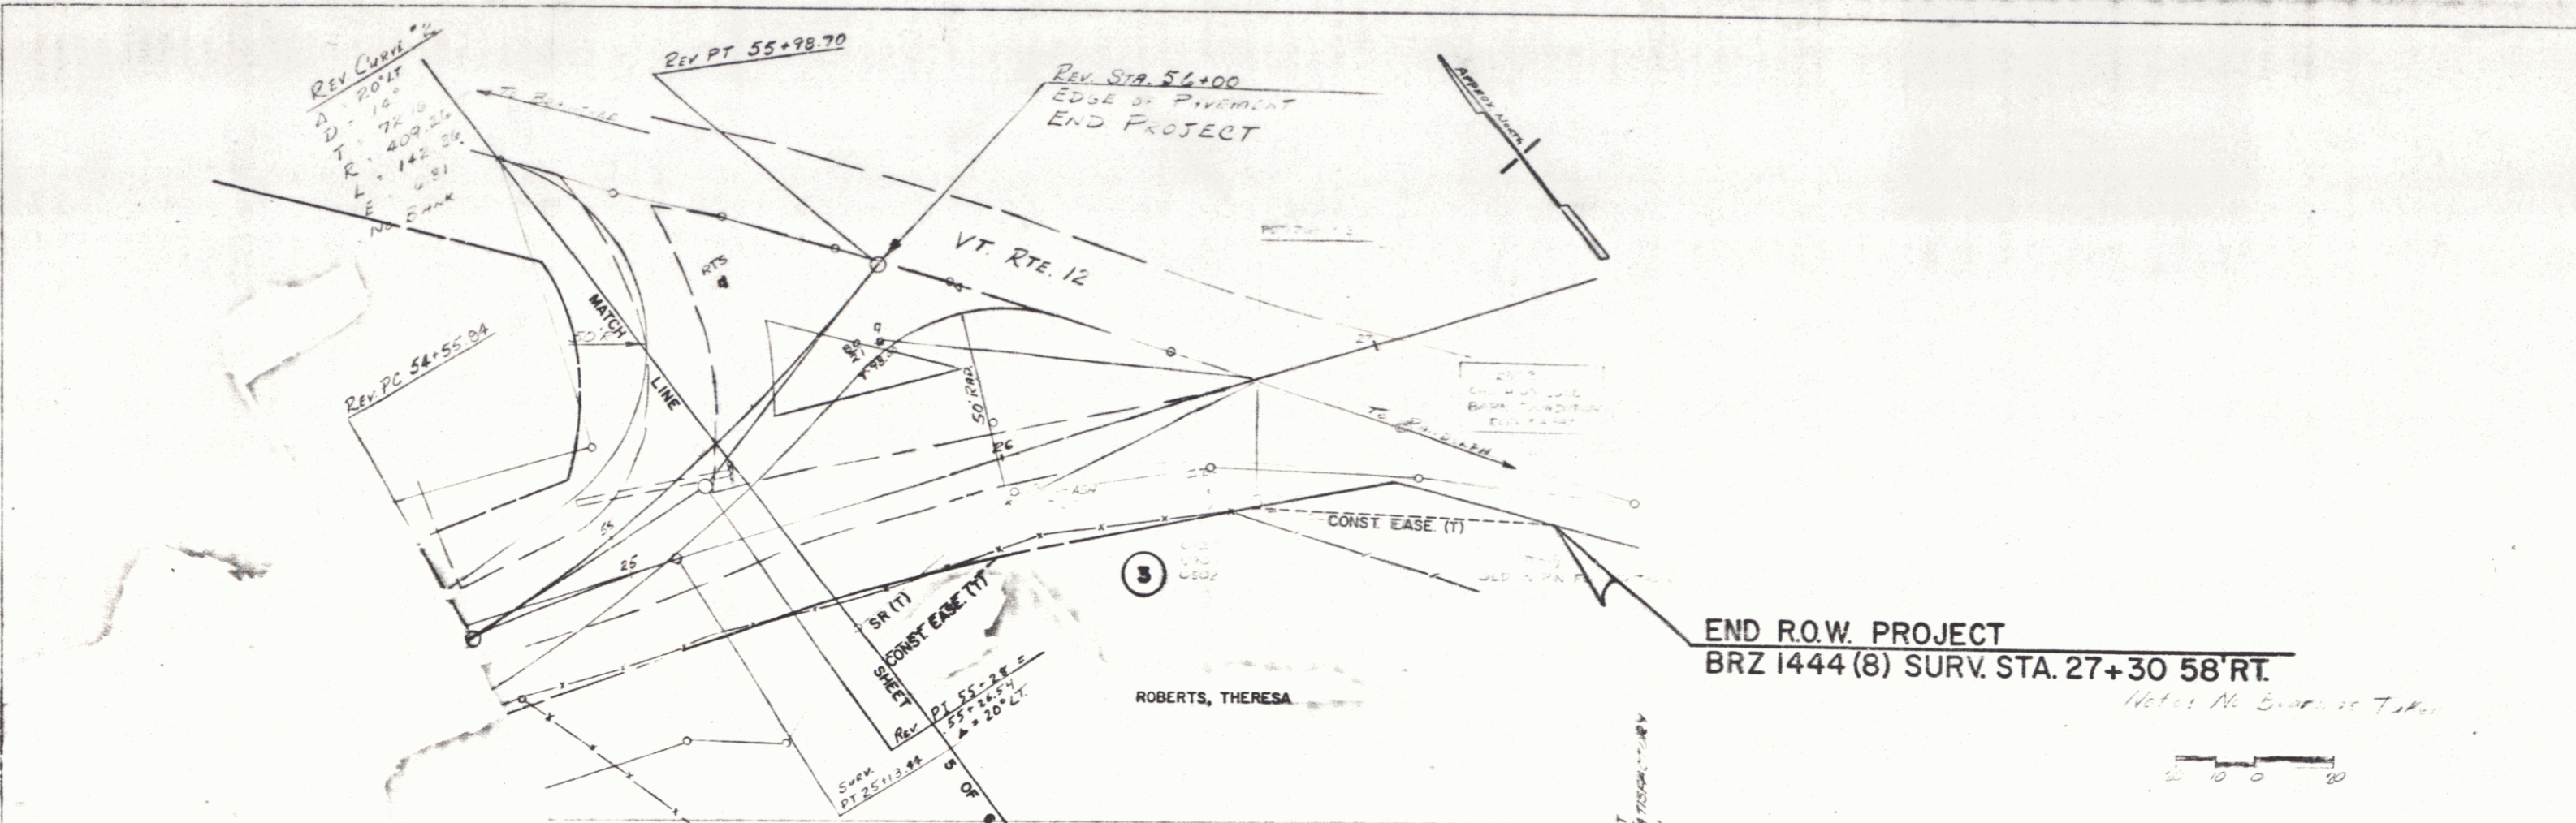

END R.O.W. PROJECT
 BRZ 1444 (8) SURV. STA. 27+30 58' RT.

PROFILE
 DATE: [Signature]
 CHECKED BY: [Signature]

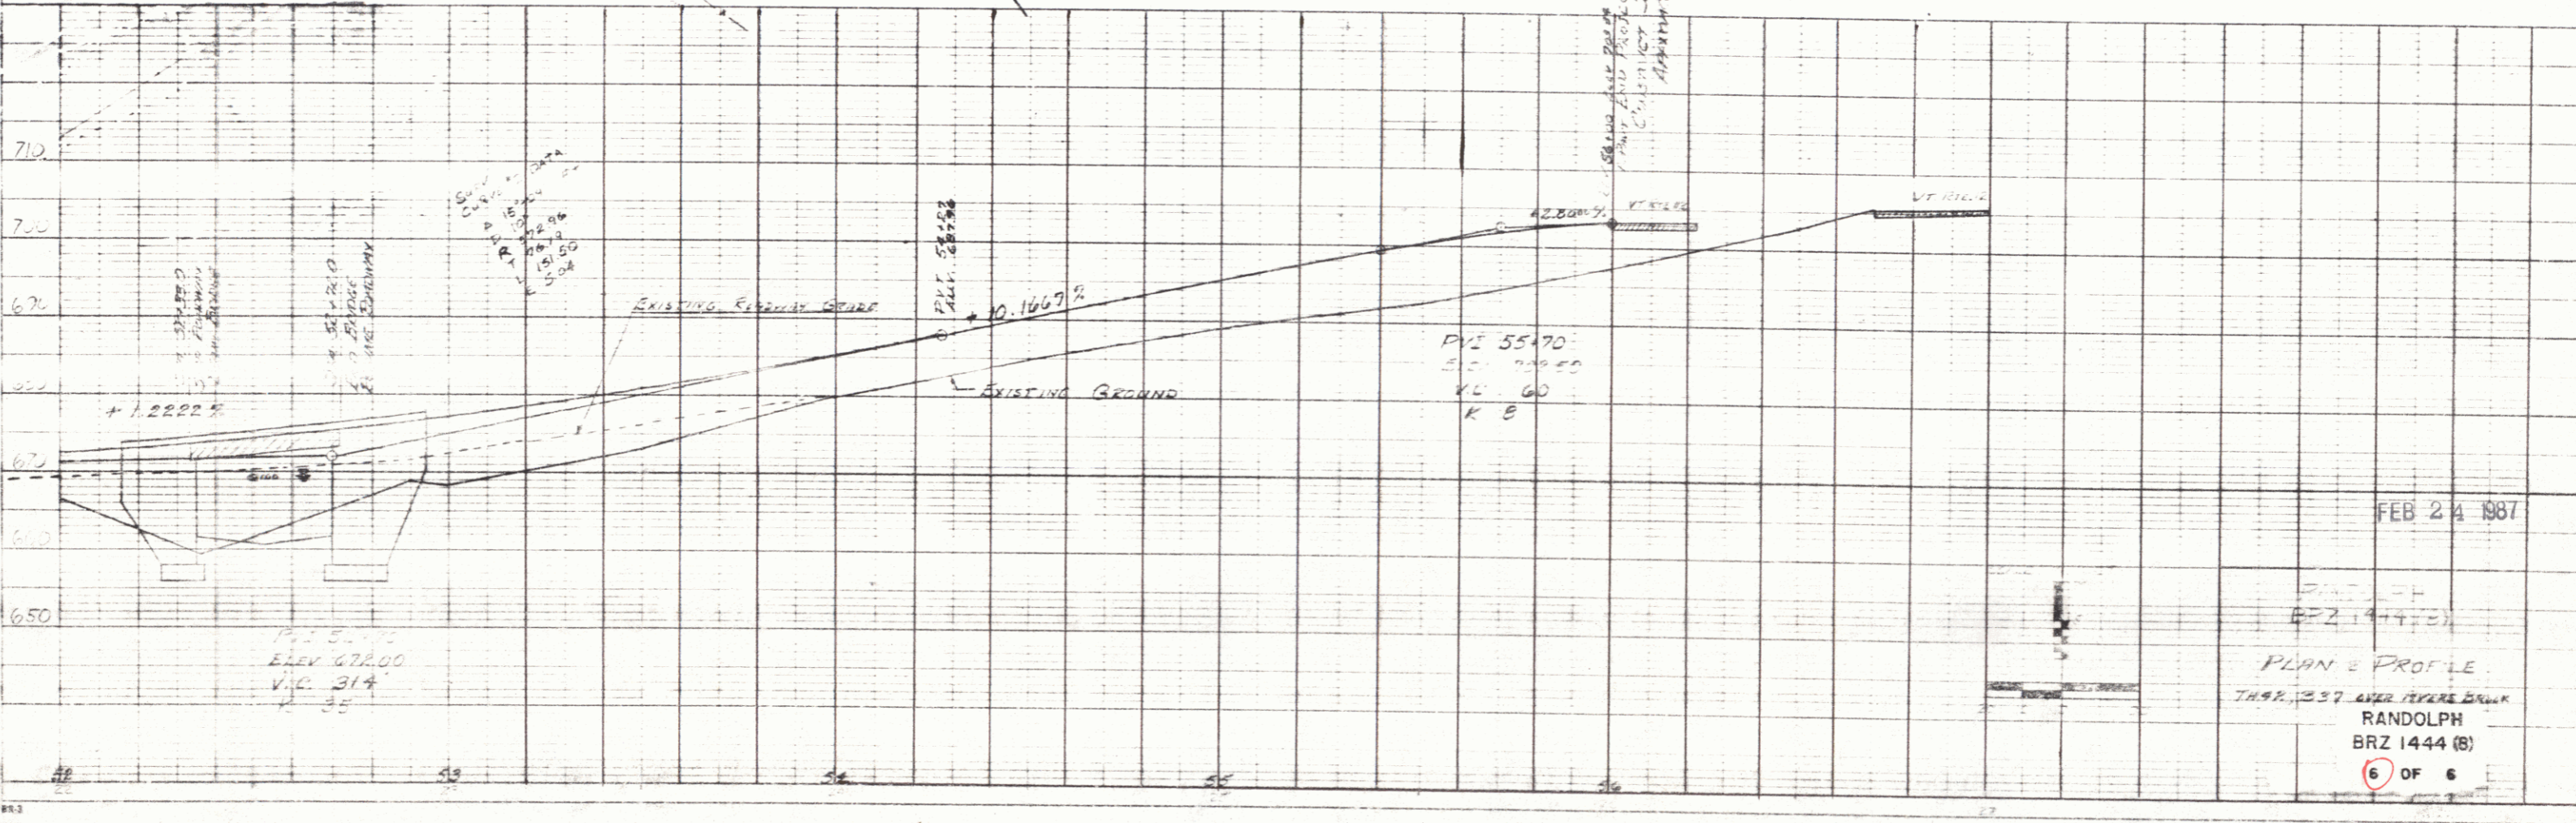

FEB 24 1987

PLAN & PROFILE
 RANDOLPH
 BRZ 1444 (8)
 6 OF 6