
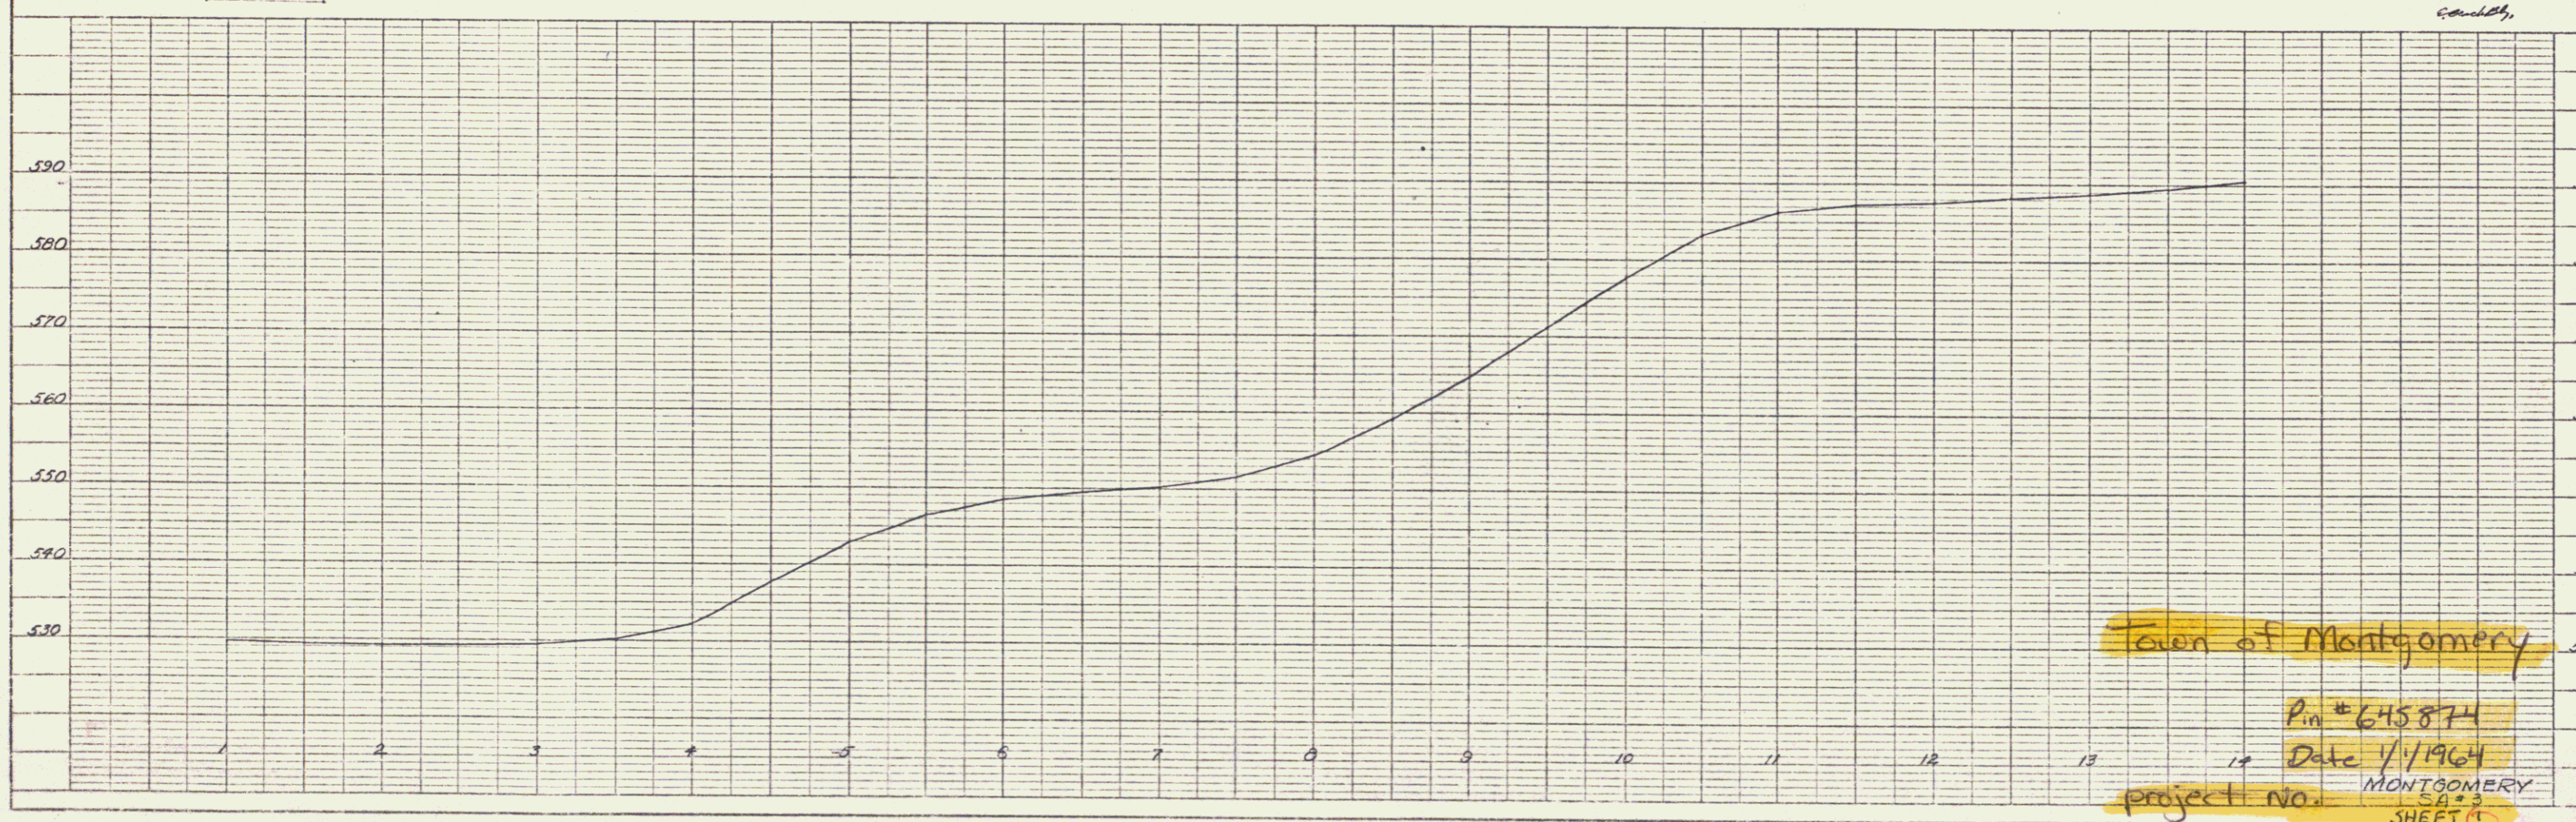


PLAN
 DRAWN BY: [Signature]
 CHECKED BY: [Signature]
 DATE: 1/1/64
 SHEET NO. 1

PROFILE
 DRAWN BY: [Signature]
 CHECKED BY: [Signature]
 DATE: 1/1/64
 SHEET NO. 1

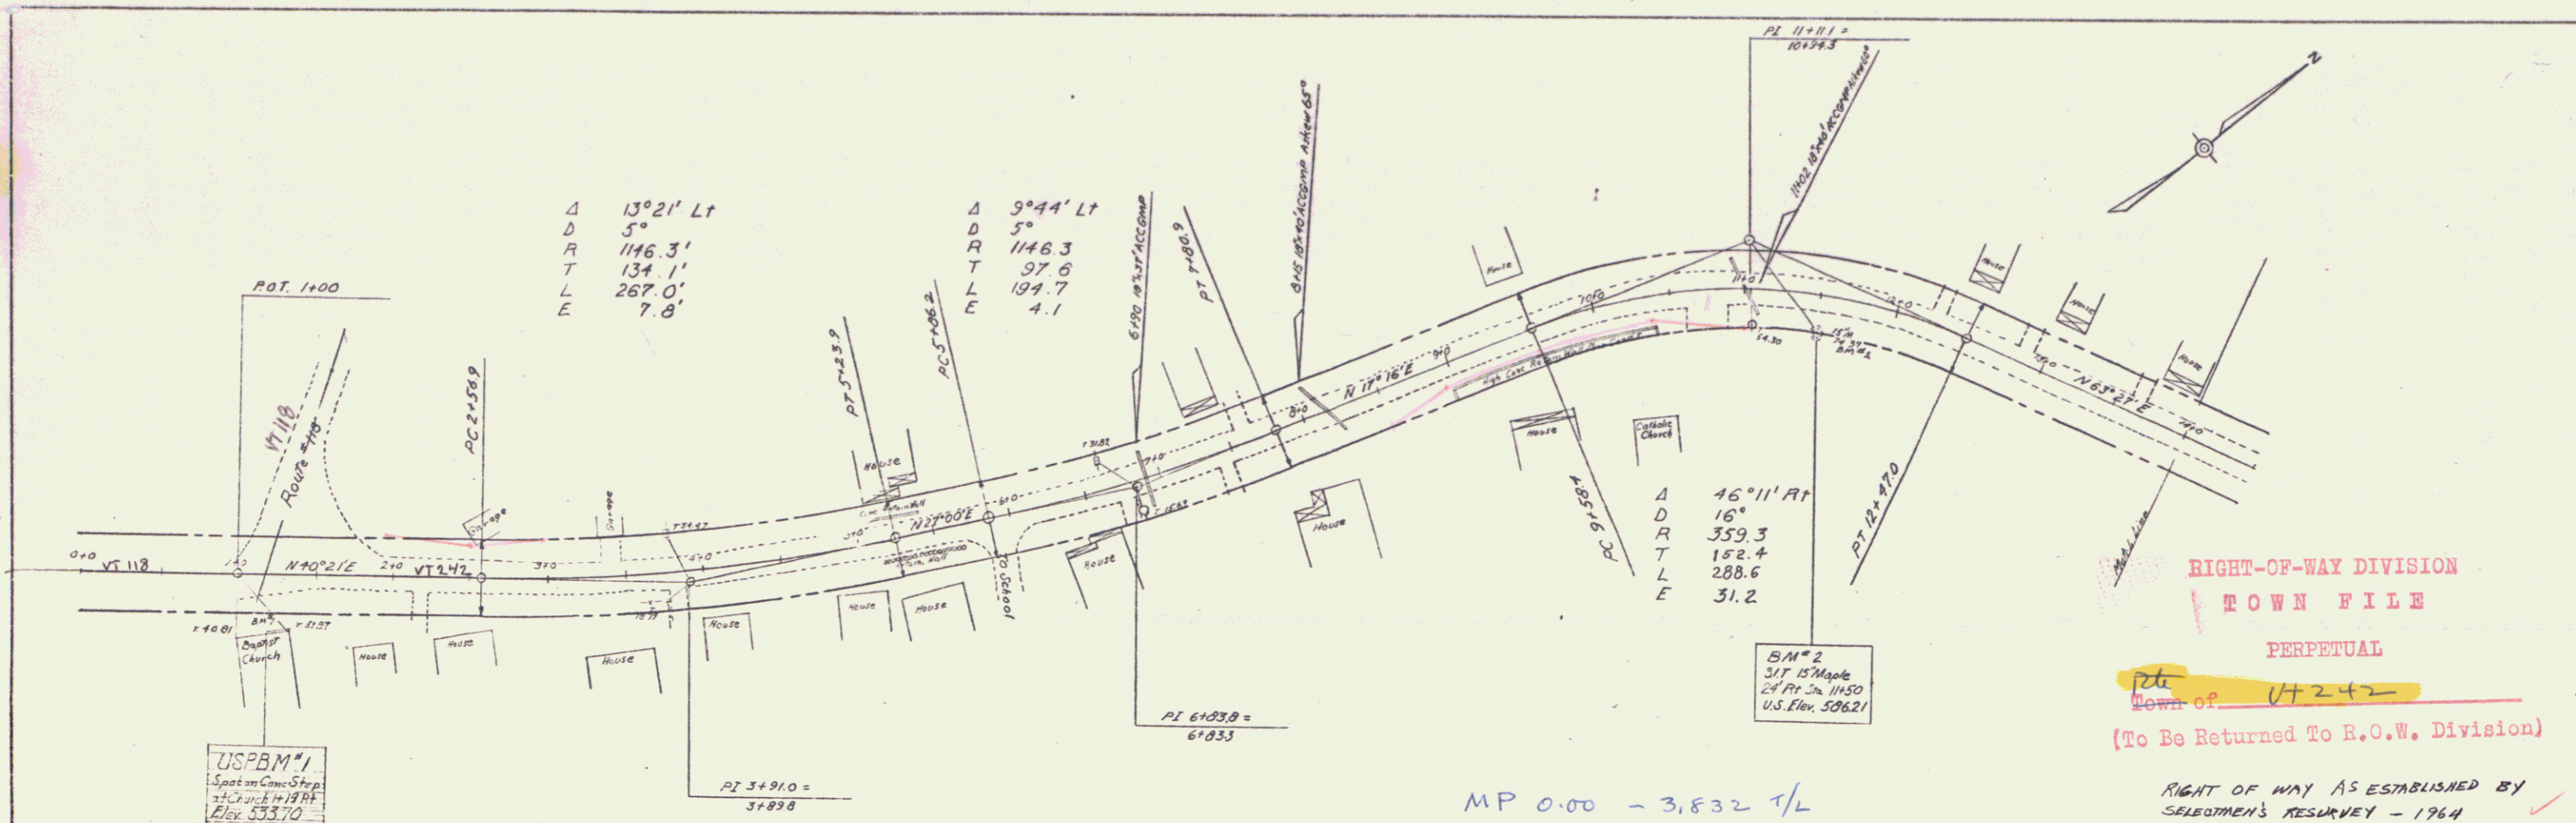

Town of Montgomery
 Pin # 645874
 Date 1/1/64
 project no. MONTGOMERY
 SA # 3
 SHEET C
 VT # 242 1