

PLAN
 DATE: 1/21/54
 DRAWN BY: J. J. [unclear]
 CHECKED BY: [unclear]
 PROJECT: [unclear]
 SHEET NO.: 3

PROFILE
 DATE: 1/21/54
 DRAWN BY: J. J. [unclear]
 CHECKED BY: [unclear]
 PROJECT: [unclear]
 SHEET NO.: 3

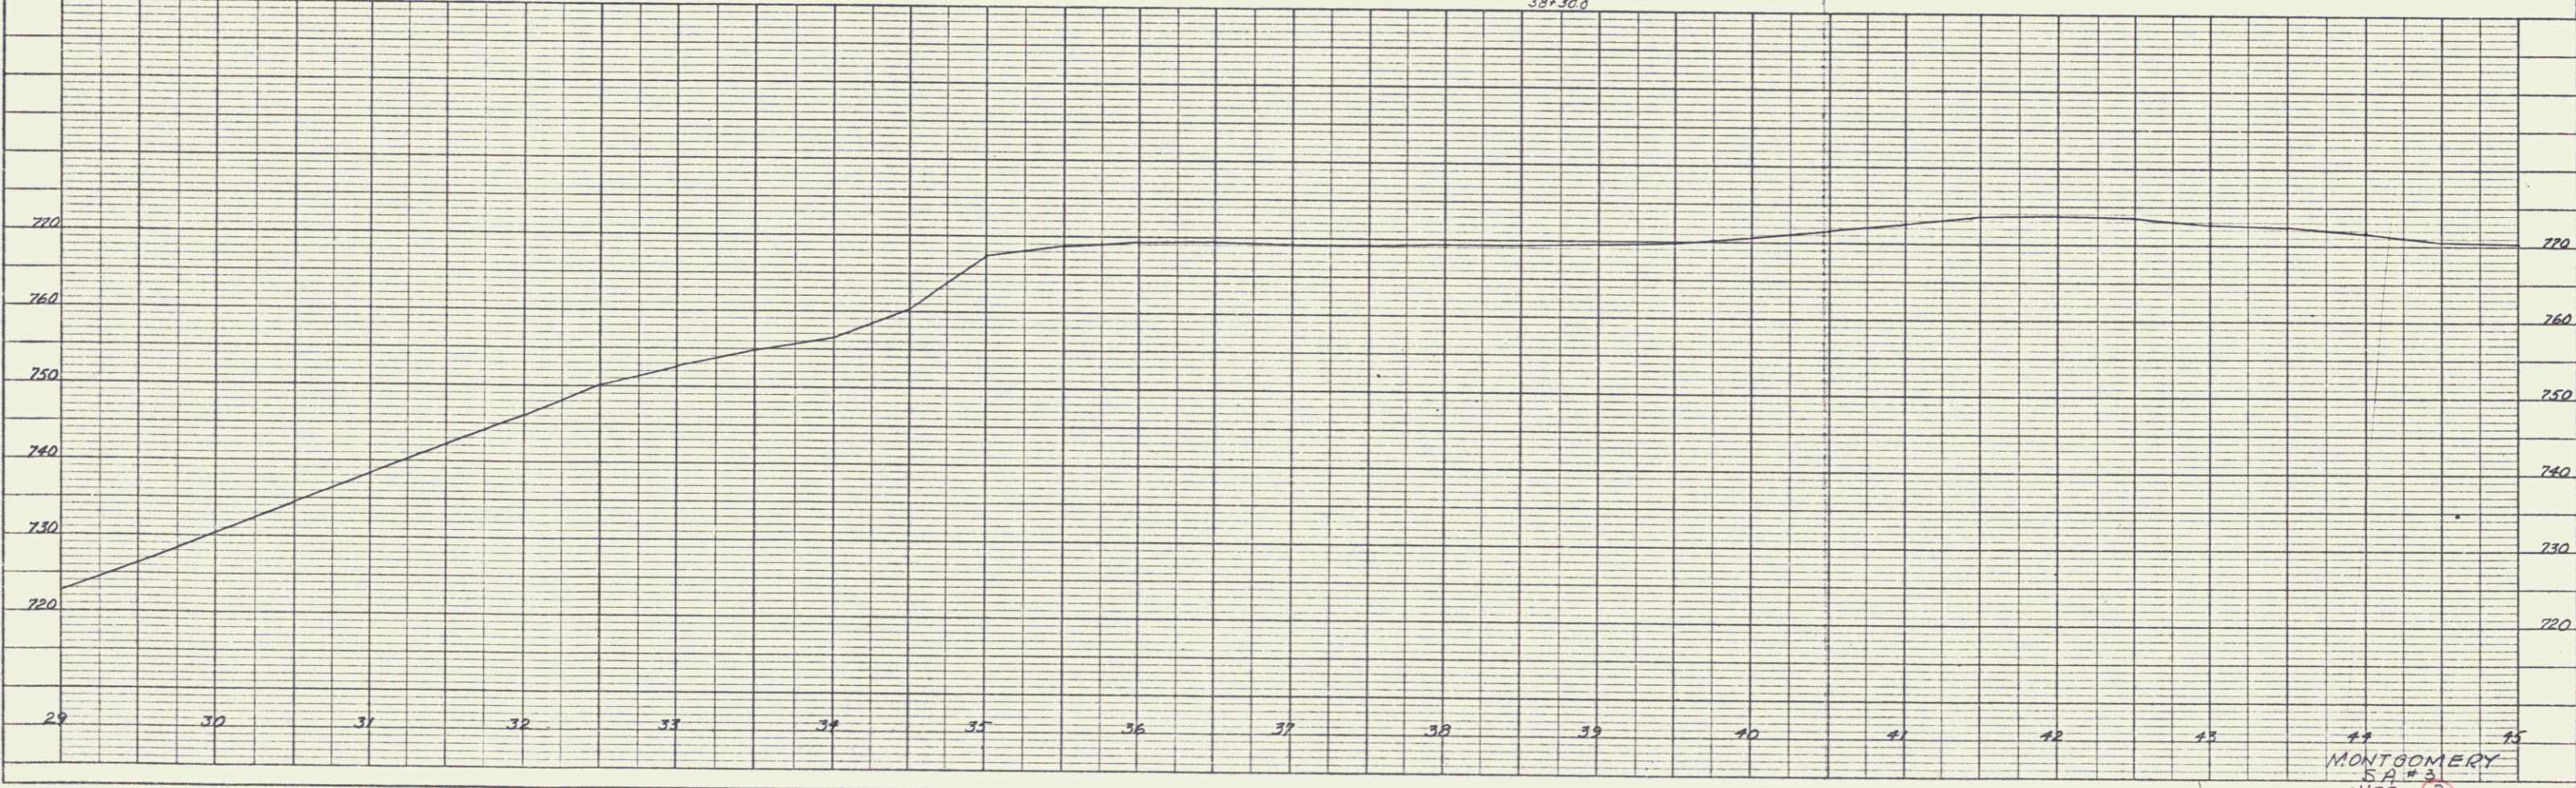
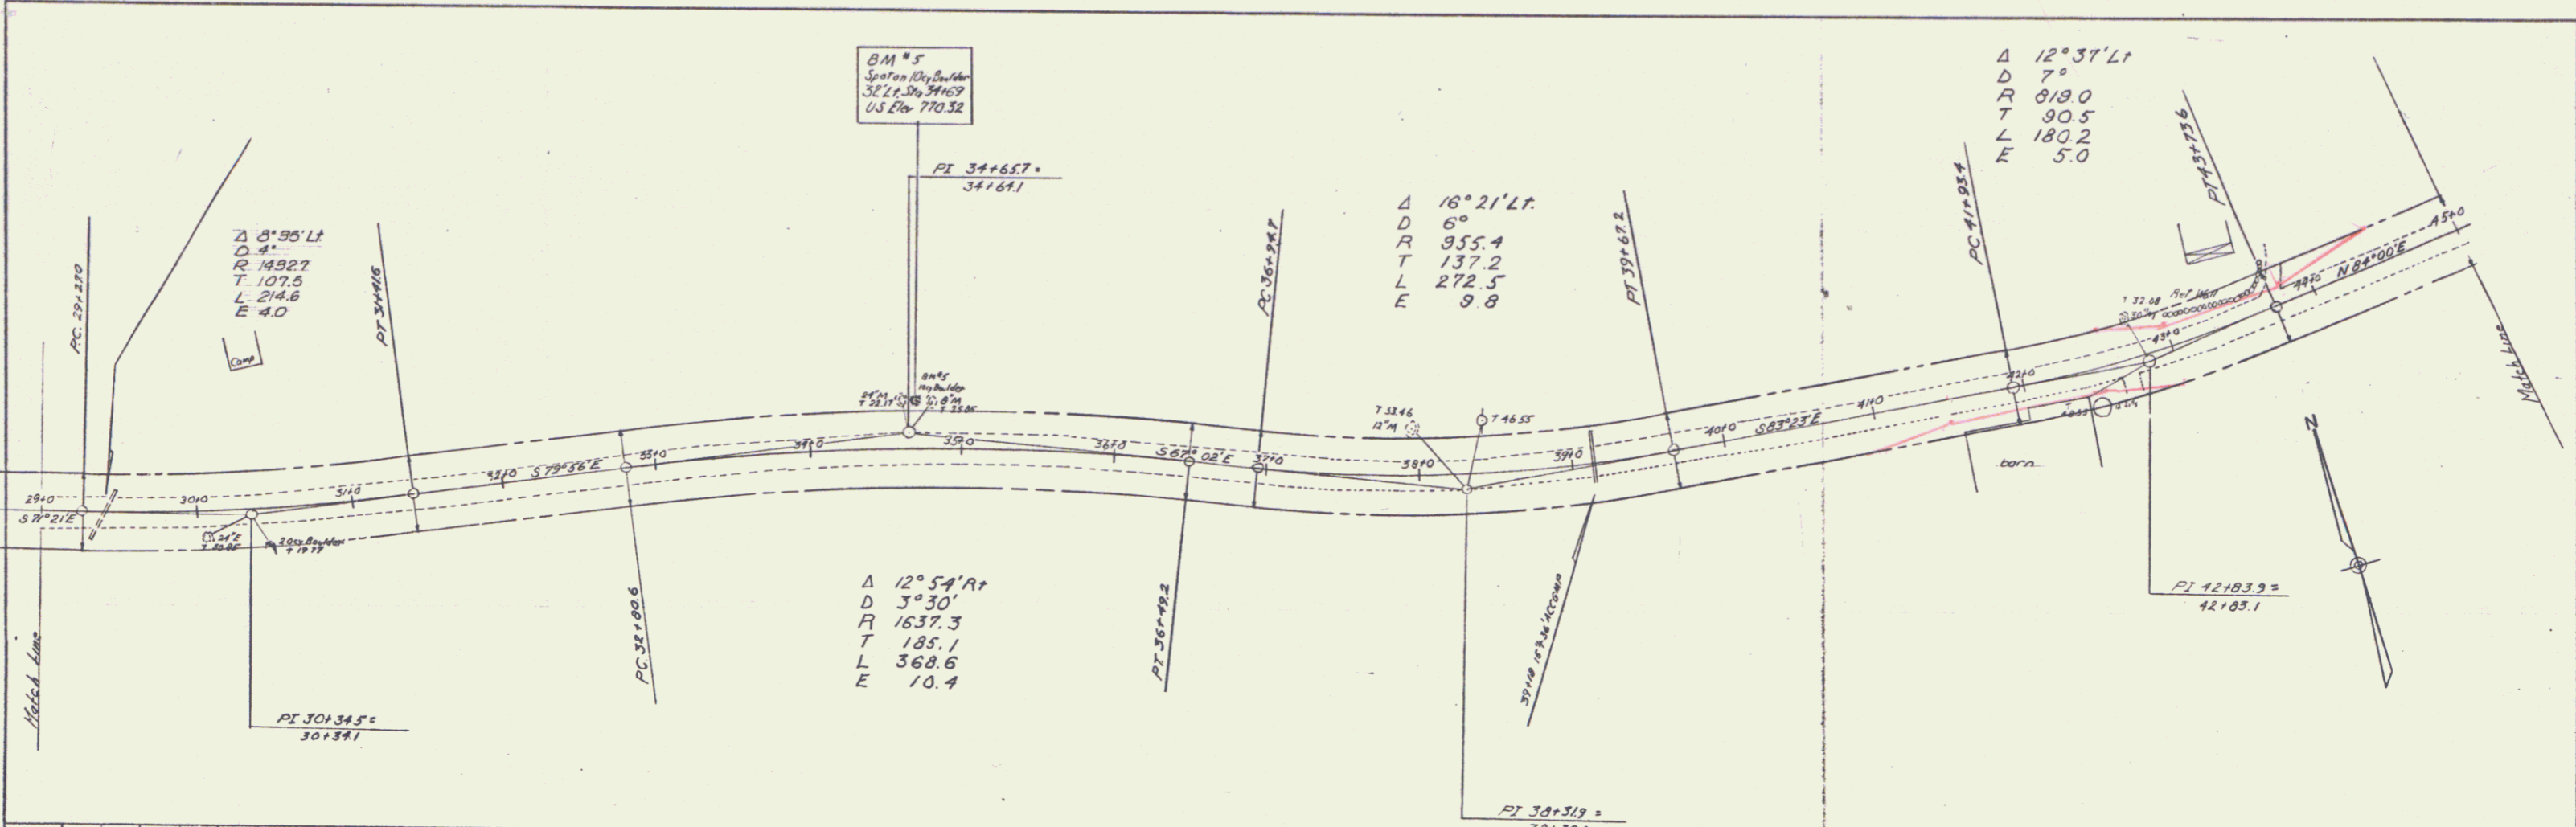


PLATE 1 - PLAN - PROFILE - O. P. & A. E. STANDARD
 KUMPF & ESSLE CO. NEW YORK
 A & E CO. NO. 348-108

MONTGOMERY
 SA # 3
 SHEET 3