

PLAN  
 DRAWN BY: S. Murphy  
 CHECKED BY: S. Murphy  
 DATE: 5/14

PROFILE  
 DRAWN BY: S. Murphy  
 CHECKED BY: S. Murphy  
 DATE: 5/14

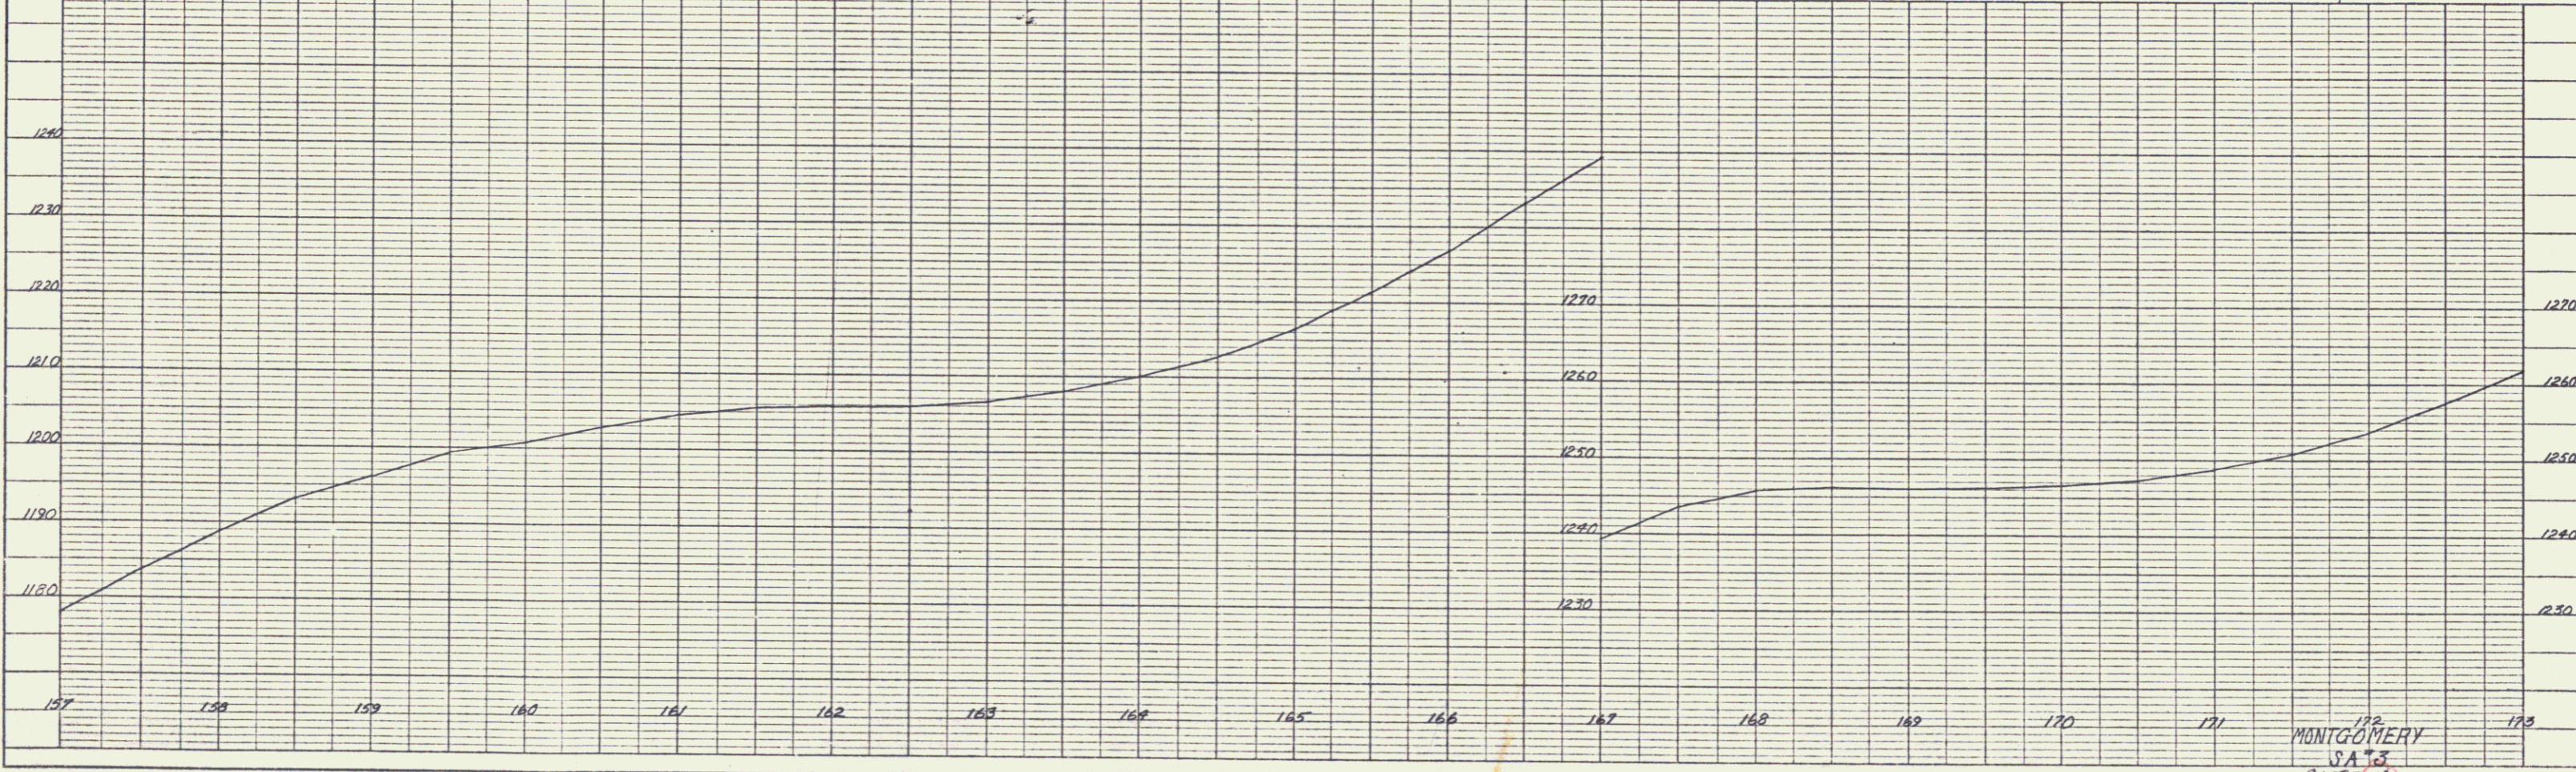
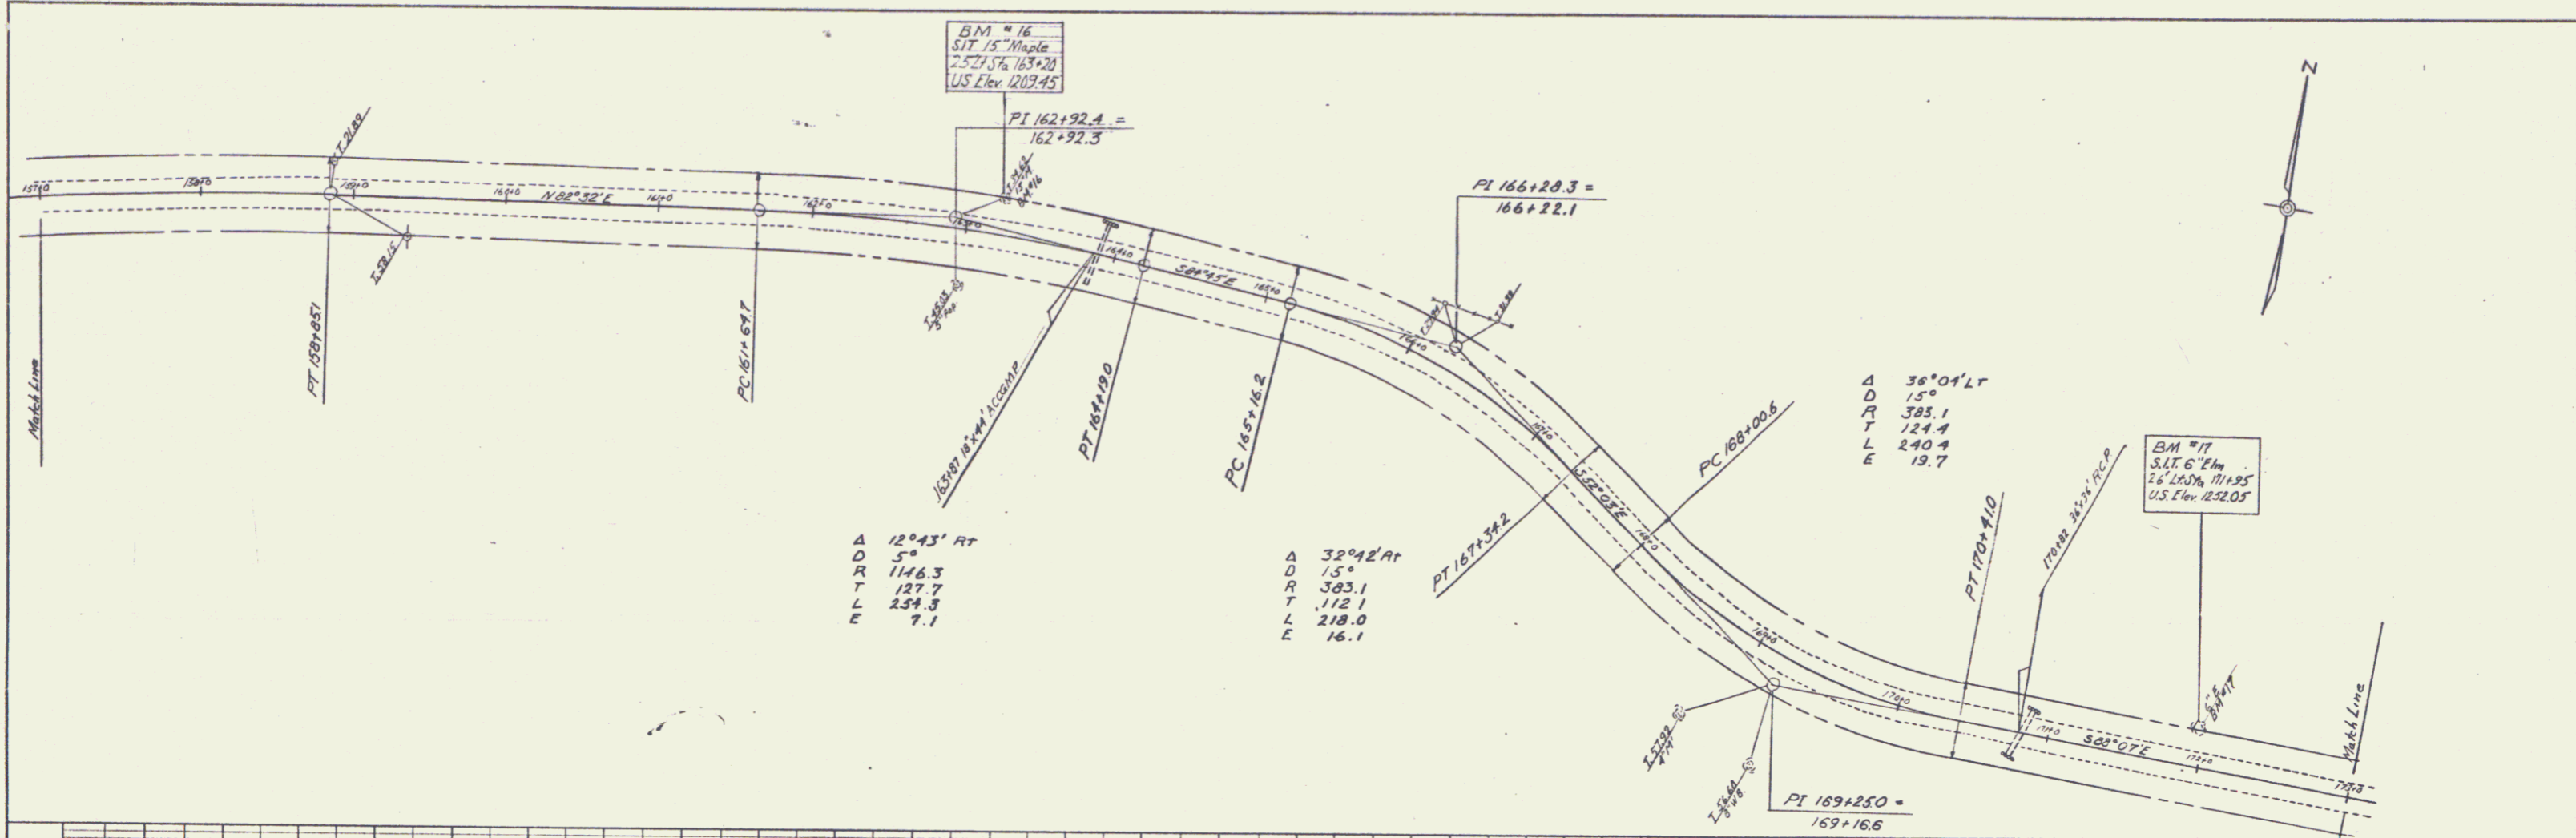


PLATE 1 - PLAN, PROFILE, G.P.A.R. & STANDARD  
 KEMPFL & ESSER CO., NEW YORK

122  
 MONTGOMERY  
 S.A. 73  
 SHEET 12