

PLAN
 DRAWN BY SPALDING
 CHECKED Z. LANE
 DATE 1/14
 NO. 1
 S. MURRAY

PROFILE
 DRAWN BY SPALDING
 CHECKED Z. LANE
 DATE 1/14
 NO. 1

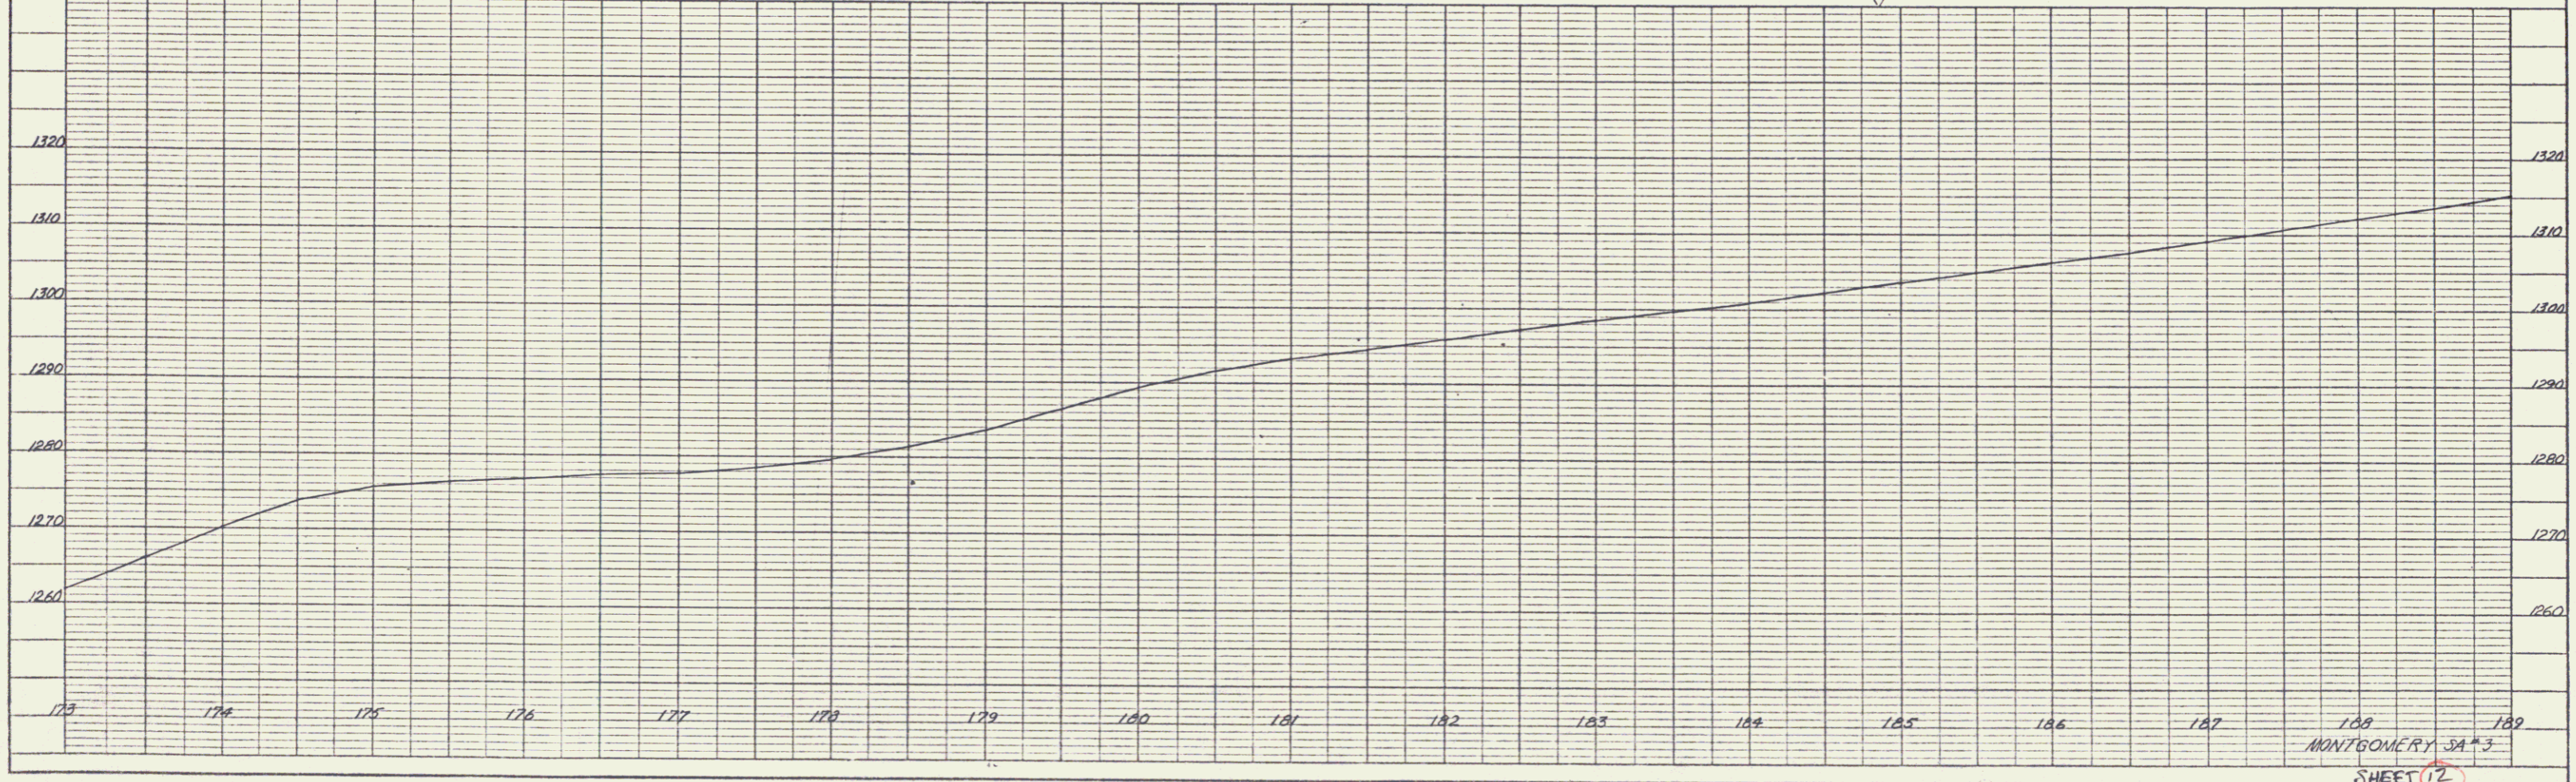
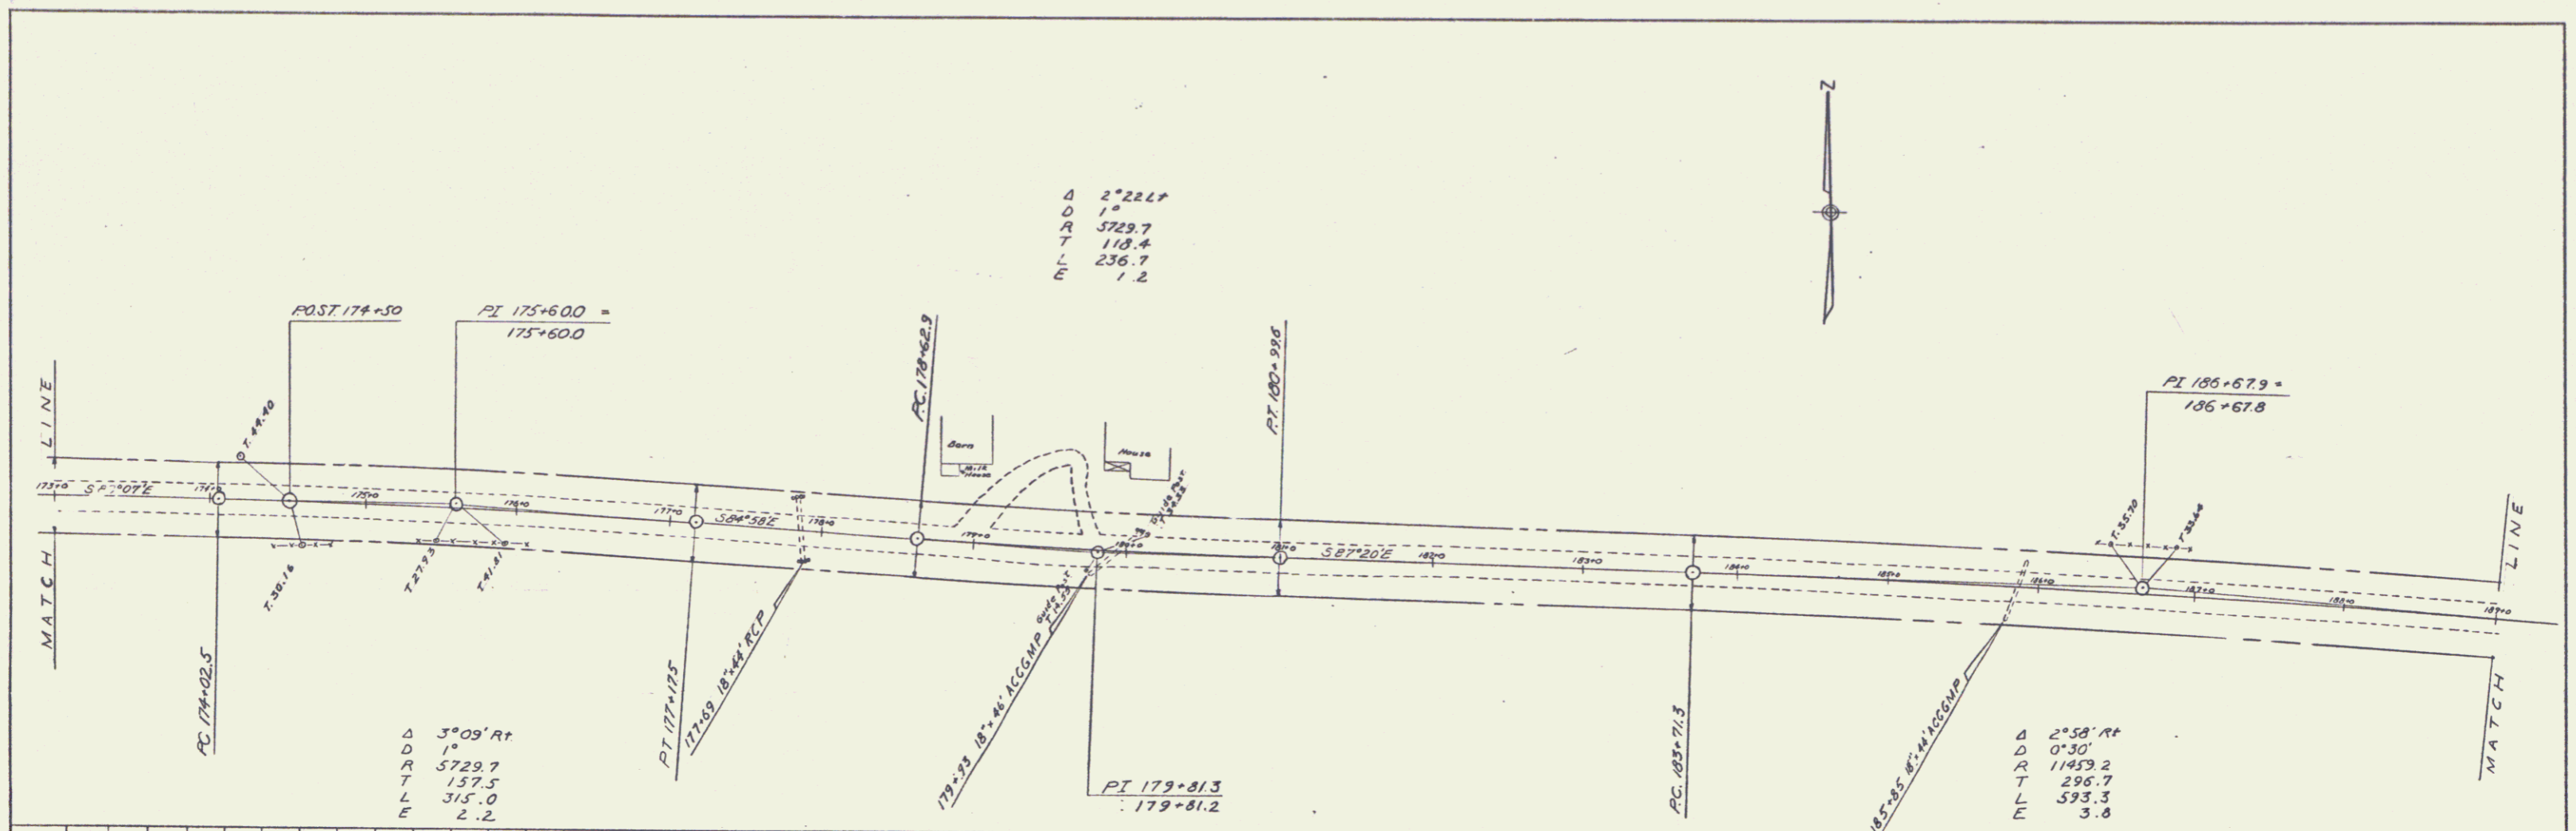


PLATE 1. PLAN, PROFILE, & R.A. & E. STANDARD
 MURPHY & ESSER CO., NEW YORK
 A & E CO. NO. 348-106
 MADE IN U.S.A.

AMMONTGOMERY SA #3
 SHEET 12