

PLAN
 DRAWN BY: *Stanley*
 CHECKED BY: *Conrad*
 DATE: *3/64*
 PROJECT: *109-1695*
 SHEET NO.: *13*

PROFILE
 DRAWN BY: *Stanley*
 CHECKED BY: *Conrad*
 DATE: *3/64*
 PROJECT: *109-1695*
 SHEET NO.: *13*

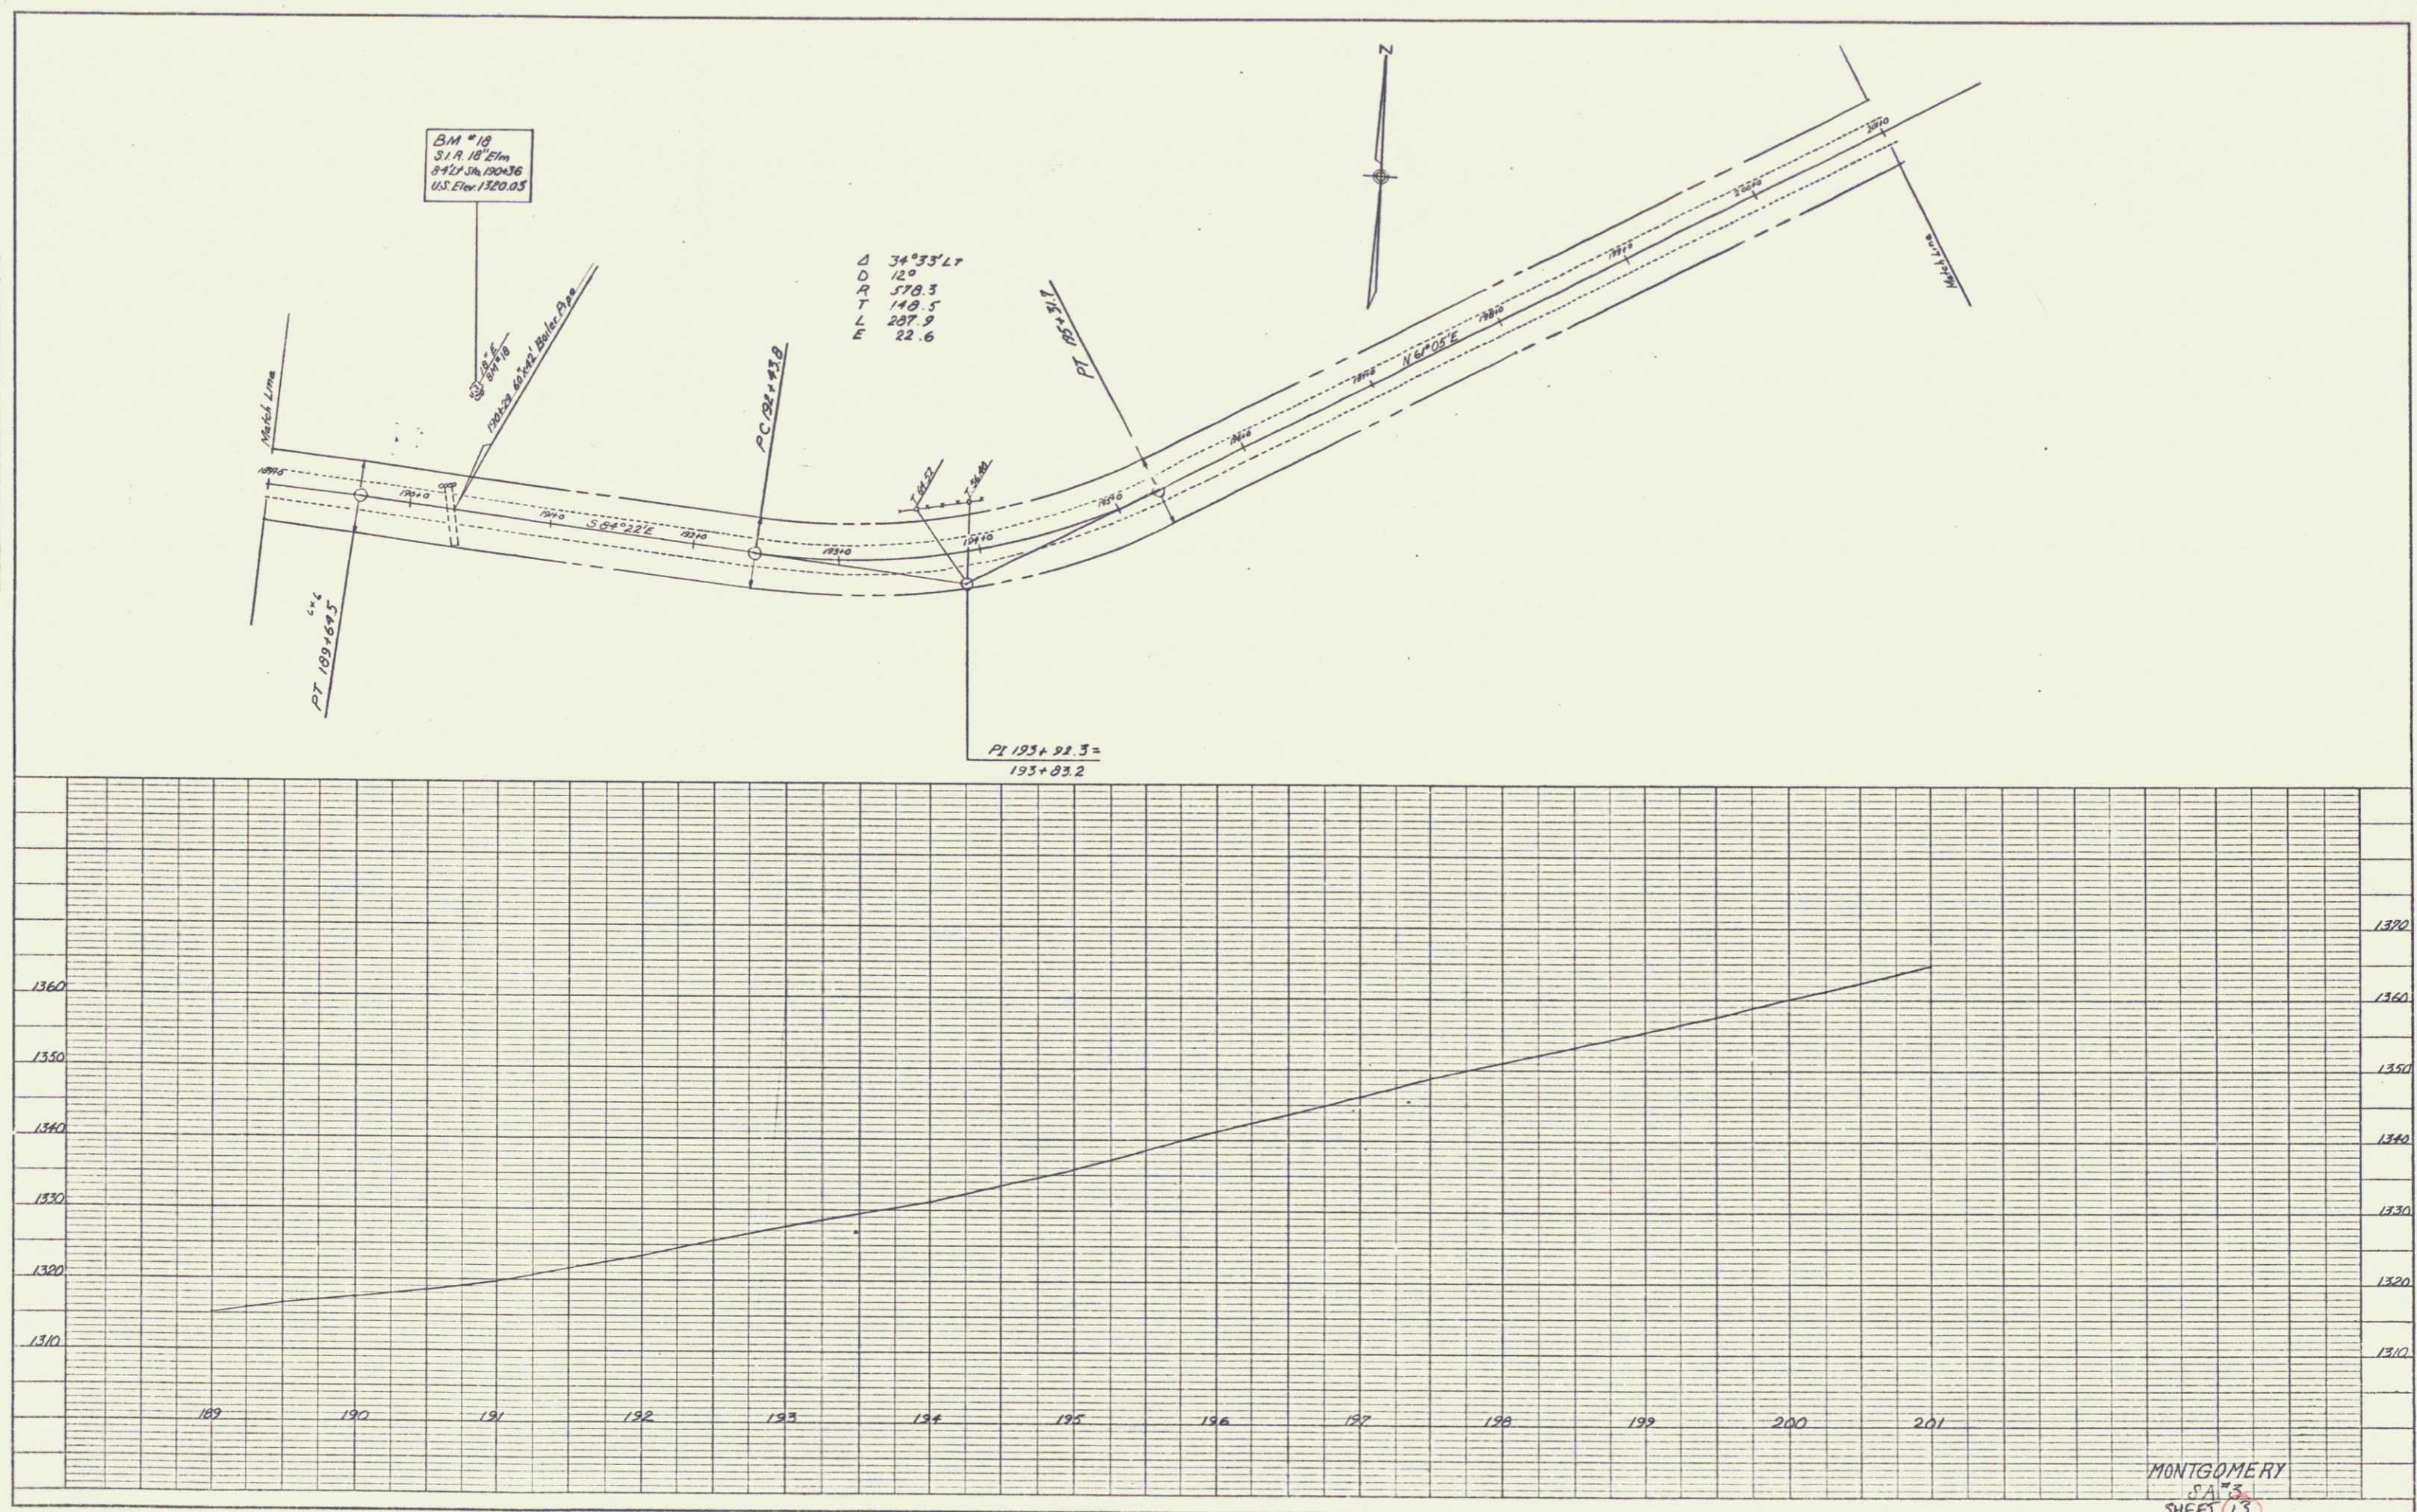


PLATE 1 - PLAN PROFILE - D.P.P. & E. STANDARD
 REYNOLDS & CLARK CO., NEW YORK
 * A.E. Co. No. 326705

MONTGOMERY
 S.A. #3
 SHEET 13