


PLAN
 DRAWN BY: Sponsbury
 DATE: 3/16
 CHECKED BY: Leonard
 NO. 13/16

PROFILE
 DRAWN BY: Sponsbury
 DATE: 3/16
 CHECKED BY: Leonard
 NO. 13/16

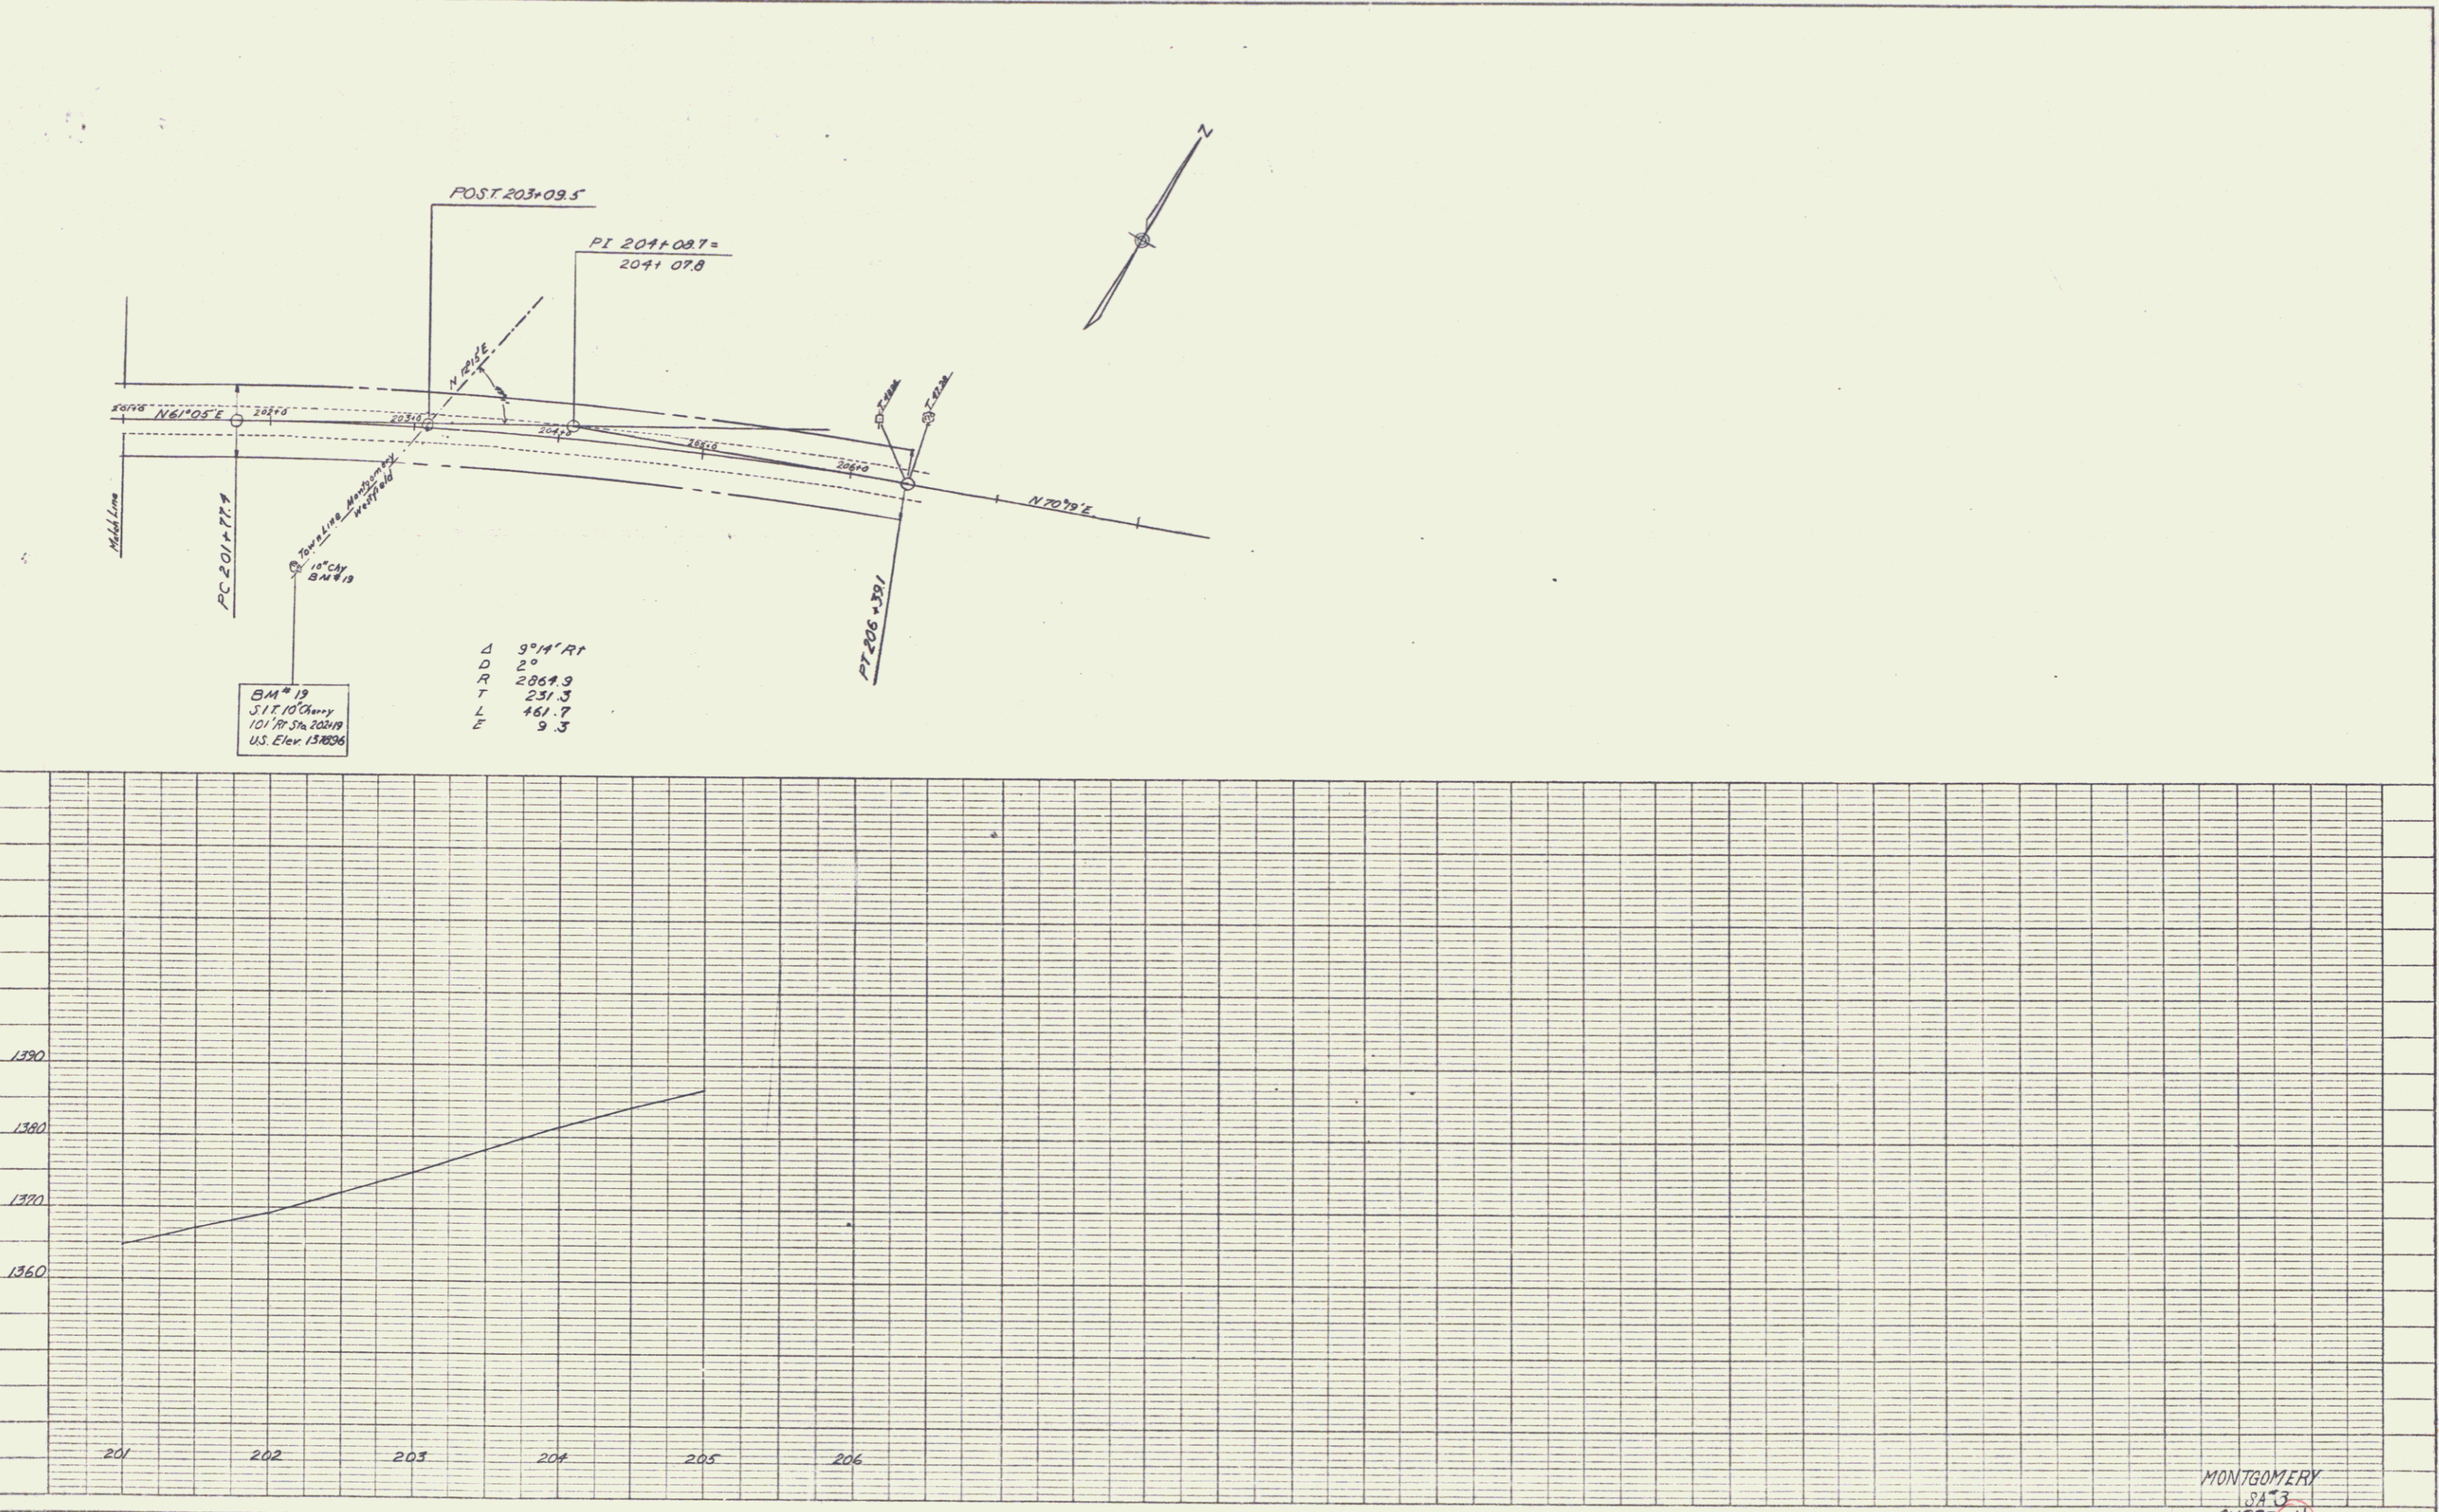

BM # 19
 5 1/2" Oak
 101 7/8" Sh. 20219
 U.S. Elev. 137006

PLATE 1 - PLAN - PROFILE - G. P. & R. E. STANBARD
 KEUFFEL & ESSER CO., NEW YORK
 P. & E. ON THE 240-108

MONTGOMERY
 SA 3
 SHEET 14

14