


THREE CABLE GUARD RAIL W/STEEL POSTS
 NB 417.53-419.00 LT
 A' 200-507 RT
 B' 2025-2015 LT
 C' 2035-2015 RT
 D' 2045-2015 RT
 E' 2055-2015 RT
 F' 2065-2015 RT
 G' 2075-2015 RT
 H' 2085-2015 RT
 I' 2095-2015 RT
 J' 2105-2015 RT
 K' 2115-2015 RT
 L' 2125-2015 RT
 M' 2135-2015 RT
 N' 2145-2015 RT
 O' 2155-2015 RT
 P' 2165-2015 RT
 Q' 2175-2015 RT
 R' 2185-2015 RT
 S' 2195-2015 RT
 T' 2205-2015 RT
 U' 2215-2015 RT
 V' 2225-2015 RT
 W' 2235-2015 RT
 X' 2245-2015 RT
 Y' 2255-2015 RT
 Z' 2265-2015 RT

REMOVAL/DISPOSAL OF PRESENT GUARD RAIL
 VT 18 14100-14745 LT 15 RT
 VT 18 14105-14750 RT
 VT 18 15180-15500 RT
 VT 18 15185-15500 RT

DEMOLITION/DISPOSAL OF BUILDING
 4/3/95 B
 4/3/95 L

DRILLING & BLASTING OF SOLID ROCK SUBGRADE
 SB 406.30-409.00
 NB 407.00-409.00

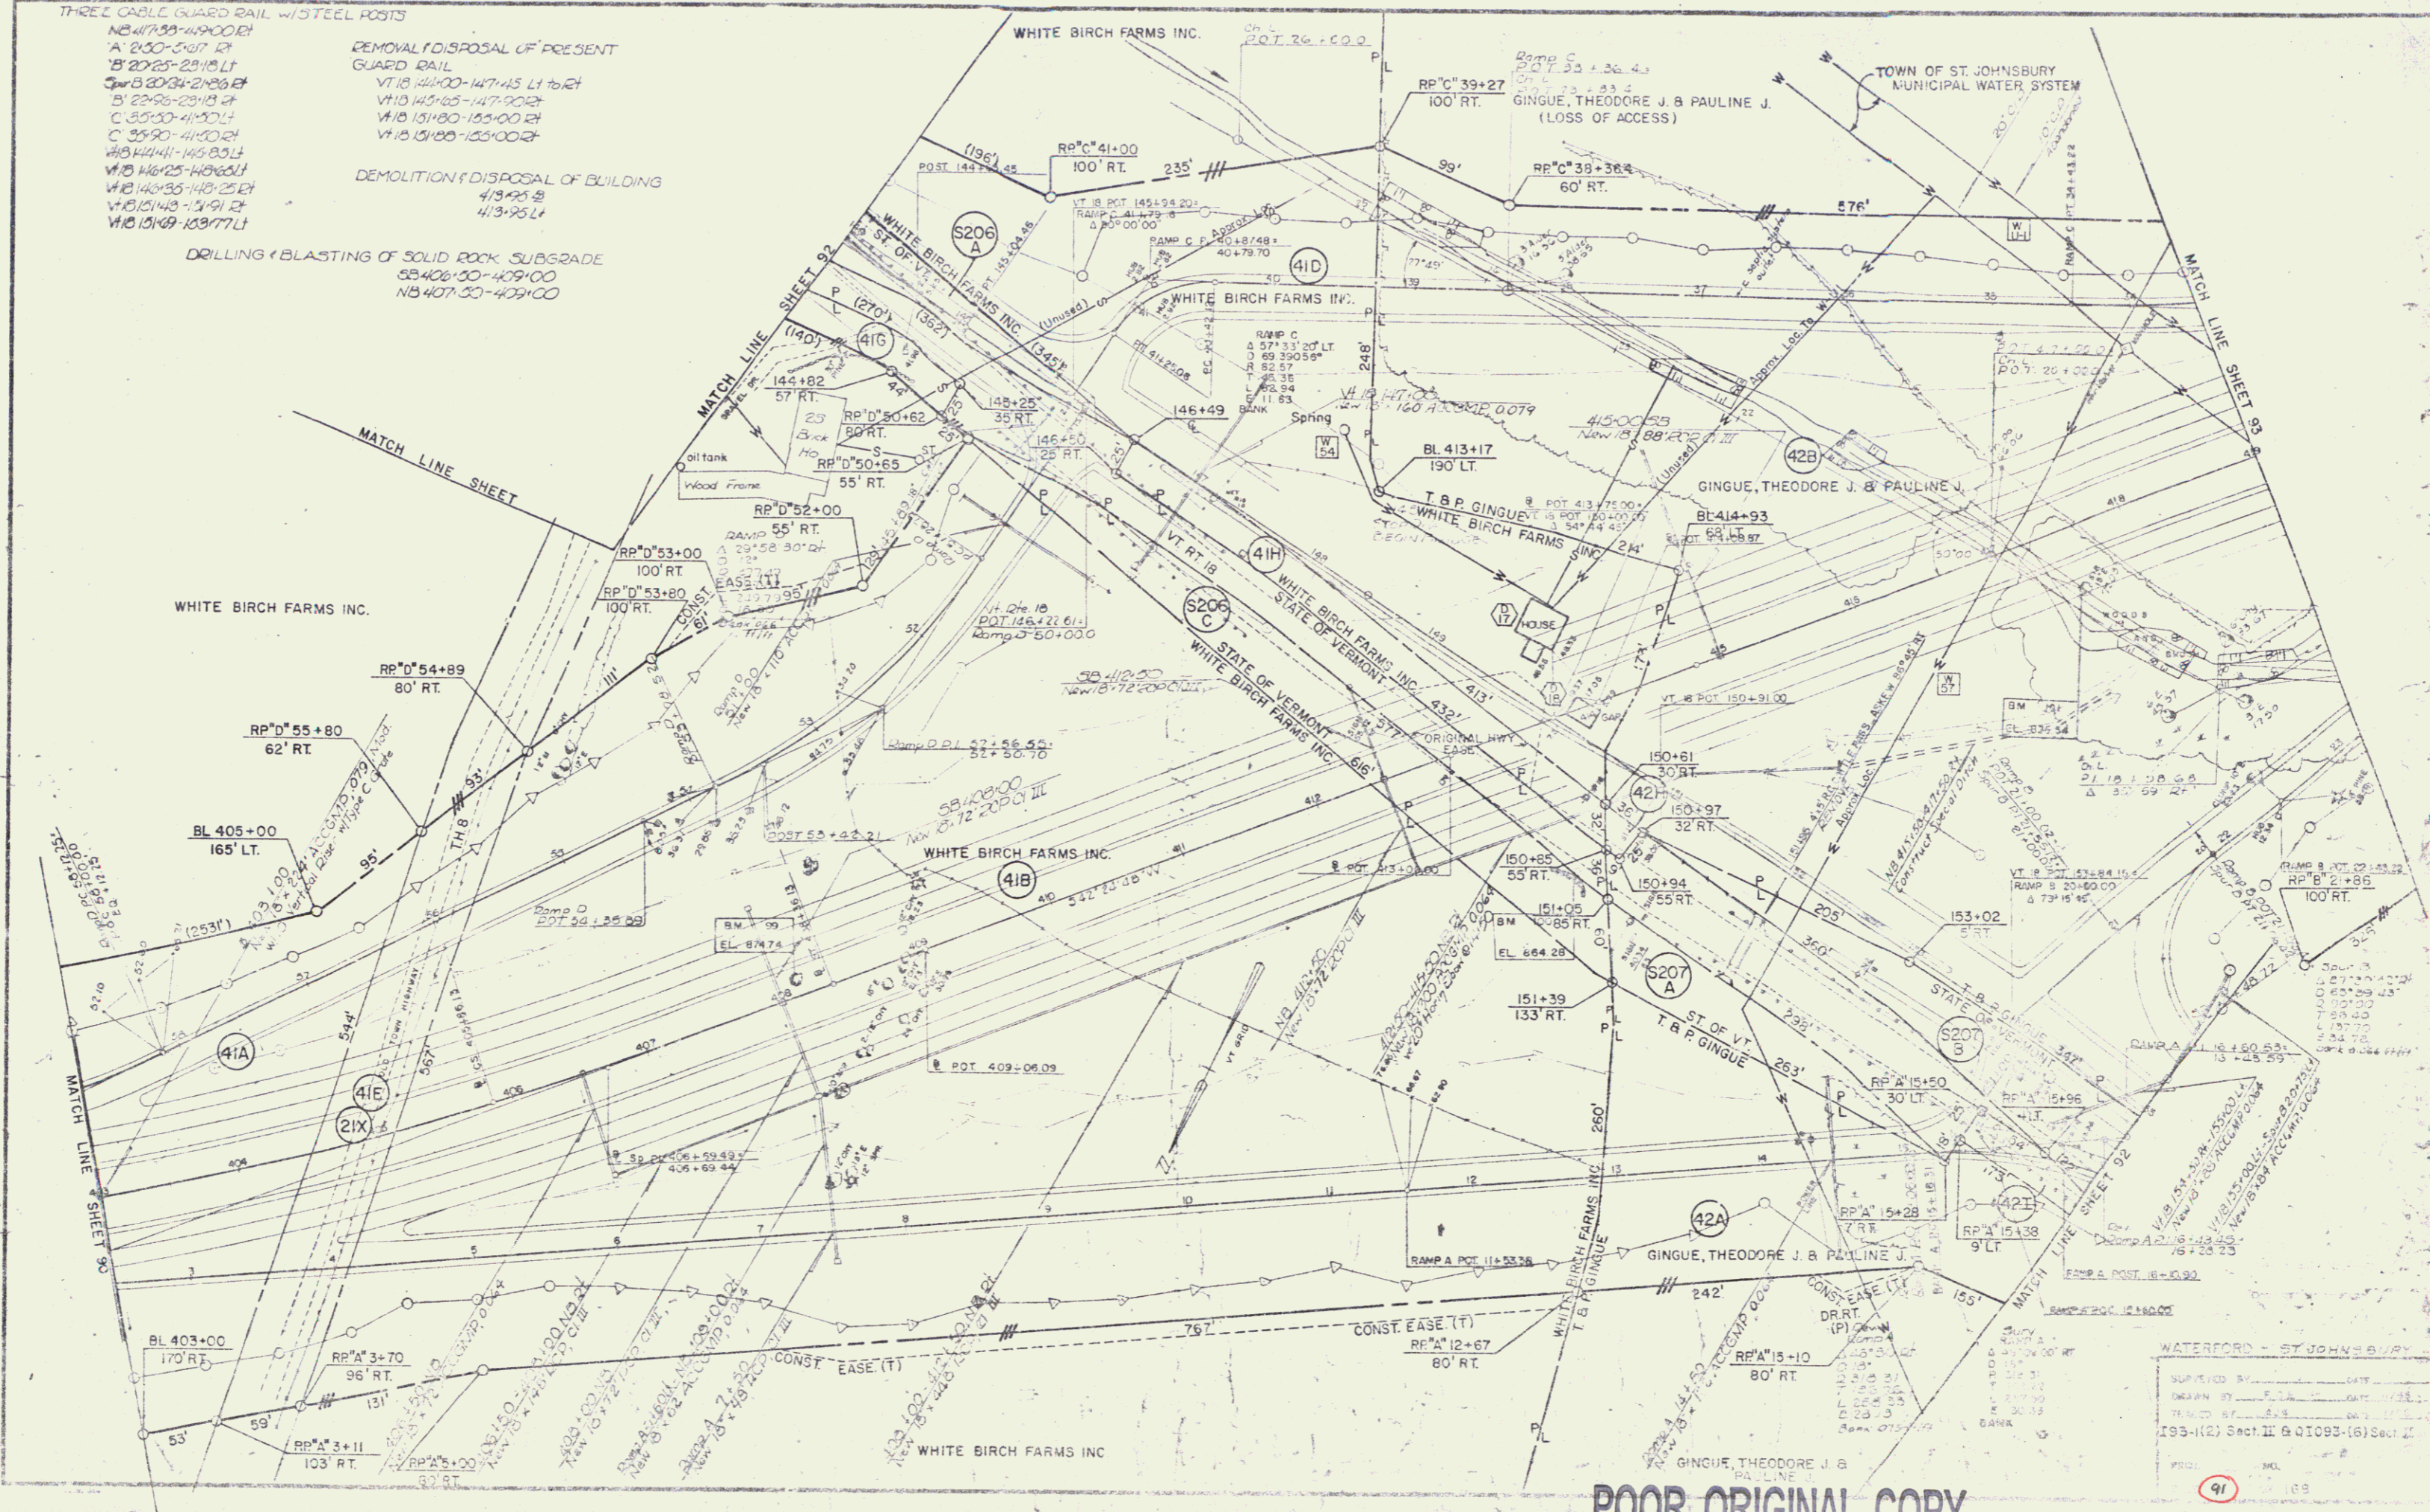

POOR ORIGINAL COPY

WATERFORD - ST. JOHNSBURY
 SHEET 91
 85