

* Denotes Stage II Construction


Bit. Conc. Surf for Gutters & Traffic Islands
Med. 430+00-430+25

Jute Matting
Med 426+00-430+00
SB 426+20-435+00 LT
Med 430+25-432+25

Woven Wire Fence w/ Steel Posts
SB 425+00-435+00 LT
NB 425+00-435+00 RT

4" DRAINAGE TILE SHOWN IN APPROX. LOC.

"Control of Access is complete on this sheet"

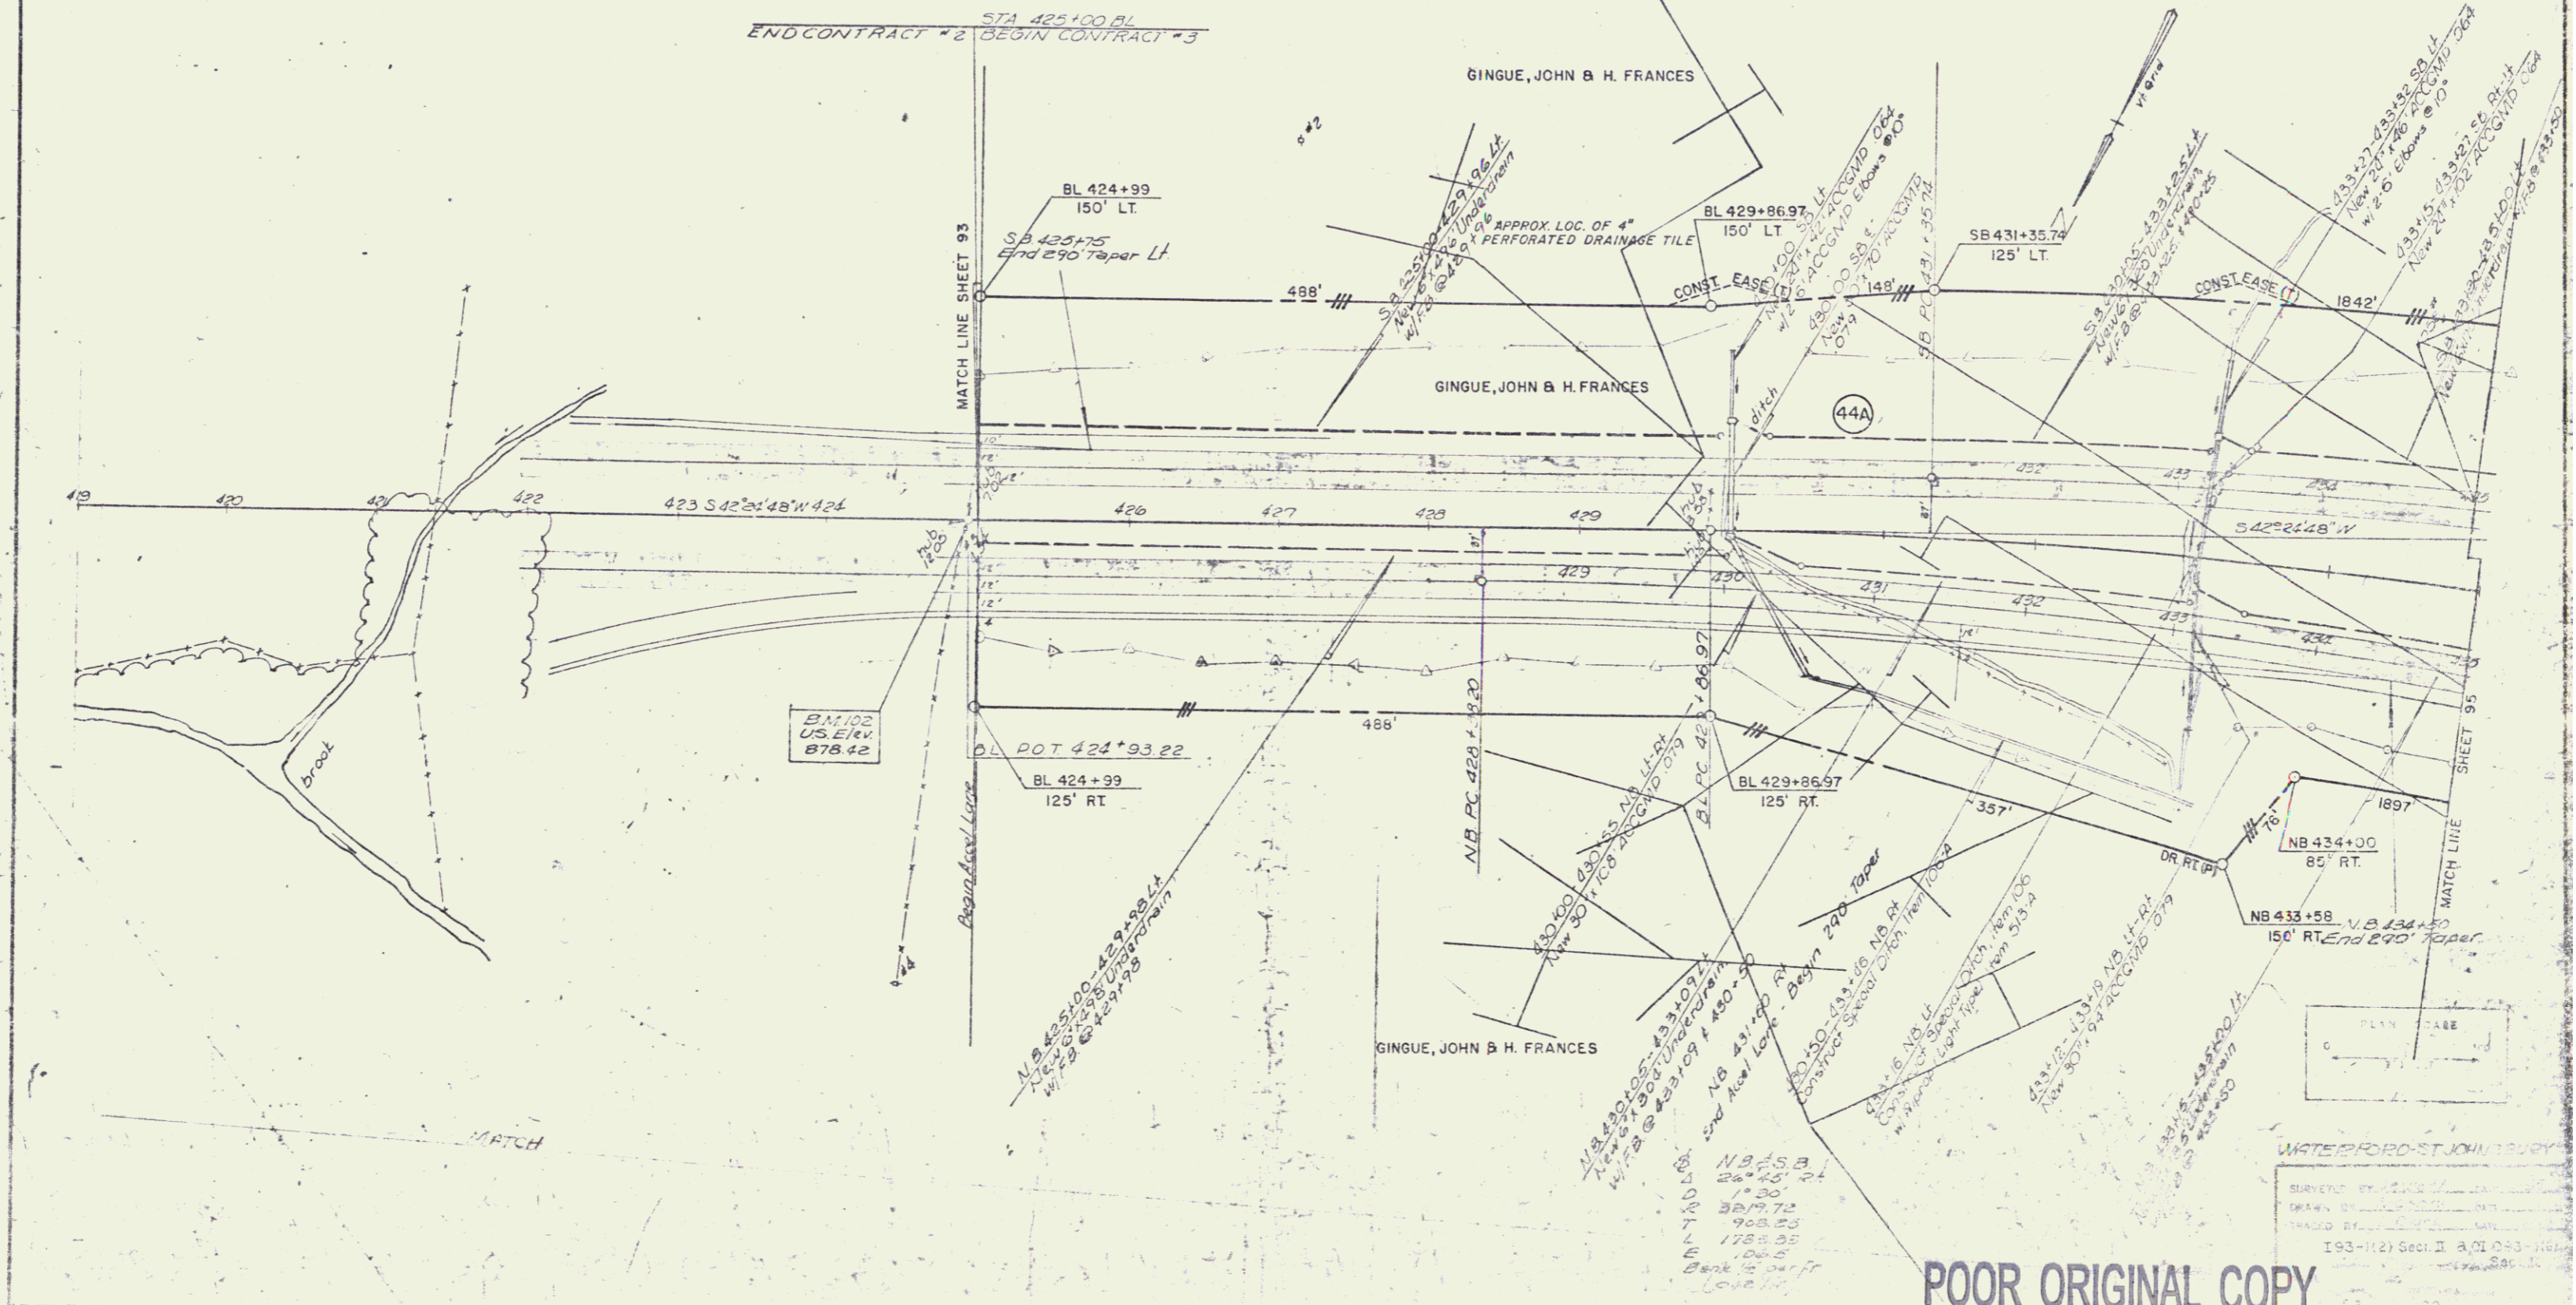

POOR ORIGINAL COPY

SHEET 94
89