


TREATED TIMBER CURB  
15+00 ~ 22+76 LT.

CON. TH4 FLAIVE  
9+00 LT.  
12+50 LT.  
CONSTRUCT APPROACH  
7+00 ~ 9+00 LT.

Guard Rail, Std. St. Beam, Wood Posts, Type II.  
TH 4 14+51 ~ 22+76 RA  
TH 4 14+89 ~ 22+76 LA

ALL DRIVES AS INDICATED ON PLANS ARE  
SUBJECT TO PERMITS PURSUANT TO  
TITLE 19, SECTION 43, V.S.A.

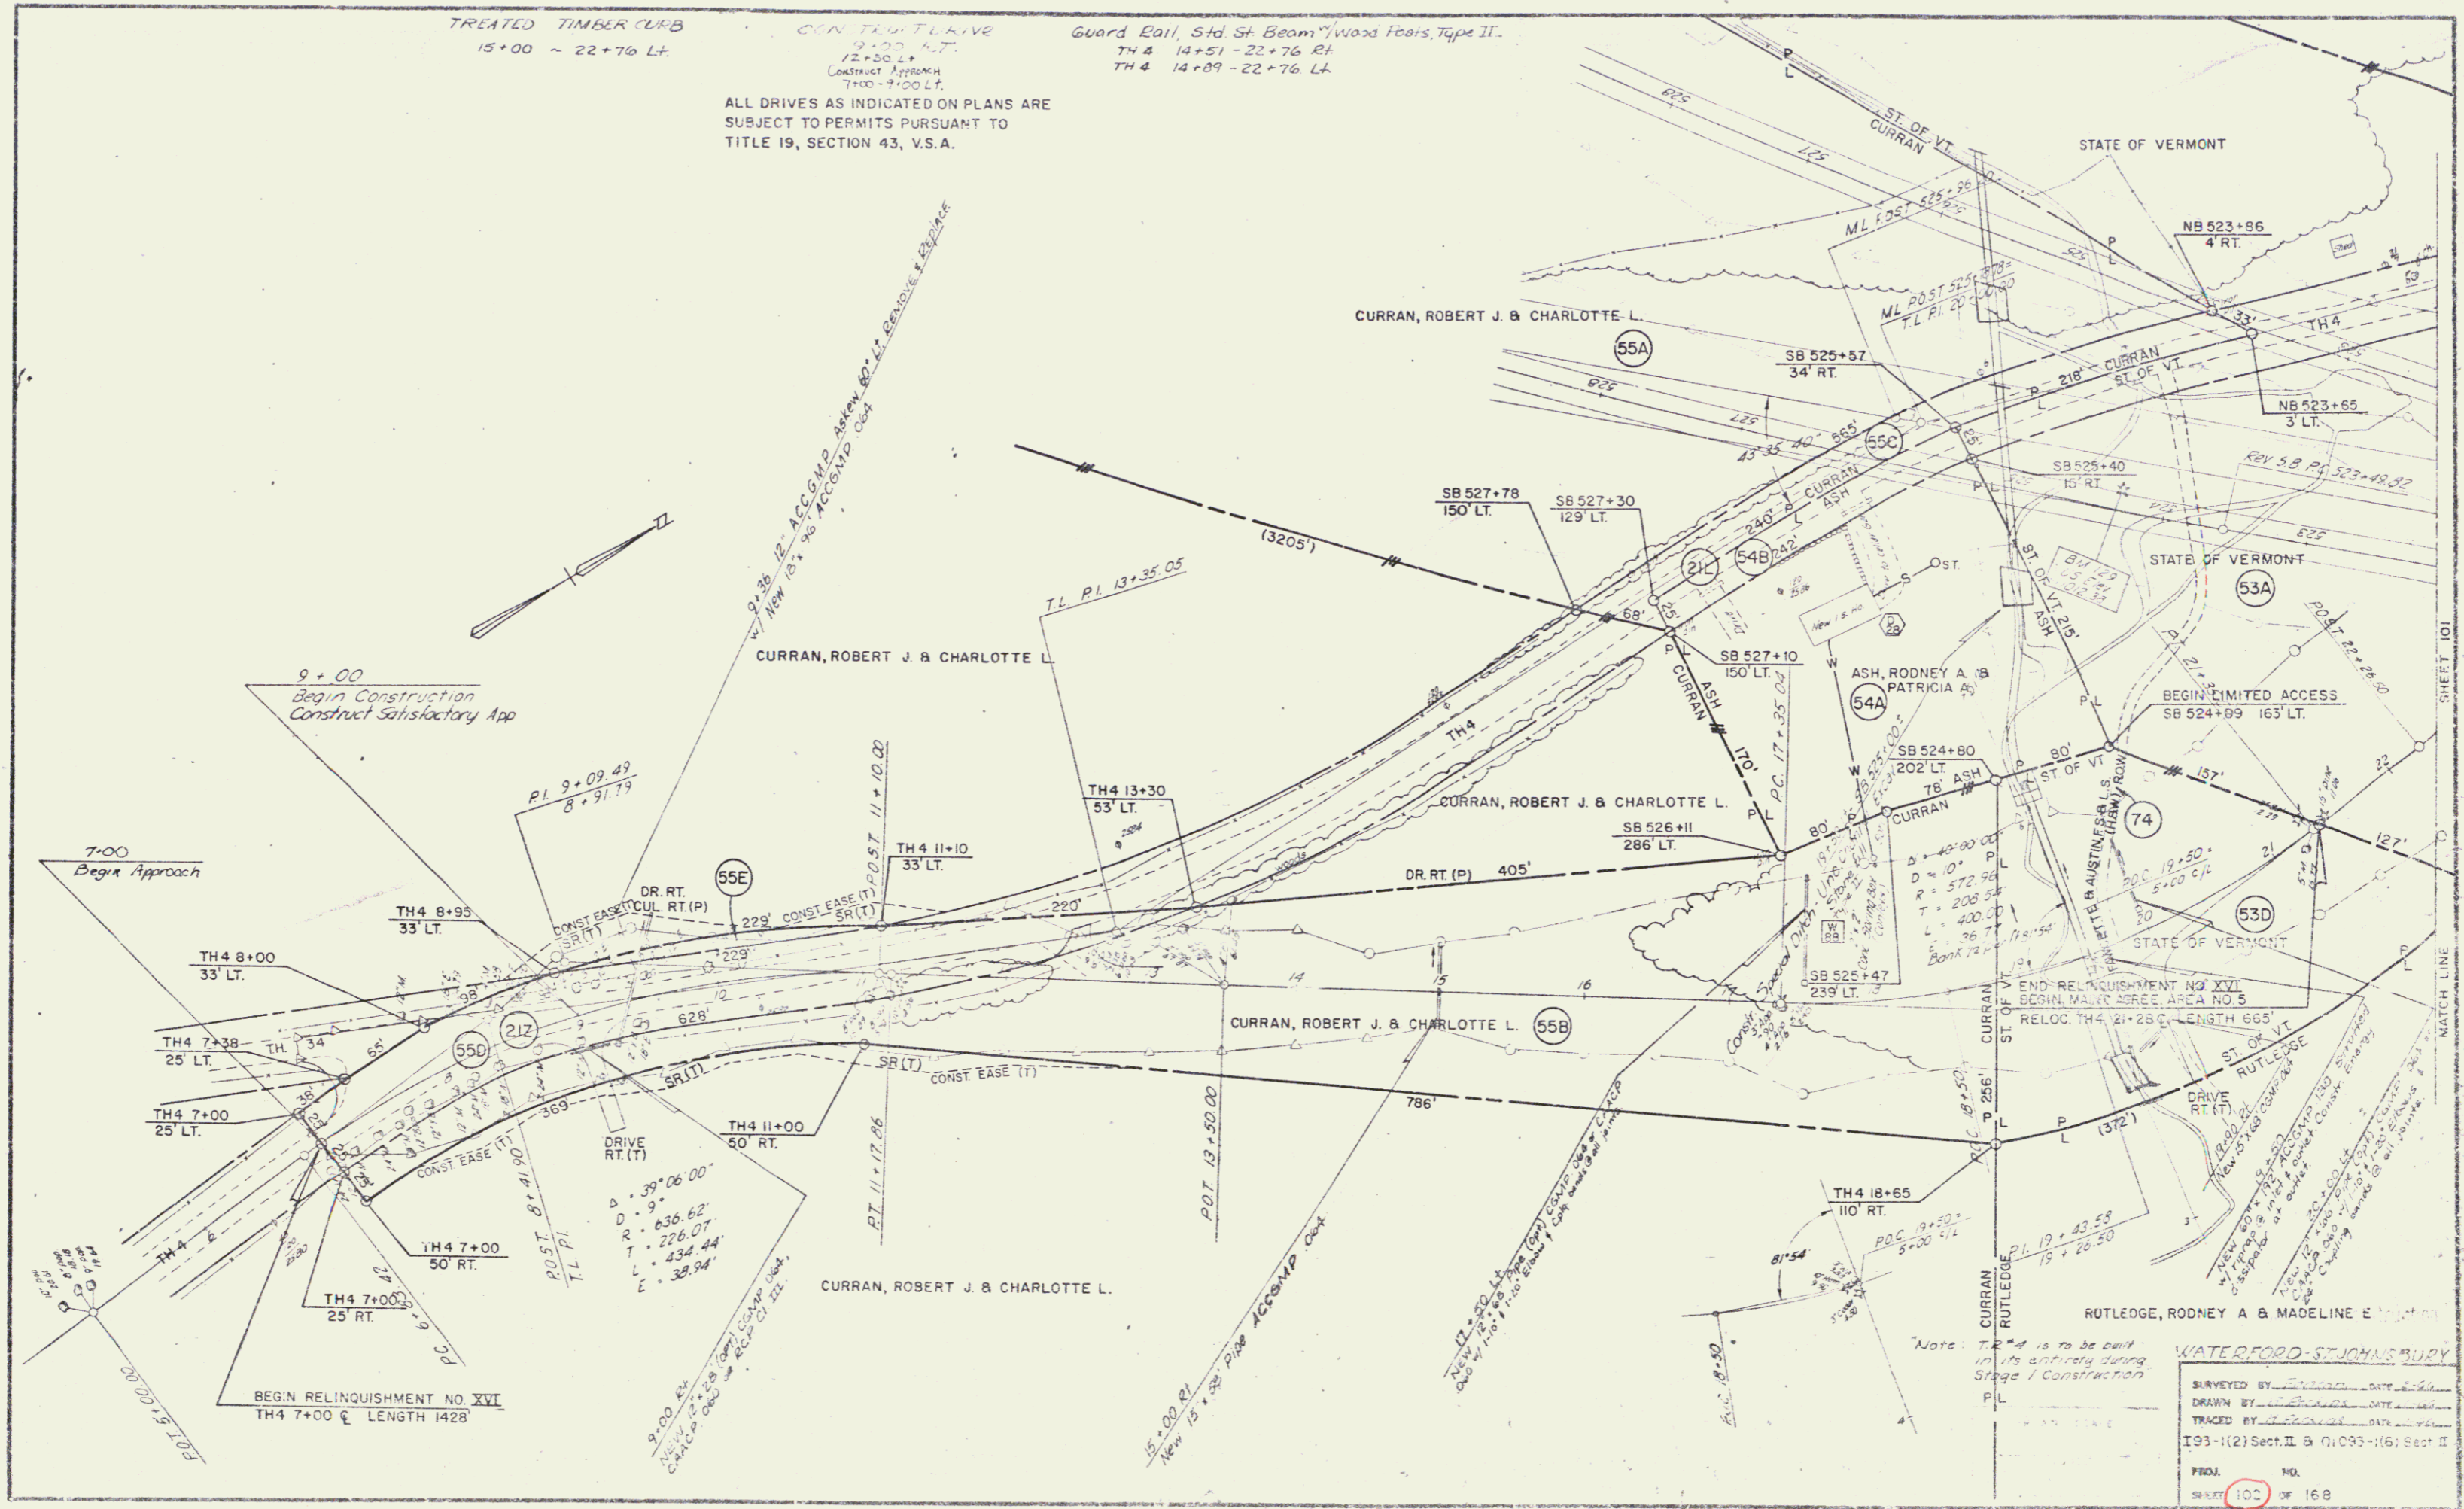

WATERFORD-ST. JOHNS BURY

SURVEYED BY	DATE
DRAWN BY	DATE
TRACED BY	DATE
I 93-1(2) Sect. II B (1) (93-16) Sect II	
PROJ.	NO.
SHEET	100 OF 168