


ALL DRIVES AS INDICATED ON PLANS ARE SUBJECT TO PERMITS PURSUANT TO TITLE 19, SECTION 43, V.S.A.

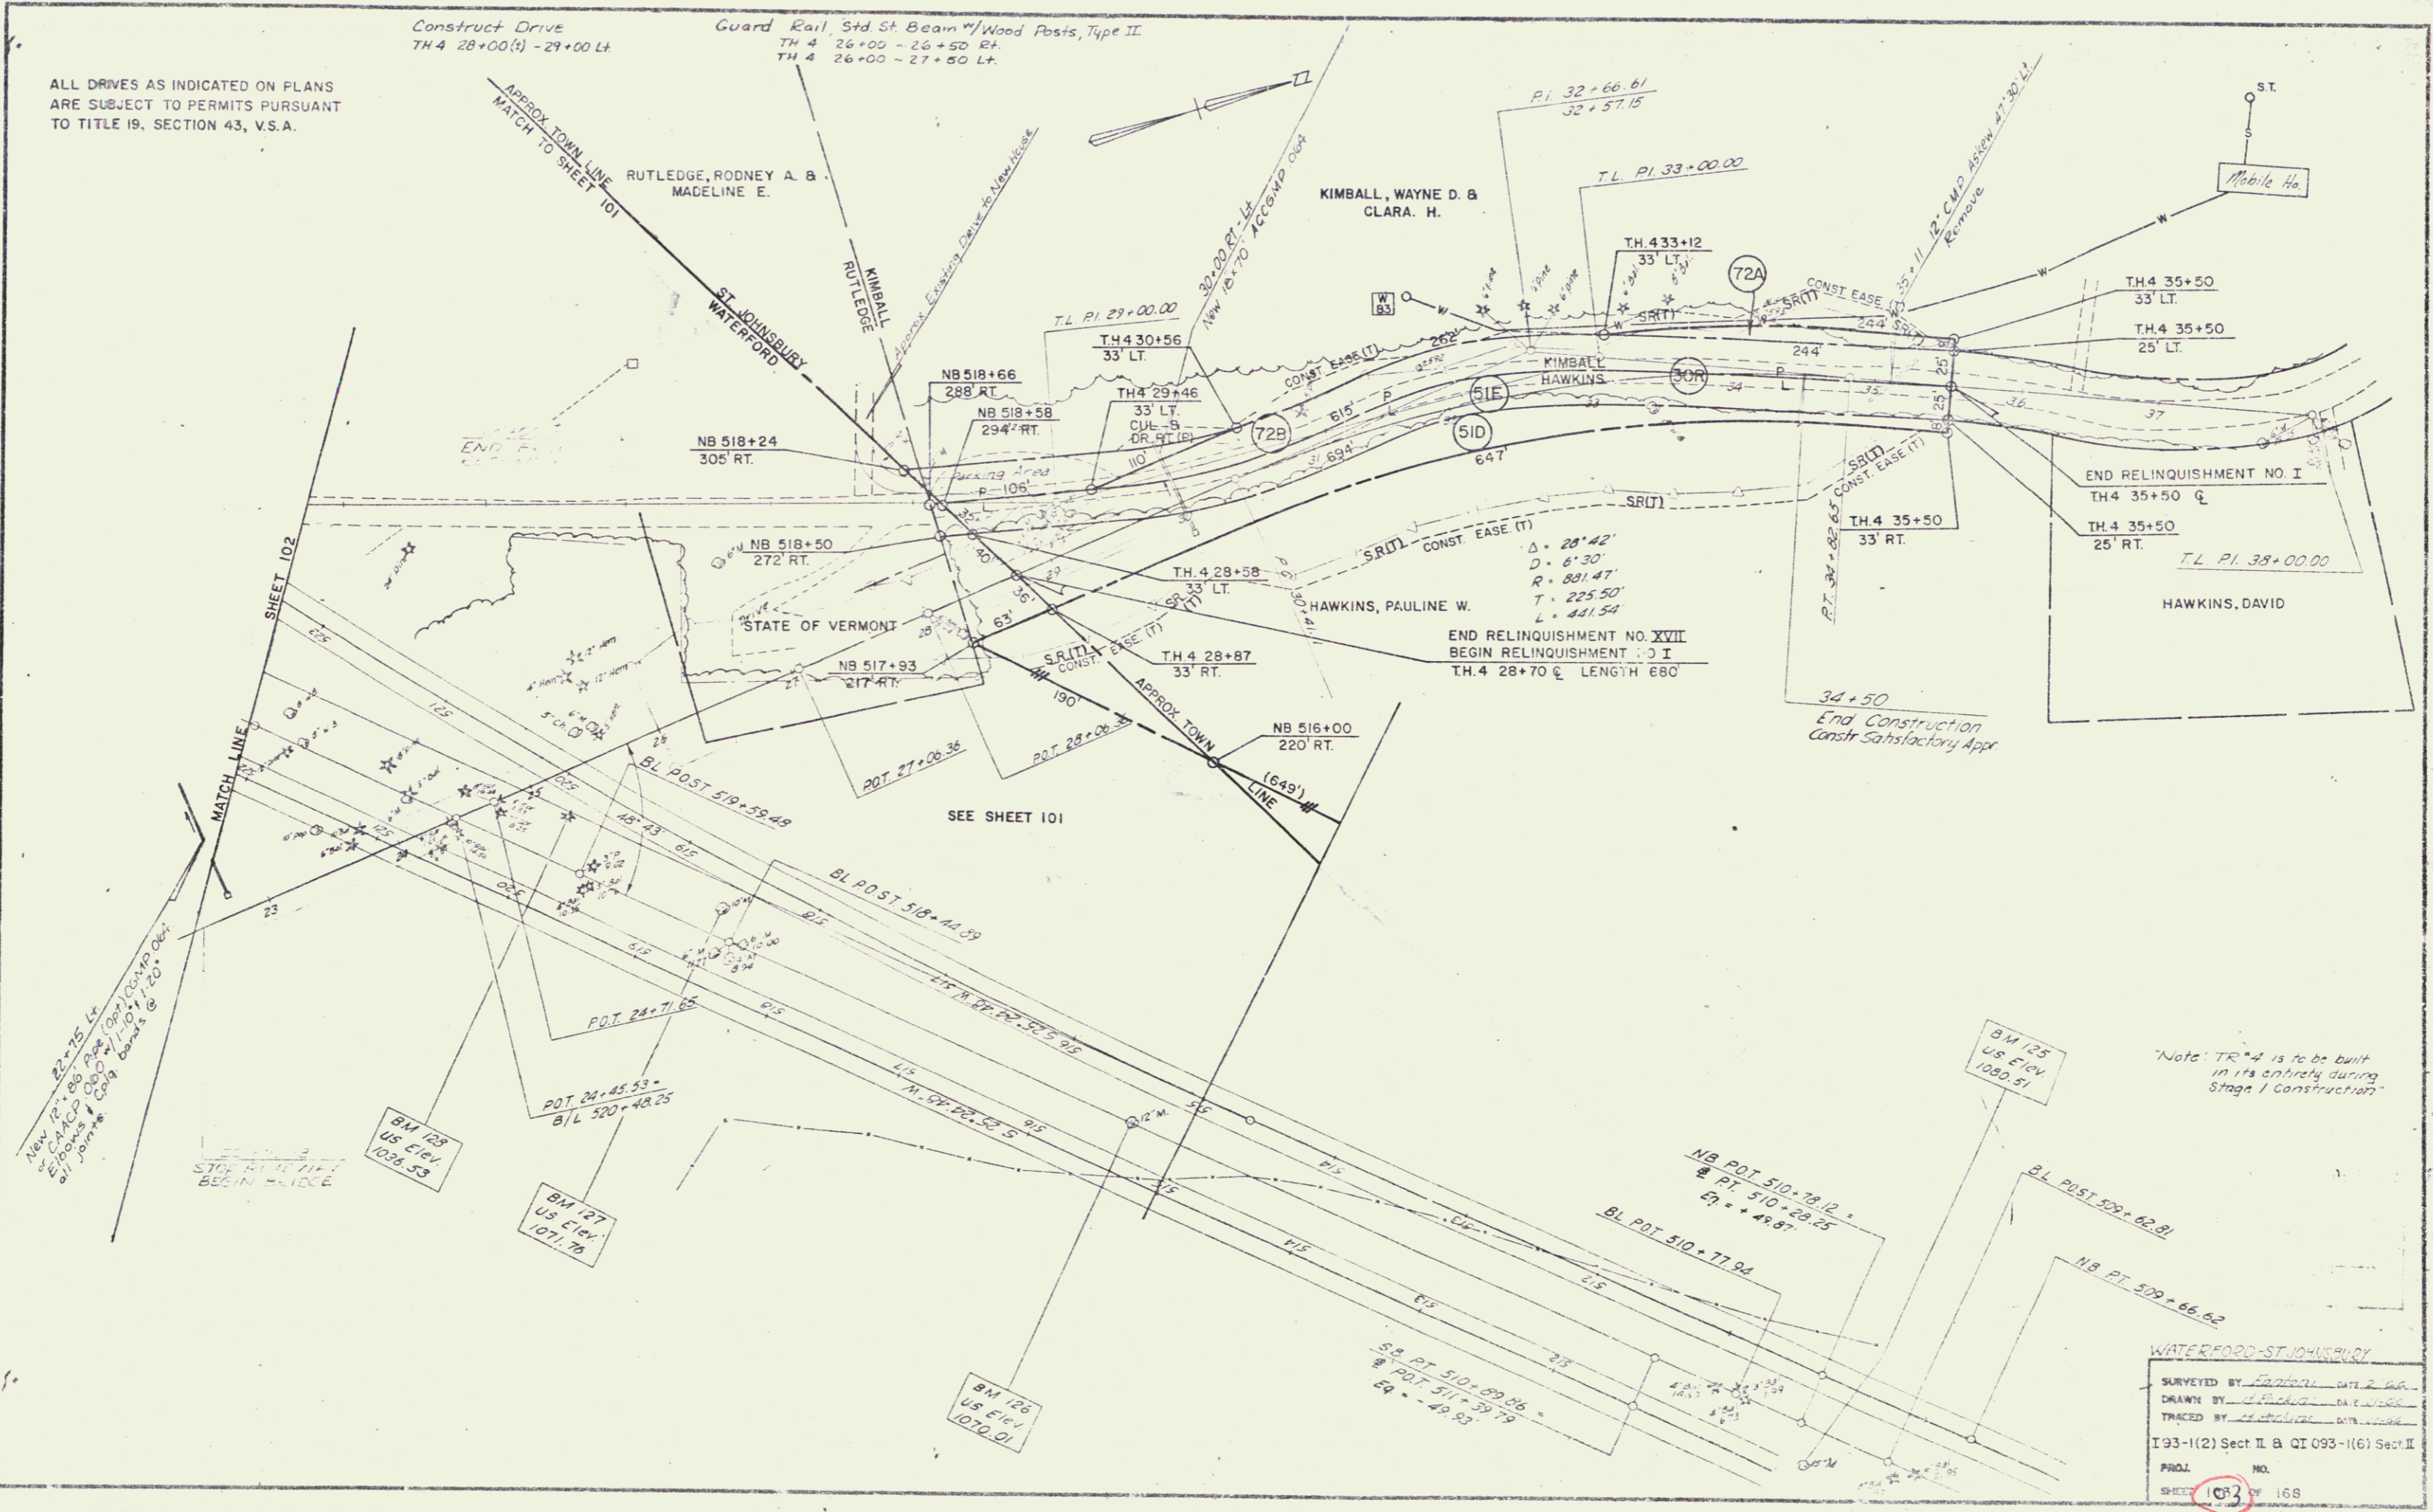

WATERFORD-ST. JOHNSBURY
 SURVEYED BY [Signature] DATE 2-68
 DRAWN BY [Signature] DATE 2-68
 TRACED BY [Signature] DATE 2-68
 I 93-1(2) Sect II & QI 093-1(6) Sect II
 PROJ. NO.
 SHEET 102 OF 168
 0-7