


Jute Matting
 SB 555+75 - 559+50 LT
 SB 561+00 - 563+00 LT
 SB 561+75 - 563+00 RT

Guard Rail, 3 Cable w/ Lt Wood Posts *
 SB 548+87 - 557+35 RT
 SB 560+73 - 563+00 RT

Woven Wire Fence w/ Steel Posts
 SB 548+00 - 563+00 LT

"Control of Access is complete on this sheet"

* Denotes Stage II Construction

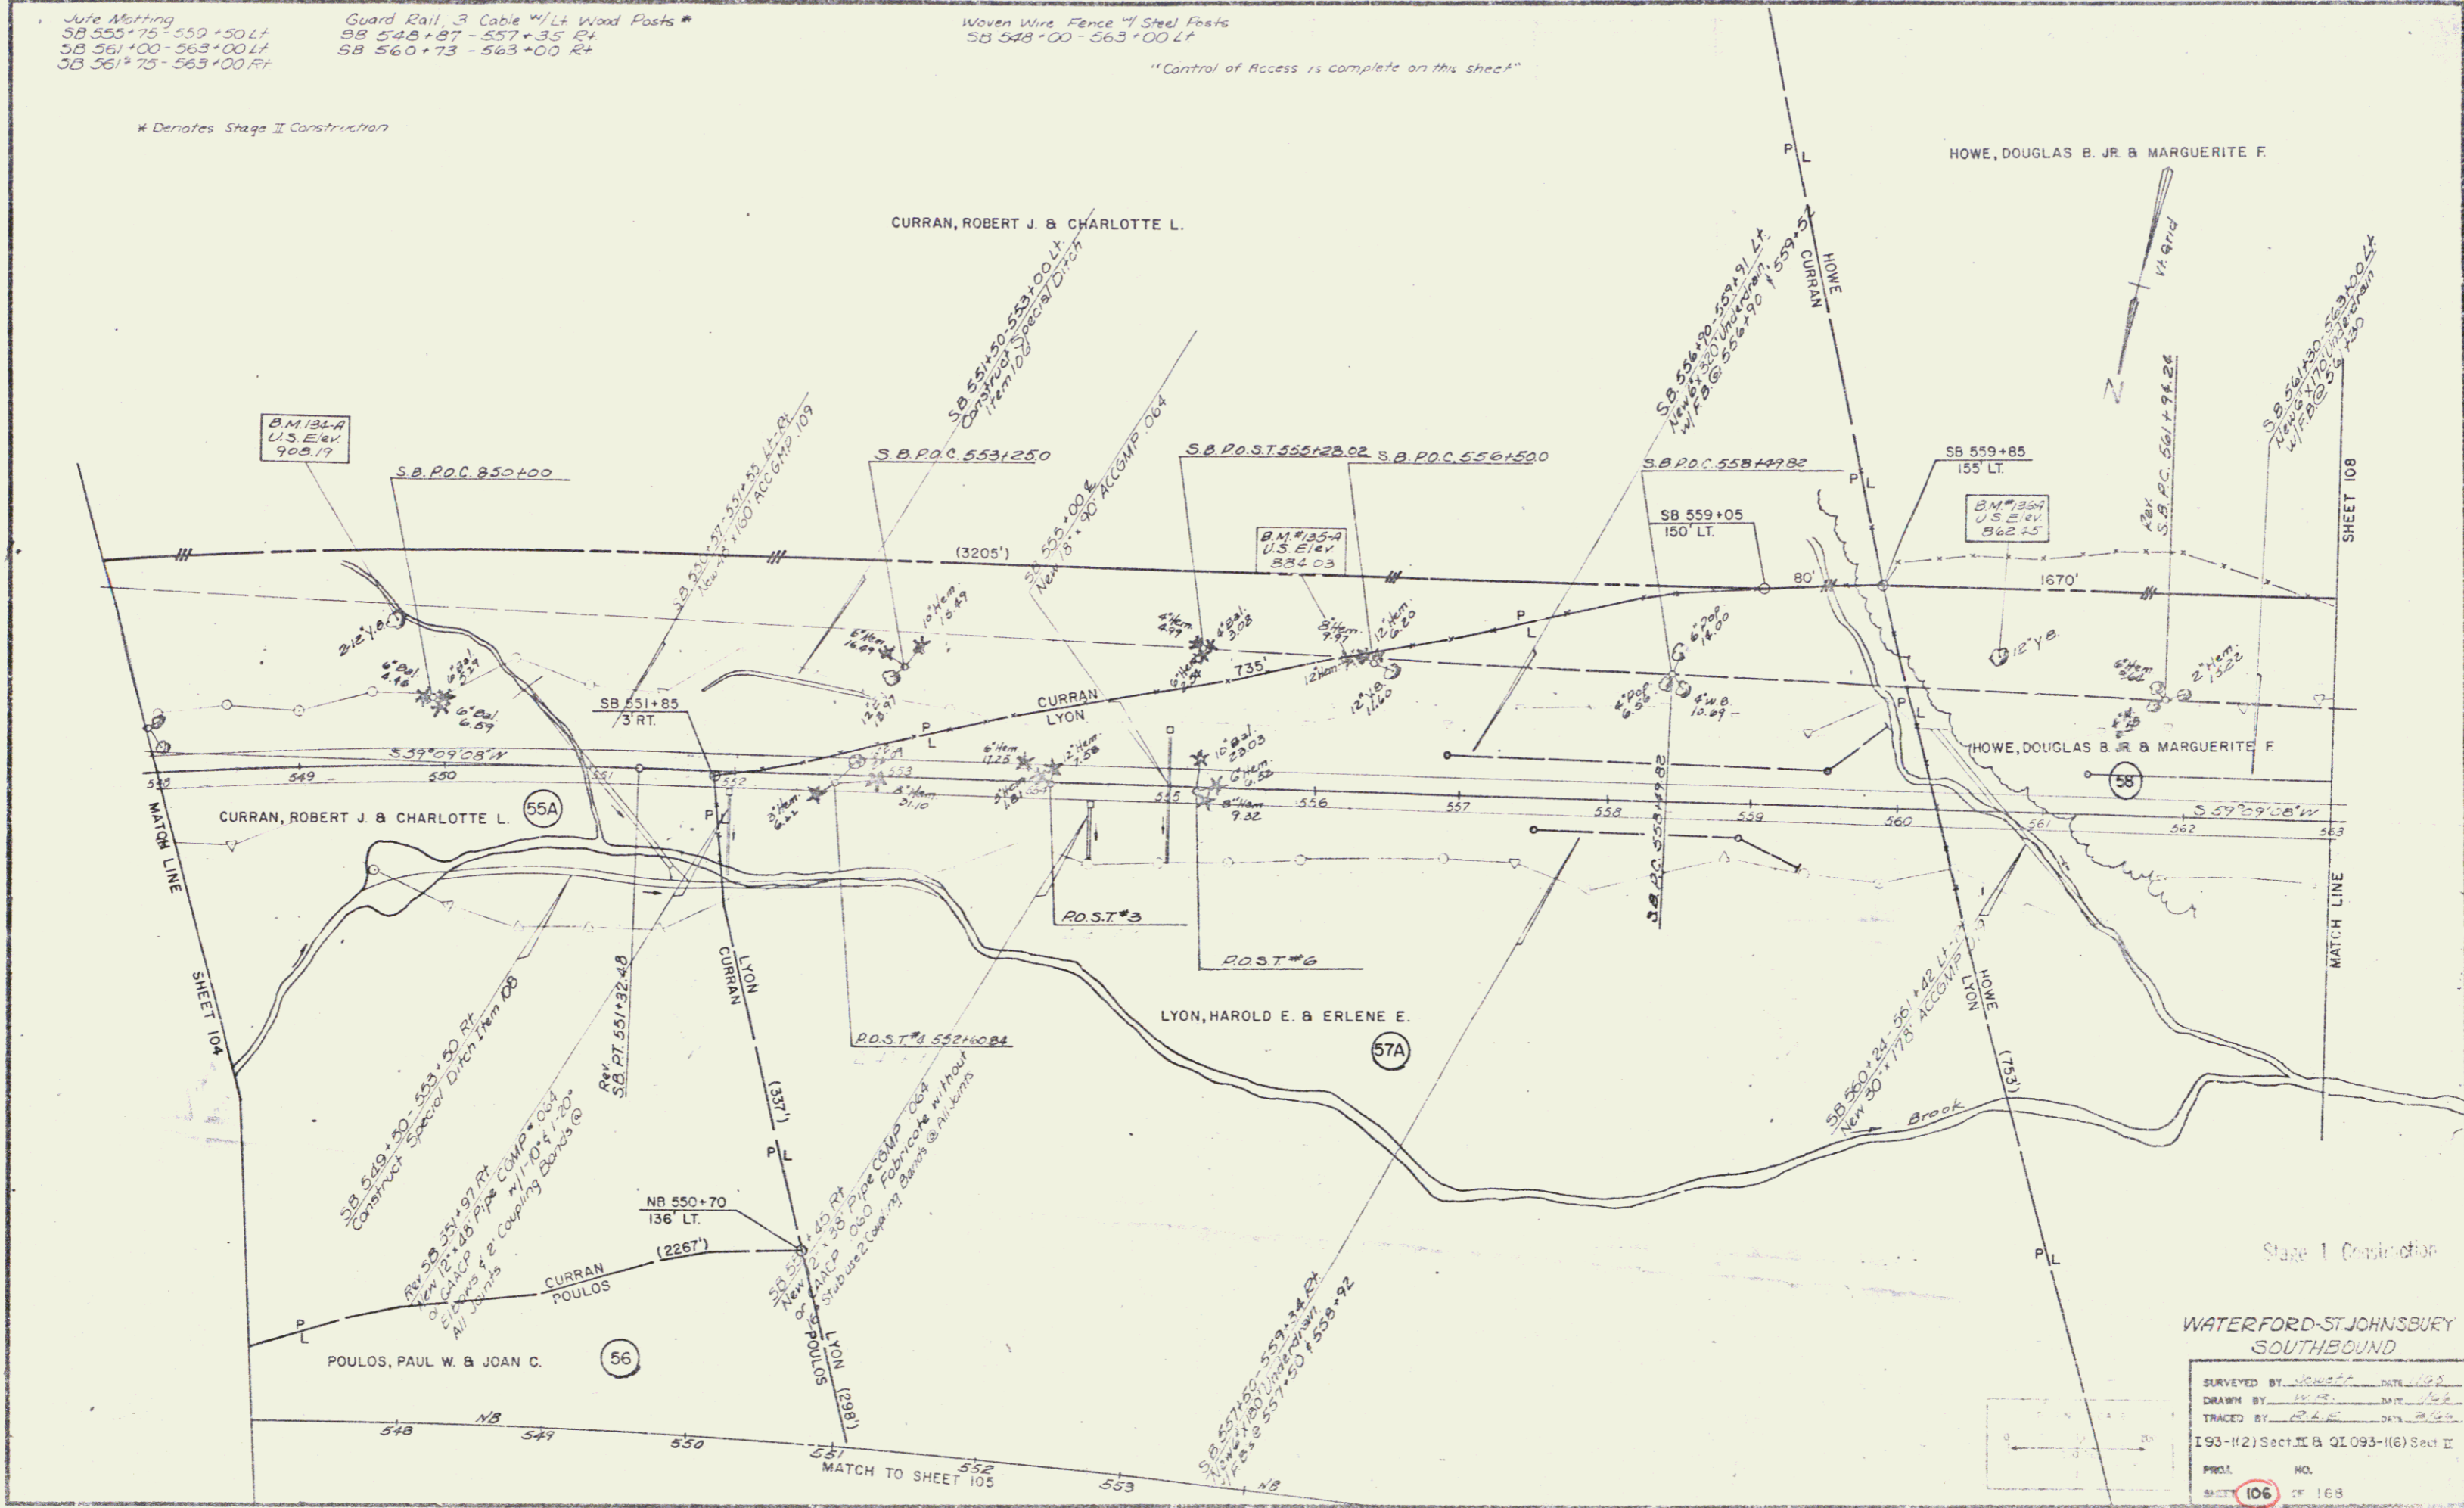

Stage I Construction
 WATERFORD-ST. JOHNSBURY
 SOUTHBOUND

SURVEYED BY	DATE
DRAWN BY	DATE
TRACED BY	DATE
I 93-112) Sect. II & QI 093-116) Sect. II	
PROJ. NO.	
SHEET NO.	106
OF	163

106
104