


STATE OF VERMONT
DEPARTMENT OF HIGHWAYS

PROPOSED IMPROVEMENT

FEDERAL AID PROJECT

TOWNS OF MILTON AND COLCHESTER
COUNTY OF CHITTENDEN
U.S. ROUTE 2
ALBURG-BURLINGTON ROAD


R.O.W. PLANS

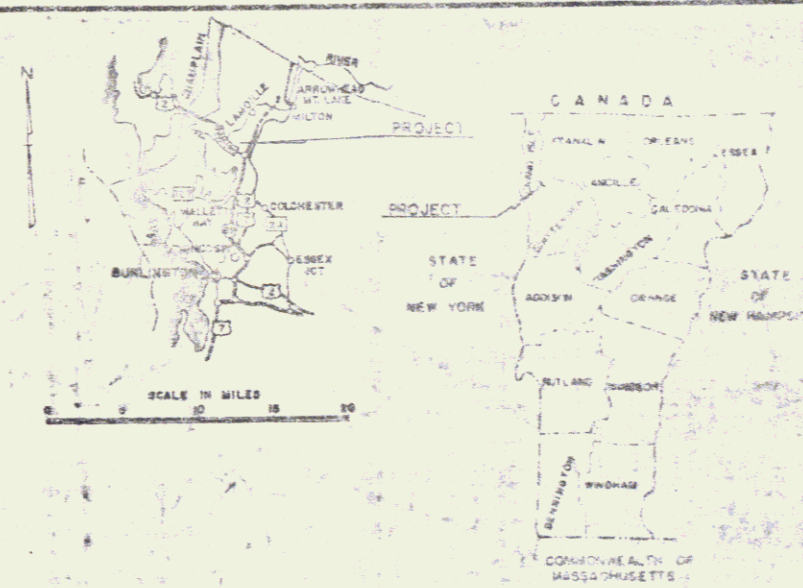

BEGIN R.O.W. PROJ. F028-1(3)
STA. 103+11.06 @

BEGINNING AT A POINT APPROXIMATELY 1.93 MILES NORTHERLY
OF THE MILTON-COLCHESTER TOWN LINE AND EXTENDING
SOUTHEASTERLY 3.144 MILES

LENGTH OF ROADWAY 16,156.00 FEET 3.060 MILES
LENGTH OF BRIDGES 444.00 FEET 0.084 MILES
LENGTH OF PROJECT 16,600.00 FEET 3.144 MILES
LENGTH OF R.O.W. PROJECT 16,790.94 FEET 3.180 MILES

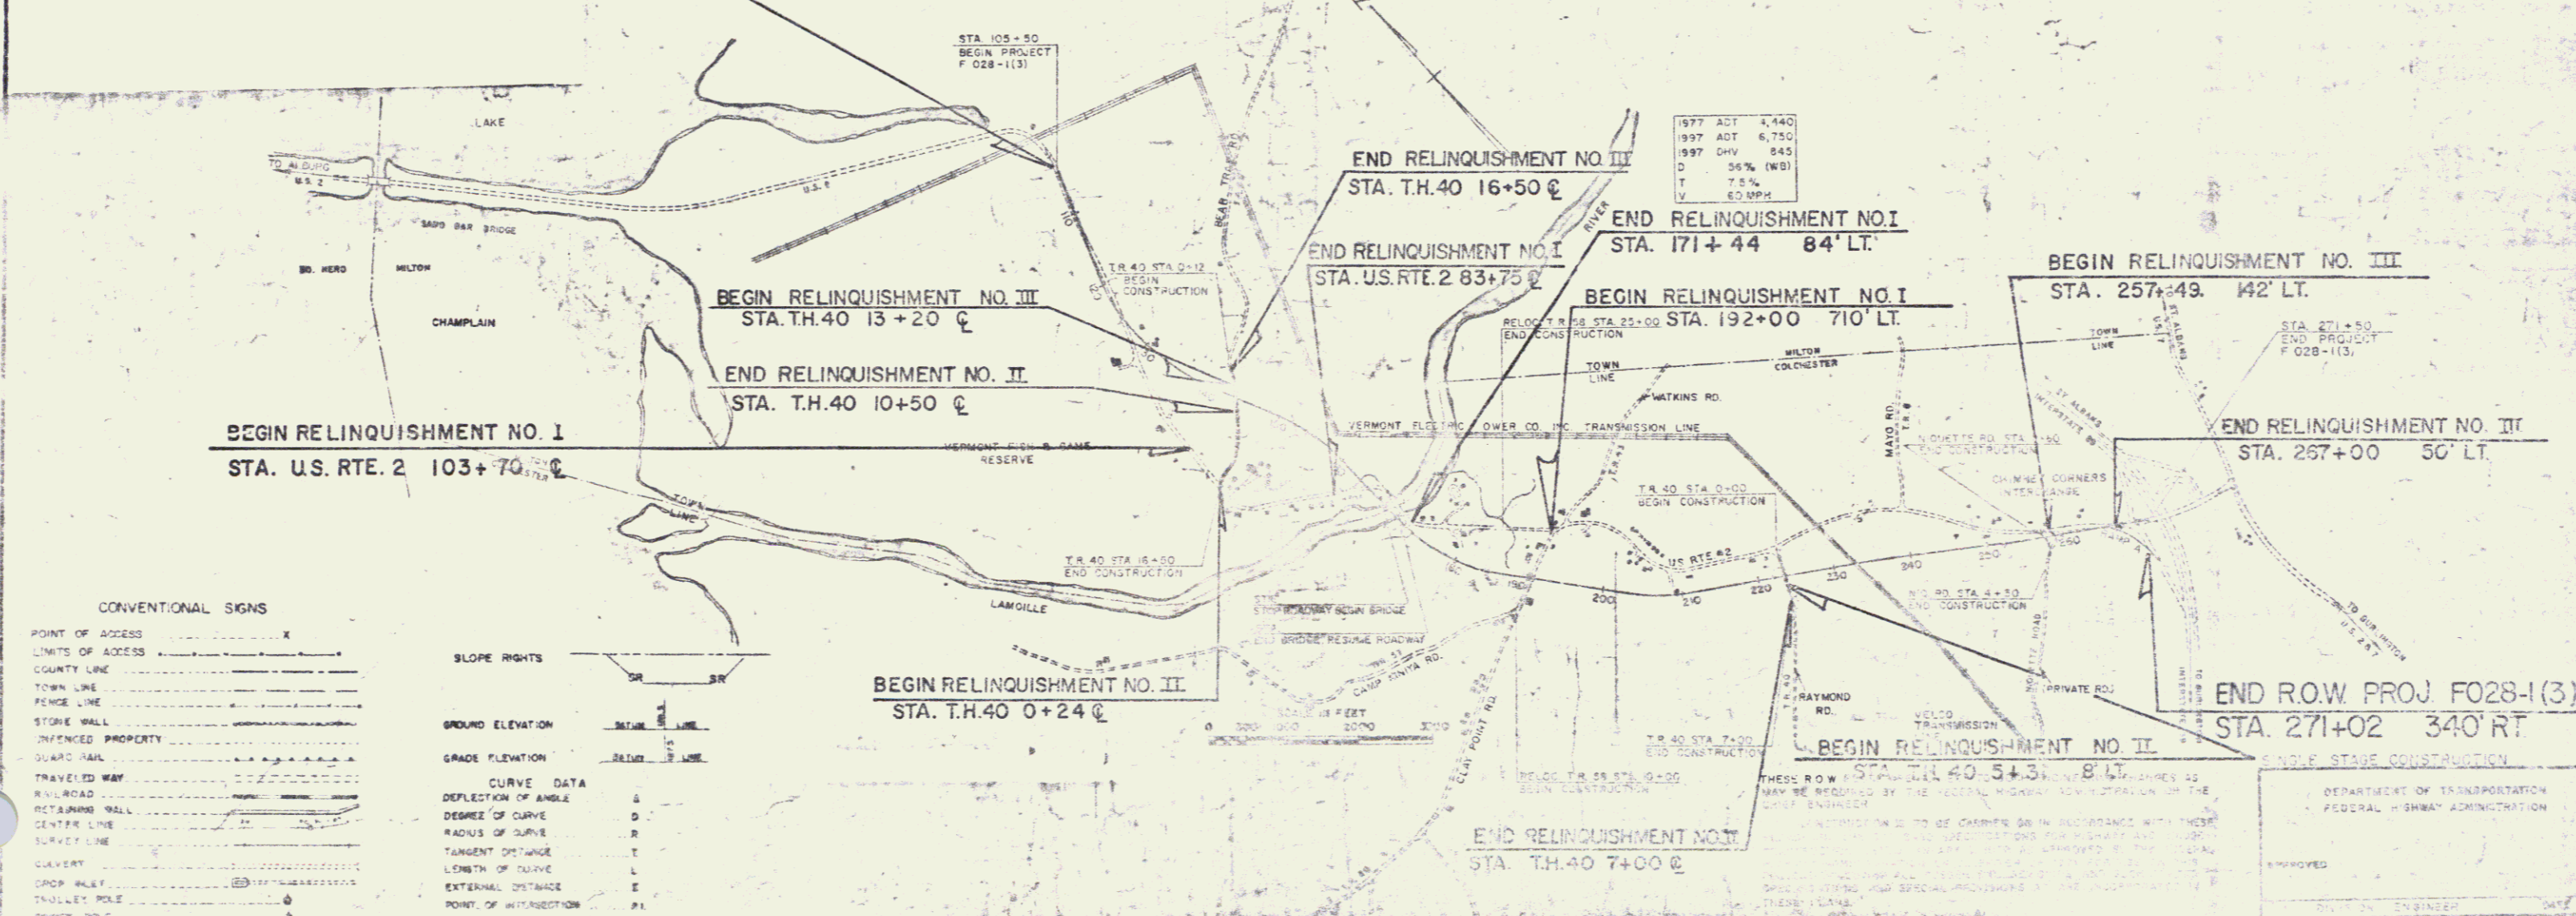

1977 ADT	4,440
1997 ADT	6,750
1997 DHV	845
D	55% (WB)
T	7.5%
V	60 MPH

CONVENTIONAL SIGNS

POINT OF ACCESS	X
LIMITS OF ACCESS	-----
COUNTY LINE	-----
TOWN LINE	-----
FENCE LINE	-----
STONE WALL	-----
UNFENCED PROPERTY	-----
QUAD RAIL	-----
TRAVELED WAY	-----
RAILROAD	-----
RETAINING WALL	-----
CENTER LINE	-----
SURVEY LINE	-----
CLVERT	-----
CRIP. HOLE	-----
TRAILLET POLE	-----
POWER POLE	-----
TELEPHONE POLE	-----
TRUCK	-----

SLOPE RIGHTS

GROUND ELEVATION

GRADE ELEVATION

CURVE DATA

DEFLECTION OF ANGLE	Δ
DEGREE OF CURVE	D
RADIUS OF CURVE	R
TANGENT DISTANCE	T
LENGTH OF CURVE	L
EXTERNAL DISTANCE	E
POINT OF INTERSECTION	PI
POINT OF CURVE	PC
POINT OF TANGENT	PT
POINT ON TANGENT	POT
POINT ON SUB-TANGENT	POST

THESE R.O.W. PLANS ARE TO BE CONSIDERED AS APPROVED IN ACCORDANCE WITH THESE
CONDITIONS: 1. THE FEDERAL HIGHWAY ADMINISTRATION HAS REVIEWED AND APPROVED THESE
PLANS AND THE FEDERAL AID PROJECT HAS BEEN ESTABLISHED BY THE FEDERAL
HIGHWAY ADMINISTRATION. 2. THE STATE OF VERMONT HAS REVIEWED AND APPROVED THESE
PLANS AND THE STATE AID PROJECT HAS BEEN ESTABLISHED BY THE STATE OF VERMONT.
3. THE PROJECT HAS BEEN APPROVED BY THE VERMONT DEPARTMENT OF TRANSPORTATION.
4. THE PROJECT HAS BEEN APPROVED BY THE VERMONT DEPARTMENT OF CONSERVATION AND
FORESTRY. 5. THE PROJECT HAS BEEN APPROVED BY THE VERMONT DEPARTMENT OF
NATURAL RESOURCES. 6. THE PROJECT HAS BEEN APPROVED BY THE VERMONT DEPARTMENT
OF LAND USE AND PLANNING. 7. THE PROJECT HAS BEEN APPROVED BY THE VERMONT
DEPARTMENT OF ENVIRONMENTAL QUALITY. 8. THE PROJECT HAS BEEN APPROVED BY THE
VERMONT DEPARTMENT OF PUBLIC SAFETY. 9. THE PROJECT HAS BEEN APPROVED BY THE
VERMONT DEPARTMENT OF SOCIAL SERVICES. 10. THE PROJECT HAS BEEN APPROVED BY THE
VERMONT DEPARTMENT OF HEALTH SERVICES. 11. THE PROJECT HAS BEEN APPROVED BY THE
VERMONT DEPARTMENT OF EDUCATION. 12. THE PROJECT HAS BEEN APPROVED BY THE
VERMONT DEPARTMENT OF LABOR. 13. THE PROJECT HAS BEEN APPROVED BY THE
VERMONT DEPARTMENT OF REVENUE. 14. THE PROJECT HAS BEEN APPROVED BY THE
VERMONT DEPARTMENT OF TAXES. 15. THE PROJECT HAS BEEN APPROVED BY THE
VERMONT DEPARTMENT OF JUSTICE. 16. THE PROJECT HAS BEEN APPROVED BY THE
VERMONT DEPARTMENT OF CORRECTIONS. 17. THE PROJECT HAS BEEN APPROVED BY THE
VERMONT DEPARTMENT OF PROBATE AND NOTARIAL PUBLICS. 18. THE PROJECT HAS BEEN
APPROVED BY THE VERMONT DEPARTMENT OF SENIOR SERVICES. 19. THE PROJECT HAS
BEEN APPROVED BY THE VERMONT DEPARTMENT OF COMMUNITY DEVELOPMENT. 20. THE
PROJECT HAS BEEN APPROVED BY THE VERMONT DEPARTMENT OF ECONOMIC DEVELOPMENT.

APPROVED _____
DATE _____
R.O.W. DIRECTOR

DEPARTMENT OF TRANSPORTATION
FEDERAL HIGHWAY ADMINISTRATION

APPROVED _____
DATE _____
MILTON - COLCHESTER
PROJECT NO. F028-1(3)
SHEET 1 OF 15