

**JUTE MATTING**  
 ITEM 654.10  
 121+50-122+50 Lt.  
 125+50-127+50 Lt.

**DRILLING & BLASTING OF SOLID**  
 ROCK SUBGRADE, ITEM 206.10  
 113+00-113+77

**SAND BORROW, ITEM 203.31**  
 113+00-121+00  
 GUARD RAIL, PLANK W/ WOOD  
 POSTS, ITEM 621.10  
 126+85 Rt.

**EXCAVATION AND REMOVAL OF**  
 ROAD SURFACES AND PAVEMENTS  
 ITEM 202.15  
 125+50-127+00 Rt.

**WOVEN WIRE FENCE W/  
 STEEL POSTS, ITEM 620.25**  
 113+00-129+00 Rt.  
 113+00-129+00 Lt.

**DEMOLITION & DISPOSAL OF**  
 BUILDING, ITEM 202.10  
 127+85 Lt. (Shed)

Δ  
 0° 14' Lt.  
 2°  
 2864.79'  
 5.83'  
 11.66'  
 0.0  
 Bank 0.057 ft./ft.


Curve Data  
 Δ 45° 59' 11" Lt.  
 2°  
 2864.82'  
 1215.64'  
 2299.32'  
 247.25'  
 Bank 0.057 ft./ft.

B.M. 47  
 U.S. Elev  
 171.83

B.M. 40  
 U.S. Elev  
 165.47

PL 128+20.44  
 126+8934  
 PL 129+45.56  
 120+13.62  
 200+5442 (Survey)

SINGLE STAGE CONSTRUCTION

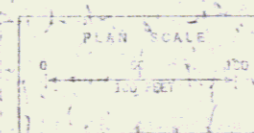

SURVEYED BY J. Smith DATE 8-62  
 DRAWN BY L. Dierks DATE 9-62  
 TRACED BY SPS DATE 11-62  
 MILTON-COLCHESTER  
 PROJ. F. NO. 028-1(3)  
 SHEET 3 OF

D-7