


PLAN
 SURVEYED BY: [blank]
 DRAWN BY: [blank]
 CHECKED BY: [blank]
 DATE: [blank]

PROFILE
 SURVEYED BY: [blank]
 DRAWN BY: [blank]
 CHECKED BY: [blank]
 DATE: [blank]

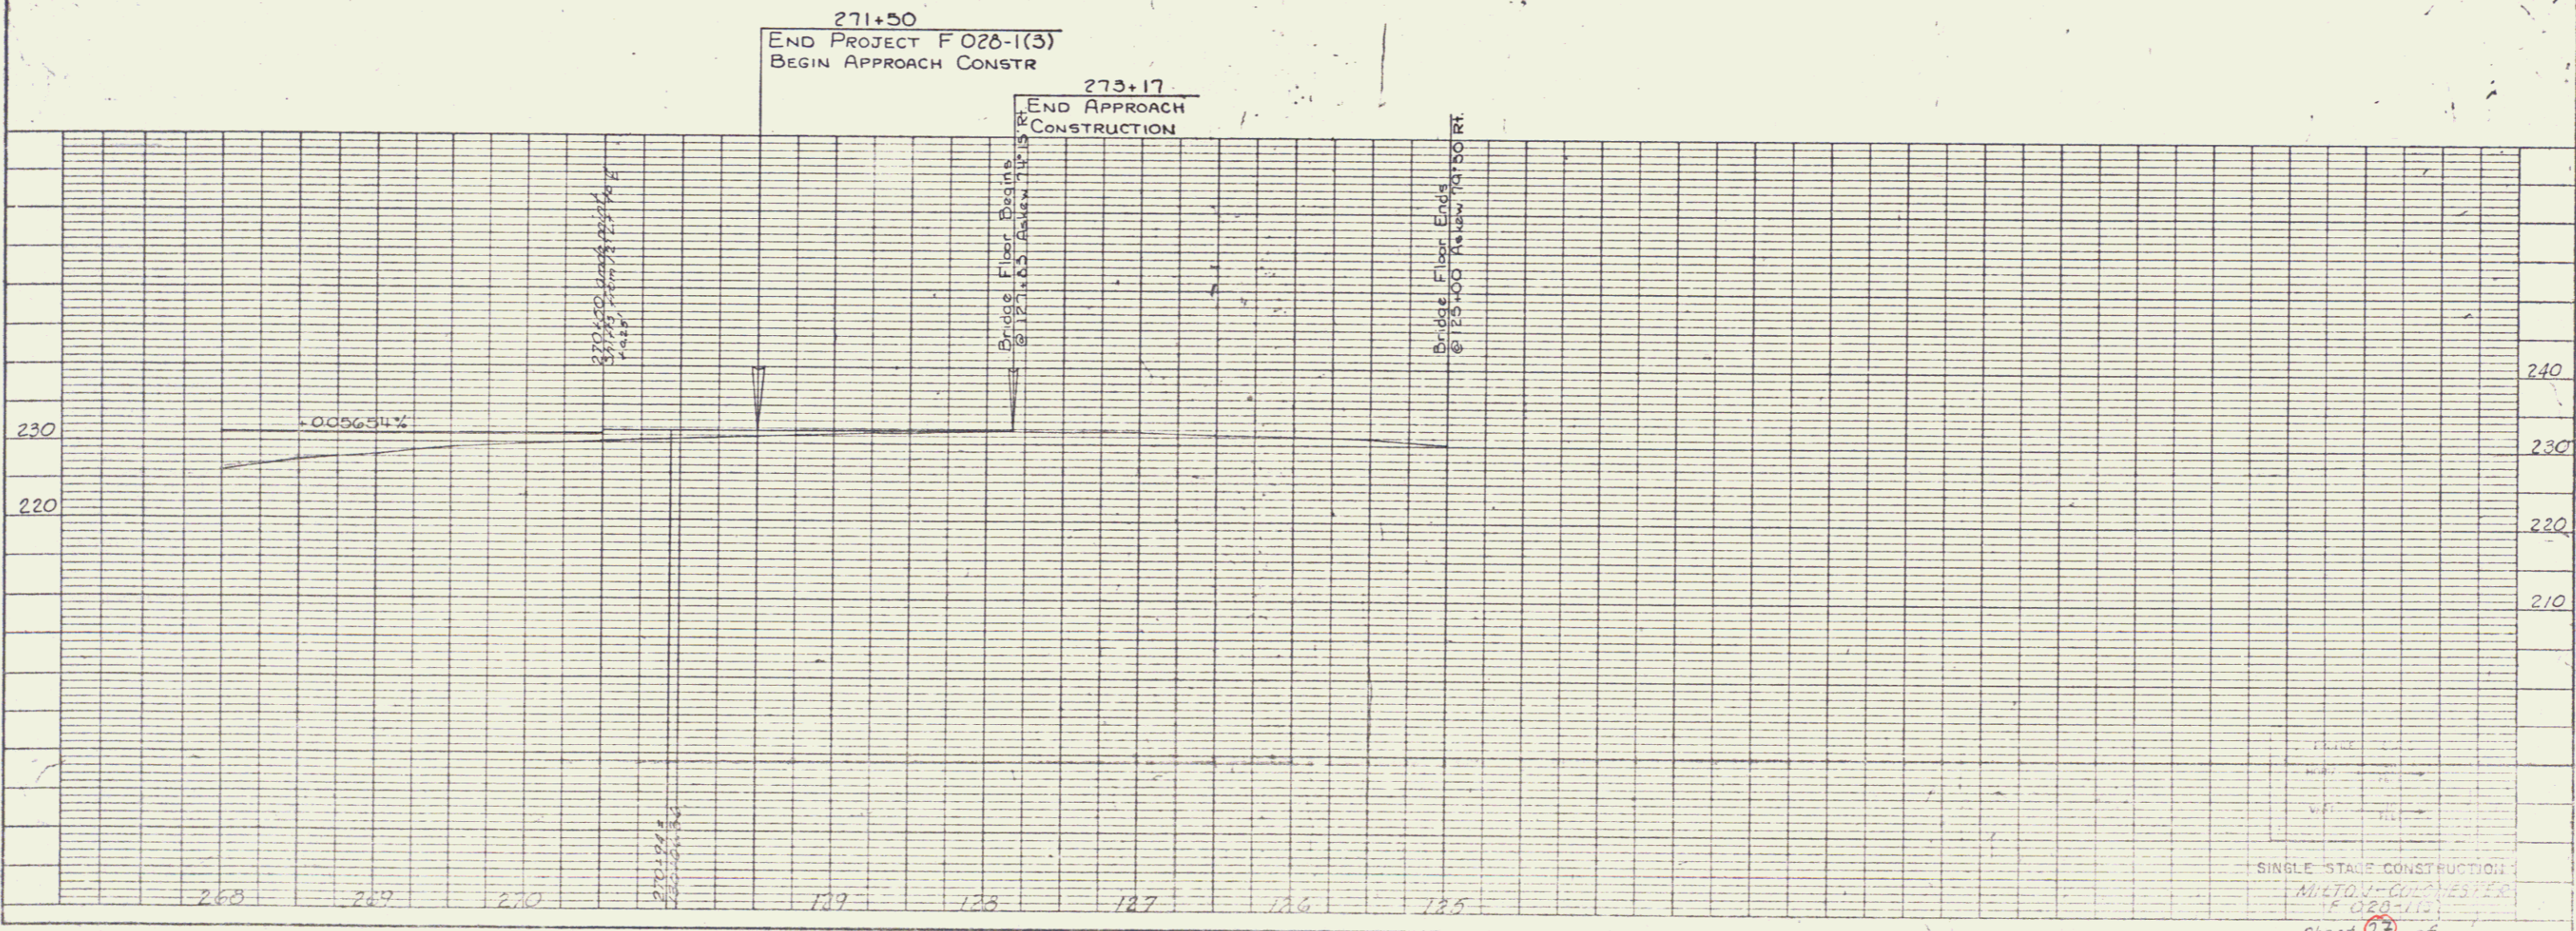

SINGLE STAGE CONSTRUCTION
 MICOTON-COLUMBIA
 F 026-1(3)
 SHEET 27 OF 47

K&E PLATE 1, PLAN PROFILE
 HAYES & COE CO.

47