

Xtaset

INDEX OF SHEETS




STATE OF VERMONT
AGENCY OF TRANSPORTATION



FEDERAL AID PRIMARY

PROPOSED IMPROVEMENT
TOWN OF ST. JOHNSBURY
COUNTY OF CALEDONIA
U. S. ROUTE 2

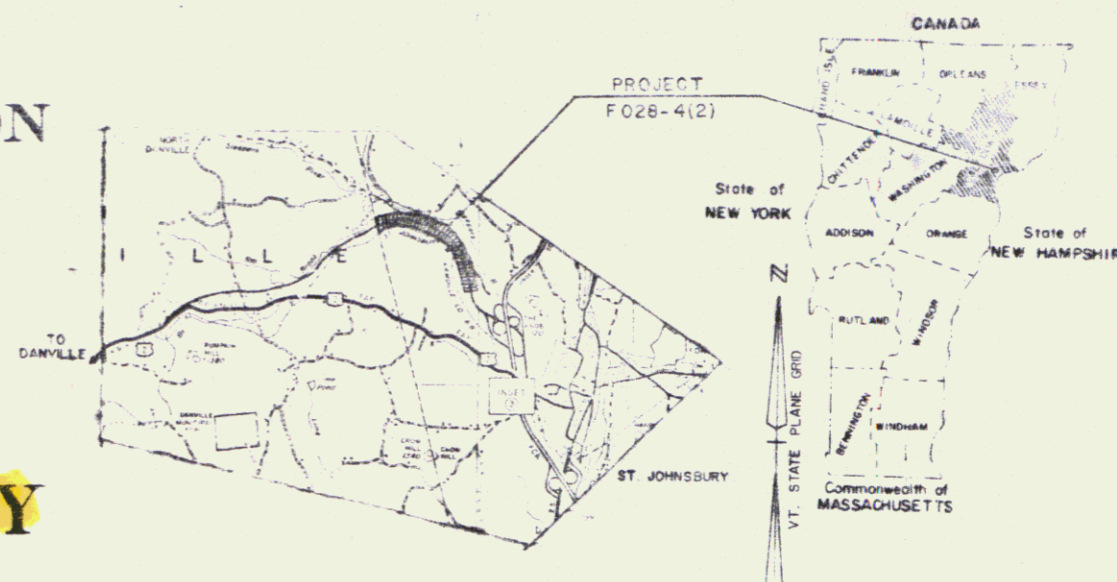

ROW PLANS


BEGINNING AT A POINT ON RELOCATED U.S. 2 AT THE DANVILLE-ST. JOHNSBURY TOWN LINE AND EXTENDING EASTERLY 1.150 MILES TO THE NORTH DANVILLE ROAD (U.S. CONNECTOR).

LENGTH OF ROADWAY 6,073.28 FEET = 1.150 MILES
LENGTH OF PROJECT 6,073.28 FEET = 1.150 MILES
THIS PROJECT INCLUDES GRADING, DRAINAGE, SUBBASE, AND PAVEMENT FOR A U.S. HIGHWAY ON NEW LOCATION
LENGTH OF R.O.W. PROJECT 5288.00 FEET = 1.002 MILES

TRAFFIC DATA	
1983 AADT	3440
2003 AADT	6060
2003 DHV	770
D	52%
T	3%
V	60 MPH

END R.O.W. PROJECT
F028-4(2) STA. 1769+77 (338' LT.)

- CONVENTIONAL SIGNS
- COUNTY LINE
 - TOWN LINE
 - LIMITS OF ACCESS
 - POINT OF ACCESS
 - FENCE LINE
 - STONE WALL
 - TRAVELED WAY
 - GUARD RAIL
 - RAILROAD
 - SURVEY LINE
 - CULVERT
 - POWER POLE
 - TELEPHONE POLE
 - VEES
 - CONTROL OF ACCESS
 - PROPERTY LINE
 - R.O.W. TAKING LINE
 - SLOPE RIGHTS
 - TOP OF CUT
 - TOE OF SLOPE

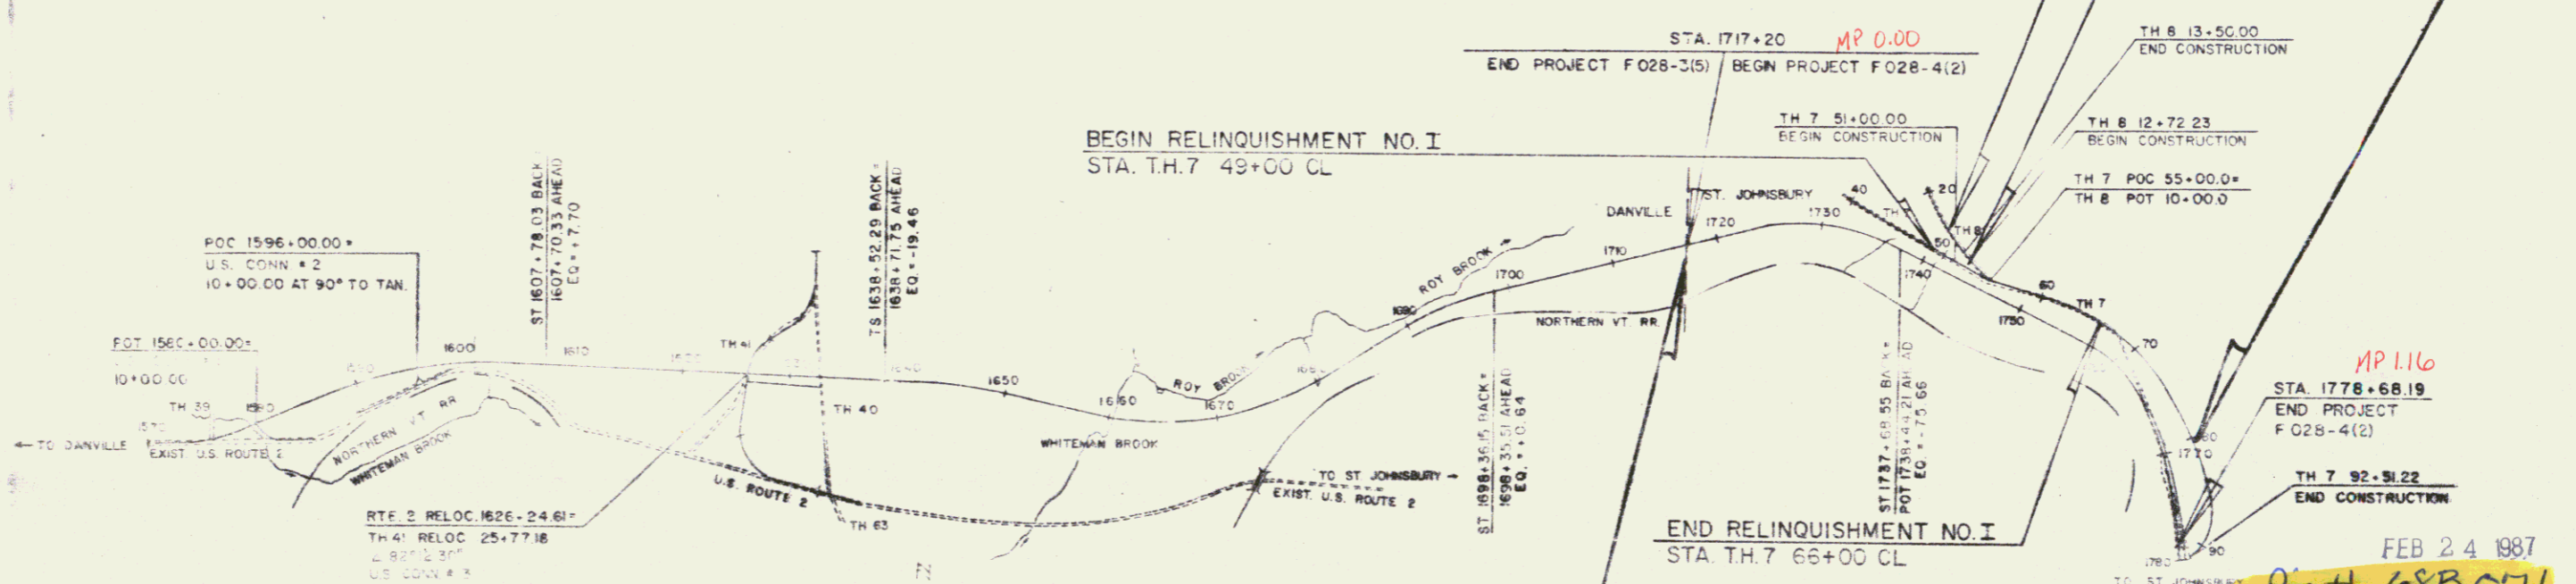

BEGIN R.O.W. PROJECT
F028-4(2) STA. 1716+89 120' RT.

END RELINQUISHMENT NO. I
STA. TH. 7 66+00 CL

BEGIN RELINQUISHMENT NO. II
STA. TH. 8 12+72 CL

END RELINQUISHMENT NO. II
STA. TH. 8 16+00 CL

STA. 1717+20 MP 0.00
END PROJECT F028-3(5) BEGIN PROJECT F028-4(2)

TH 8 13+50.00
END CONSTRUCTION

TH 7 51+00.00
BEGIN CONSTRUCTION

TH 8 12+72.23
BEGIN CONSTRUCTION

TH 7 POC 55+00.00
TH 8 POT 10+00.00

MP 1.16
STA. 1778+68.19
END PROJECT
F028-4(2)

TH 7 92+51.22
END CONSTRUCTION

FEB 24 1987

Pin# 688071

These plans are subject to such engineering changes as may be required by the Federal Highway Admin. or the Director of Engineering and Construction.

APPROVED: *[Signature]*
DATE: *May 25, 1982*

CHIEF PROPERTY ADMINISTRATION

PROJECT: F 028-4(2)
SHEET: 1 OF 25 SHEETS