


Note: SB Grade line shift from ϕ at Sta 1131+30.00 to 2' Lt. of ϕ at Sta 1133+44.10.

ALL DRIVES AS INDICATED ON PLANS ARE SUBJECT TO PERMITS PURSUANT TO TITLE 19 SECTION 43, VSA

WOVEN WIRE FENCE SB 1130+00-1146+00 LK 141

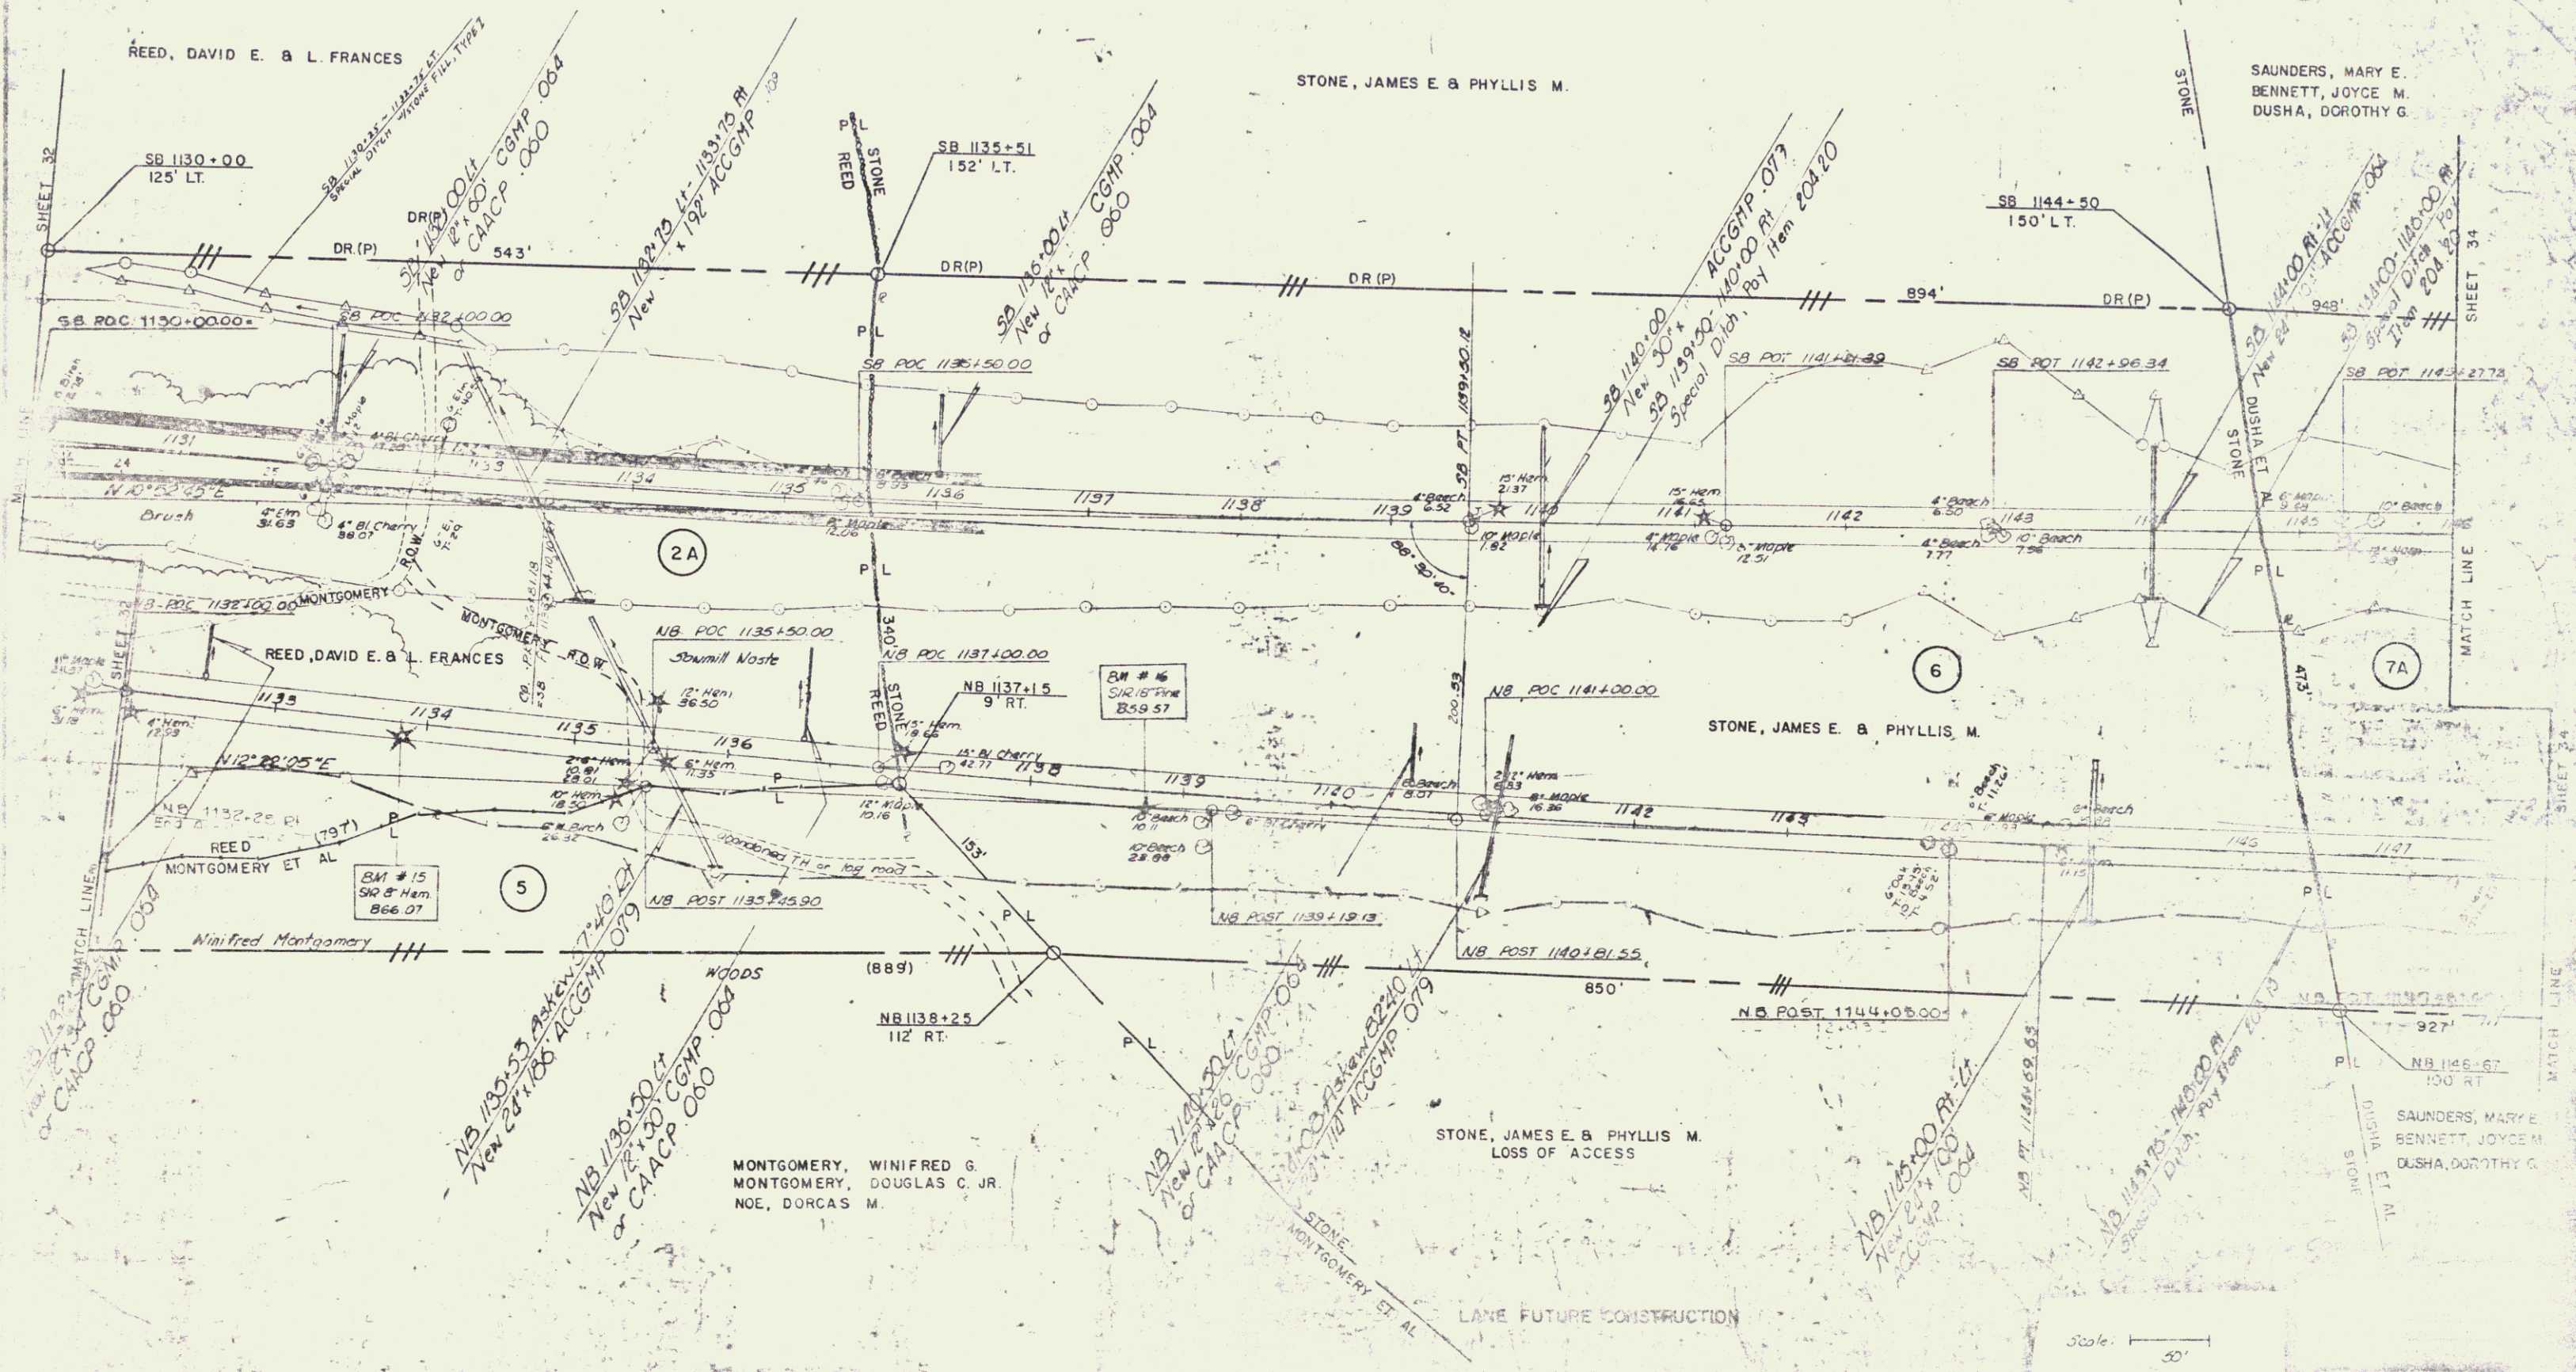

Scale 1" = 50'