


ALL DRIVES AS INDICATED ON PLANS ARE SUBJECT TO PERMITS PURSUANT TO TITLE 19 SECTION 43, V.S.A.

MARY E SAUNDERS
JOYCE BENNETT
DOROTHY DUSHA

TOWN OF ARLINGTON

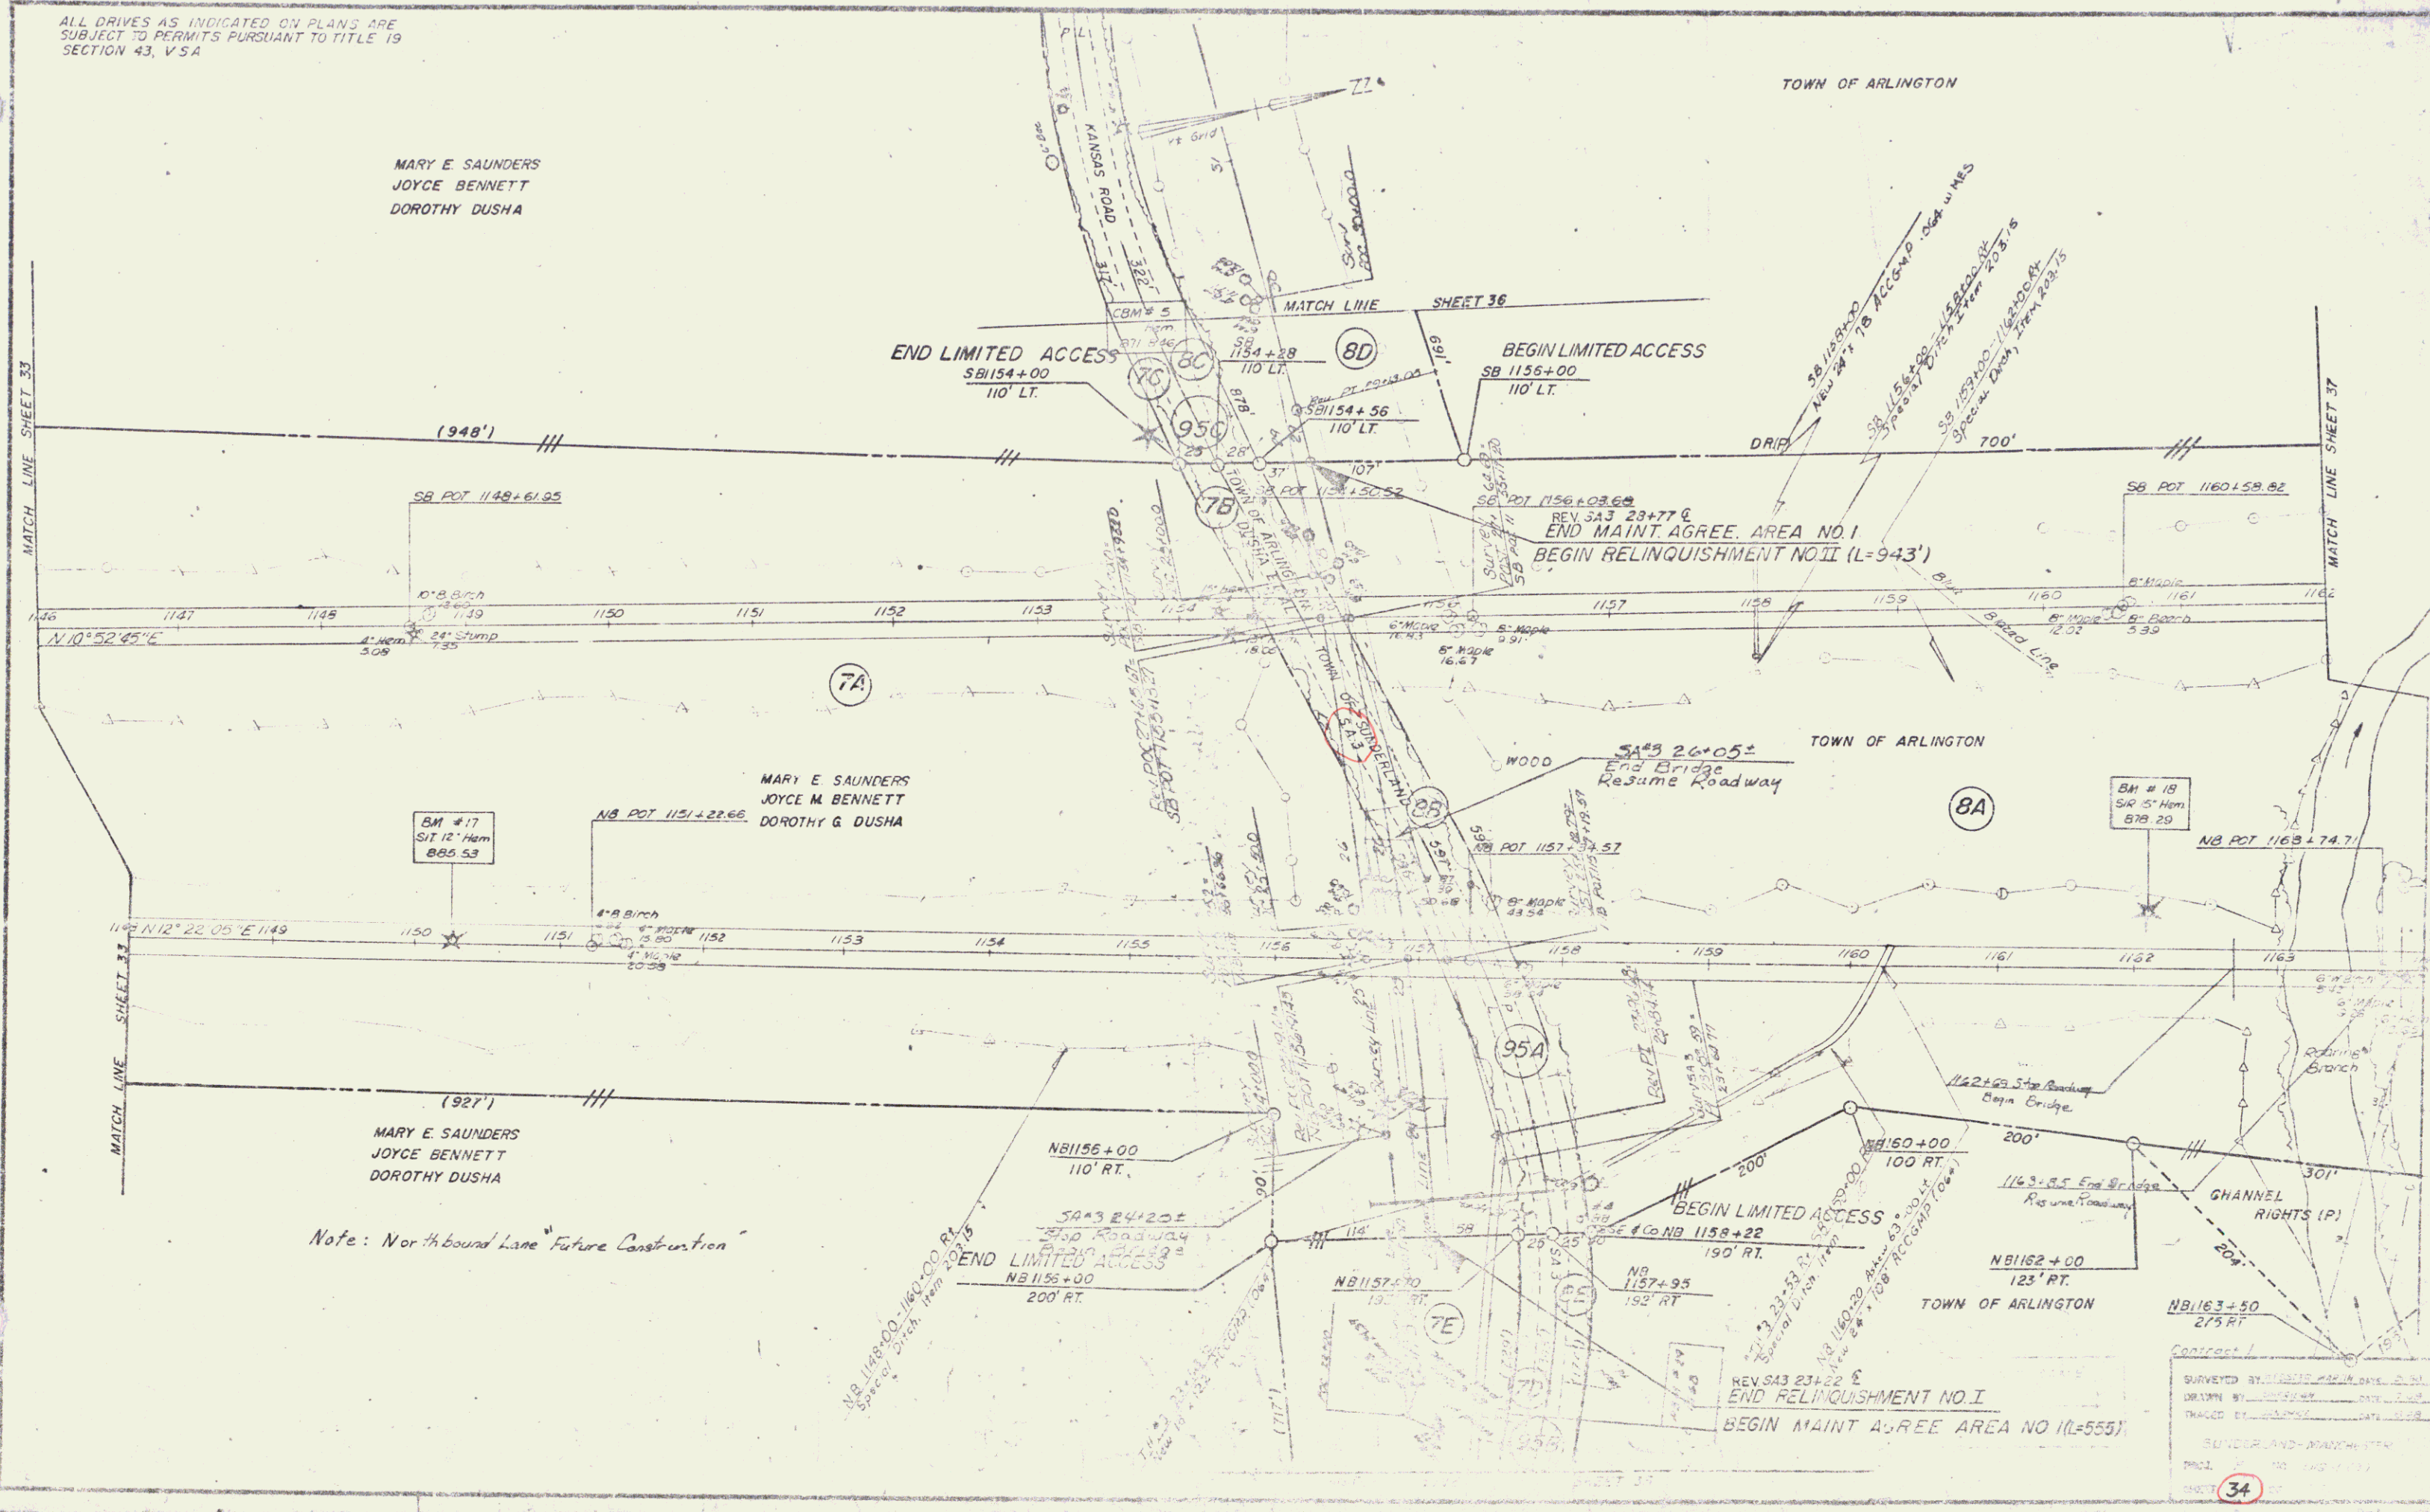

MATCH LINE SHEET 33

MATCH LINE SHEET 36

MATCH LINE SHEET 37

MATCH LINE SHEET 34

MATCH LINE SHEET 37

Note: Northbound Lane Future Construction

SURVEYED BY	DATE
DRAWN BY	DATE
TRACED BY	DATE
SUBSCRIBED AND MANAGED BY	
PROJ. NO.	
SHEET	34