



PLAN
 NOTE BOOK
 NO.

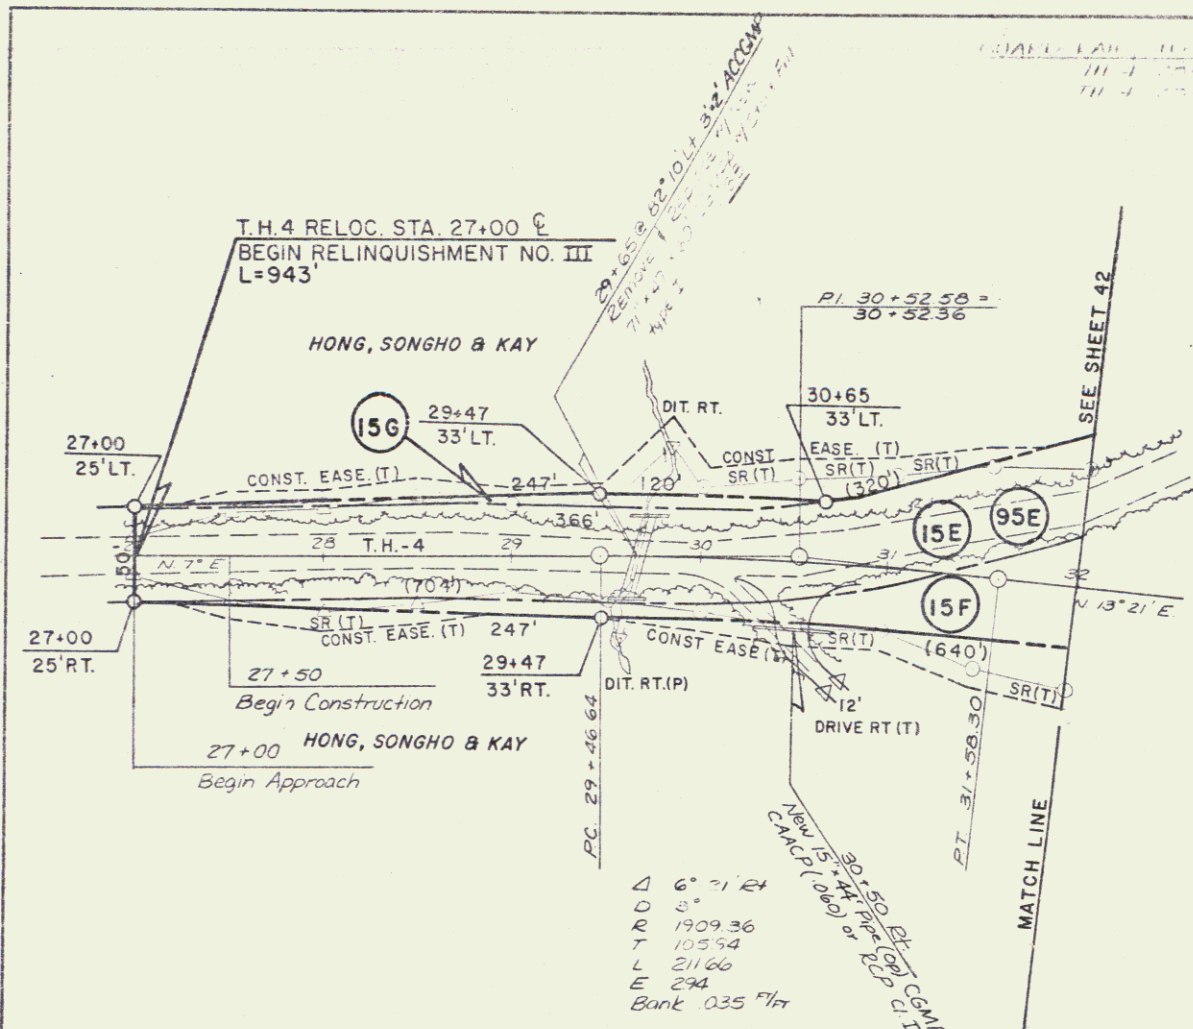


ALL DRIVES AS INDICATED ON PLANS ARE SUBJECT TO PERMITS PURSUANT TO TITLE 19, SECTION 43, V.S.A.

T.H.4 RELOC. STA. 41+58
 END MAINT. AGREE. AREA NO. 2
 BEGIN RELINQUISHMENT NO. IV
 L=342'

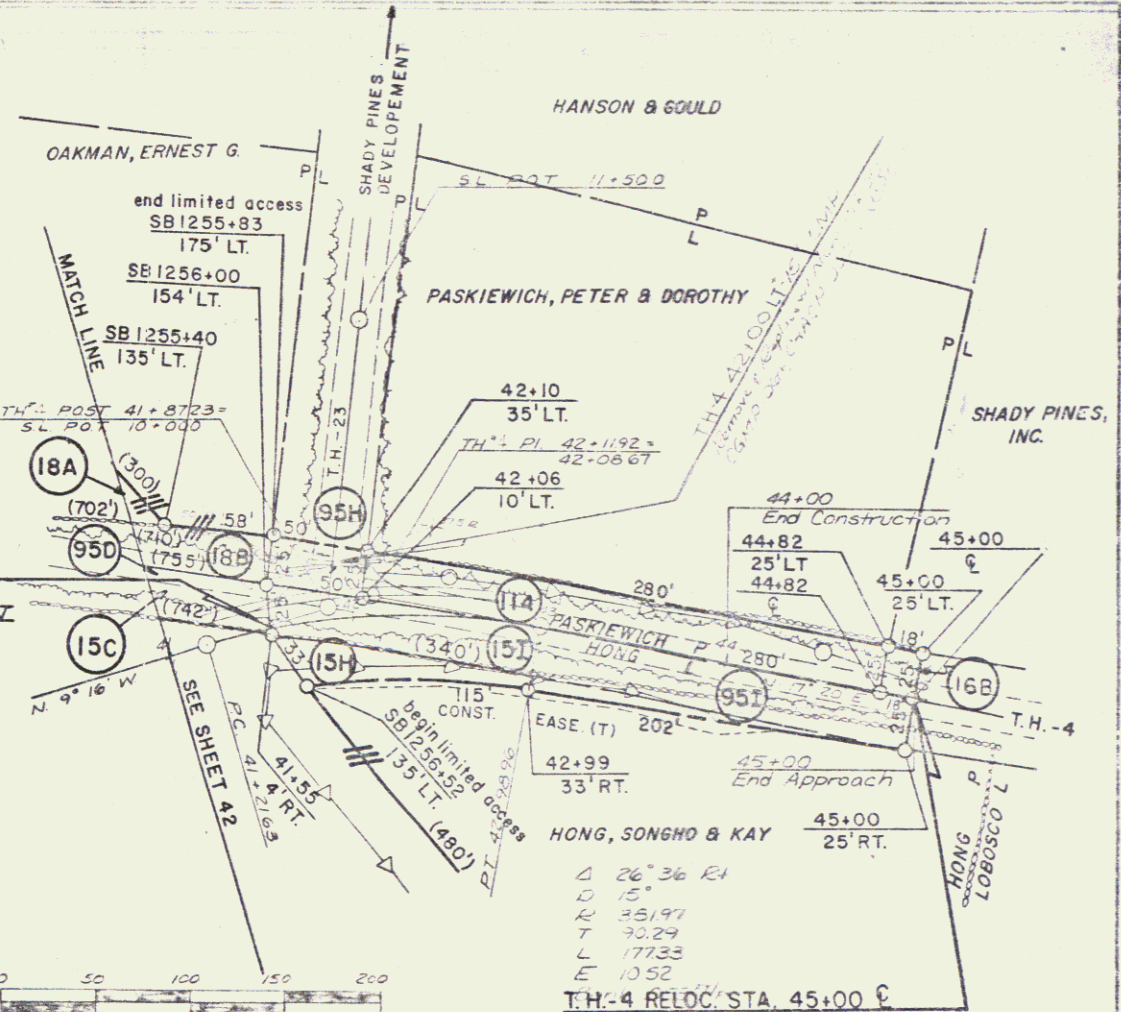

PROFILE
 NOTE BOOK
 NO.

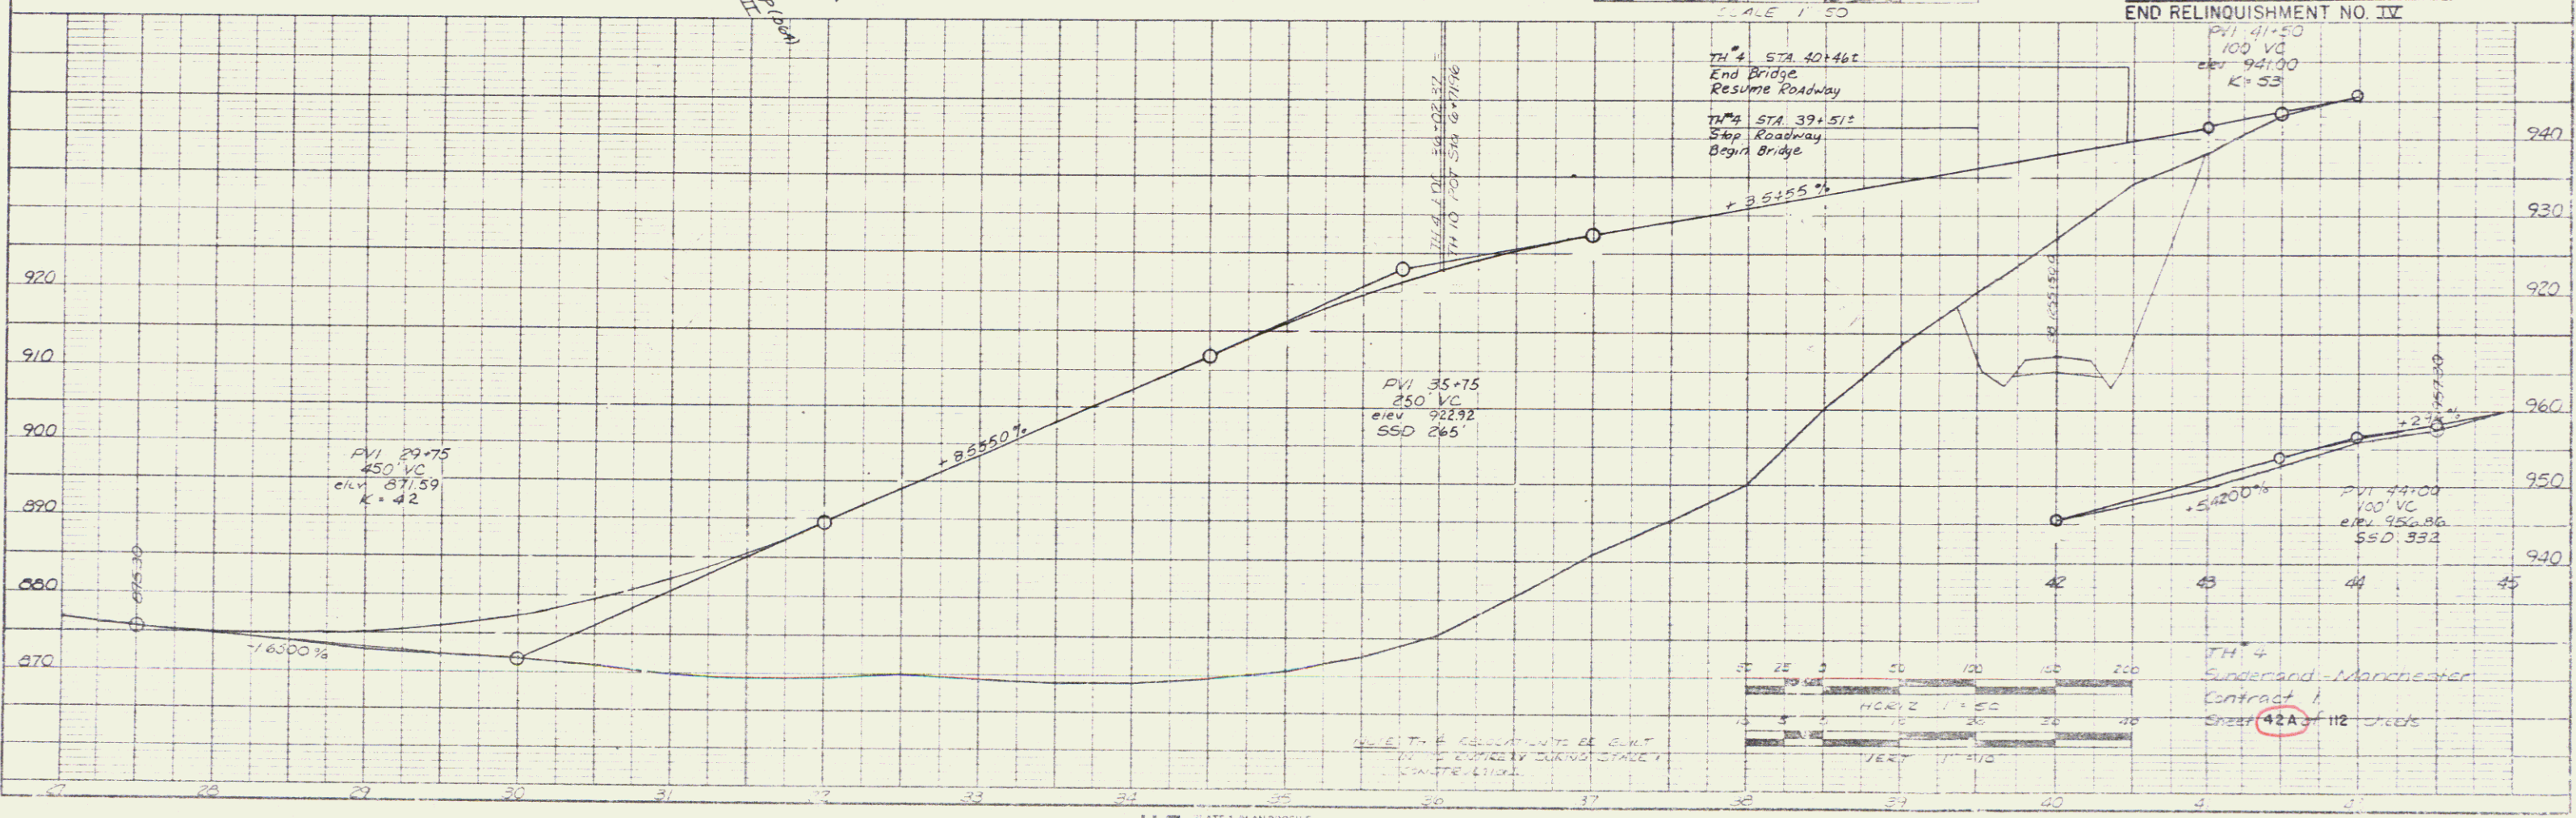

K&E DATE 1 PLAN PROFILE
 K&E & ASSOCIATES
 4001 N. W. 11th St. Ft. Lauderdale, FL 33309