


ALL DRIVES AS INDICATED ON PLANS ARE
SUBJECT TO PERMITS PURSUANT TO TITLE 19
SECTION 43, V.S.A.

CARL H. & RUTH F. WHITE.

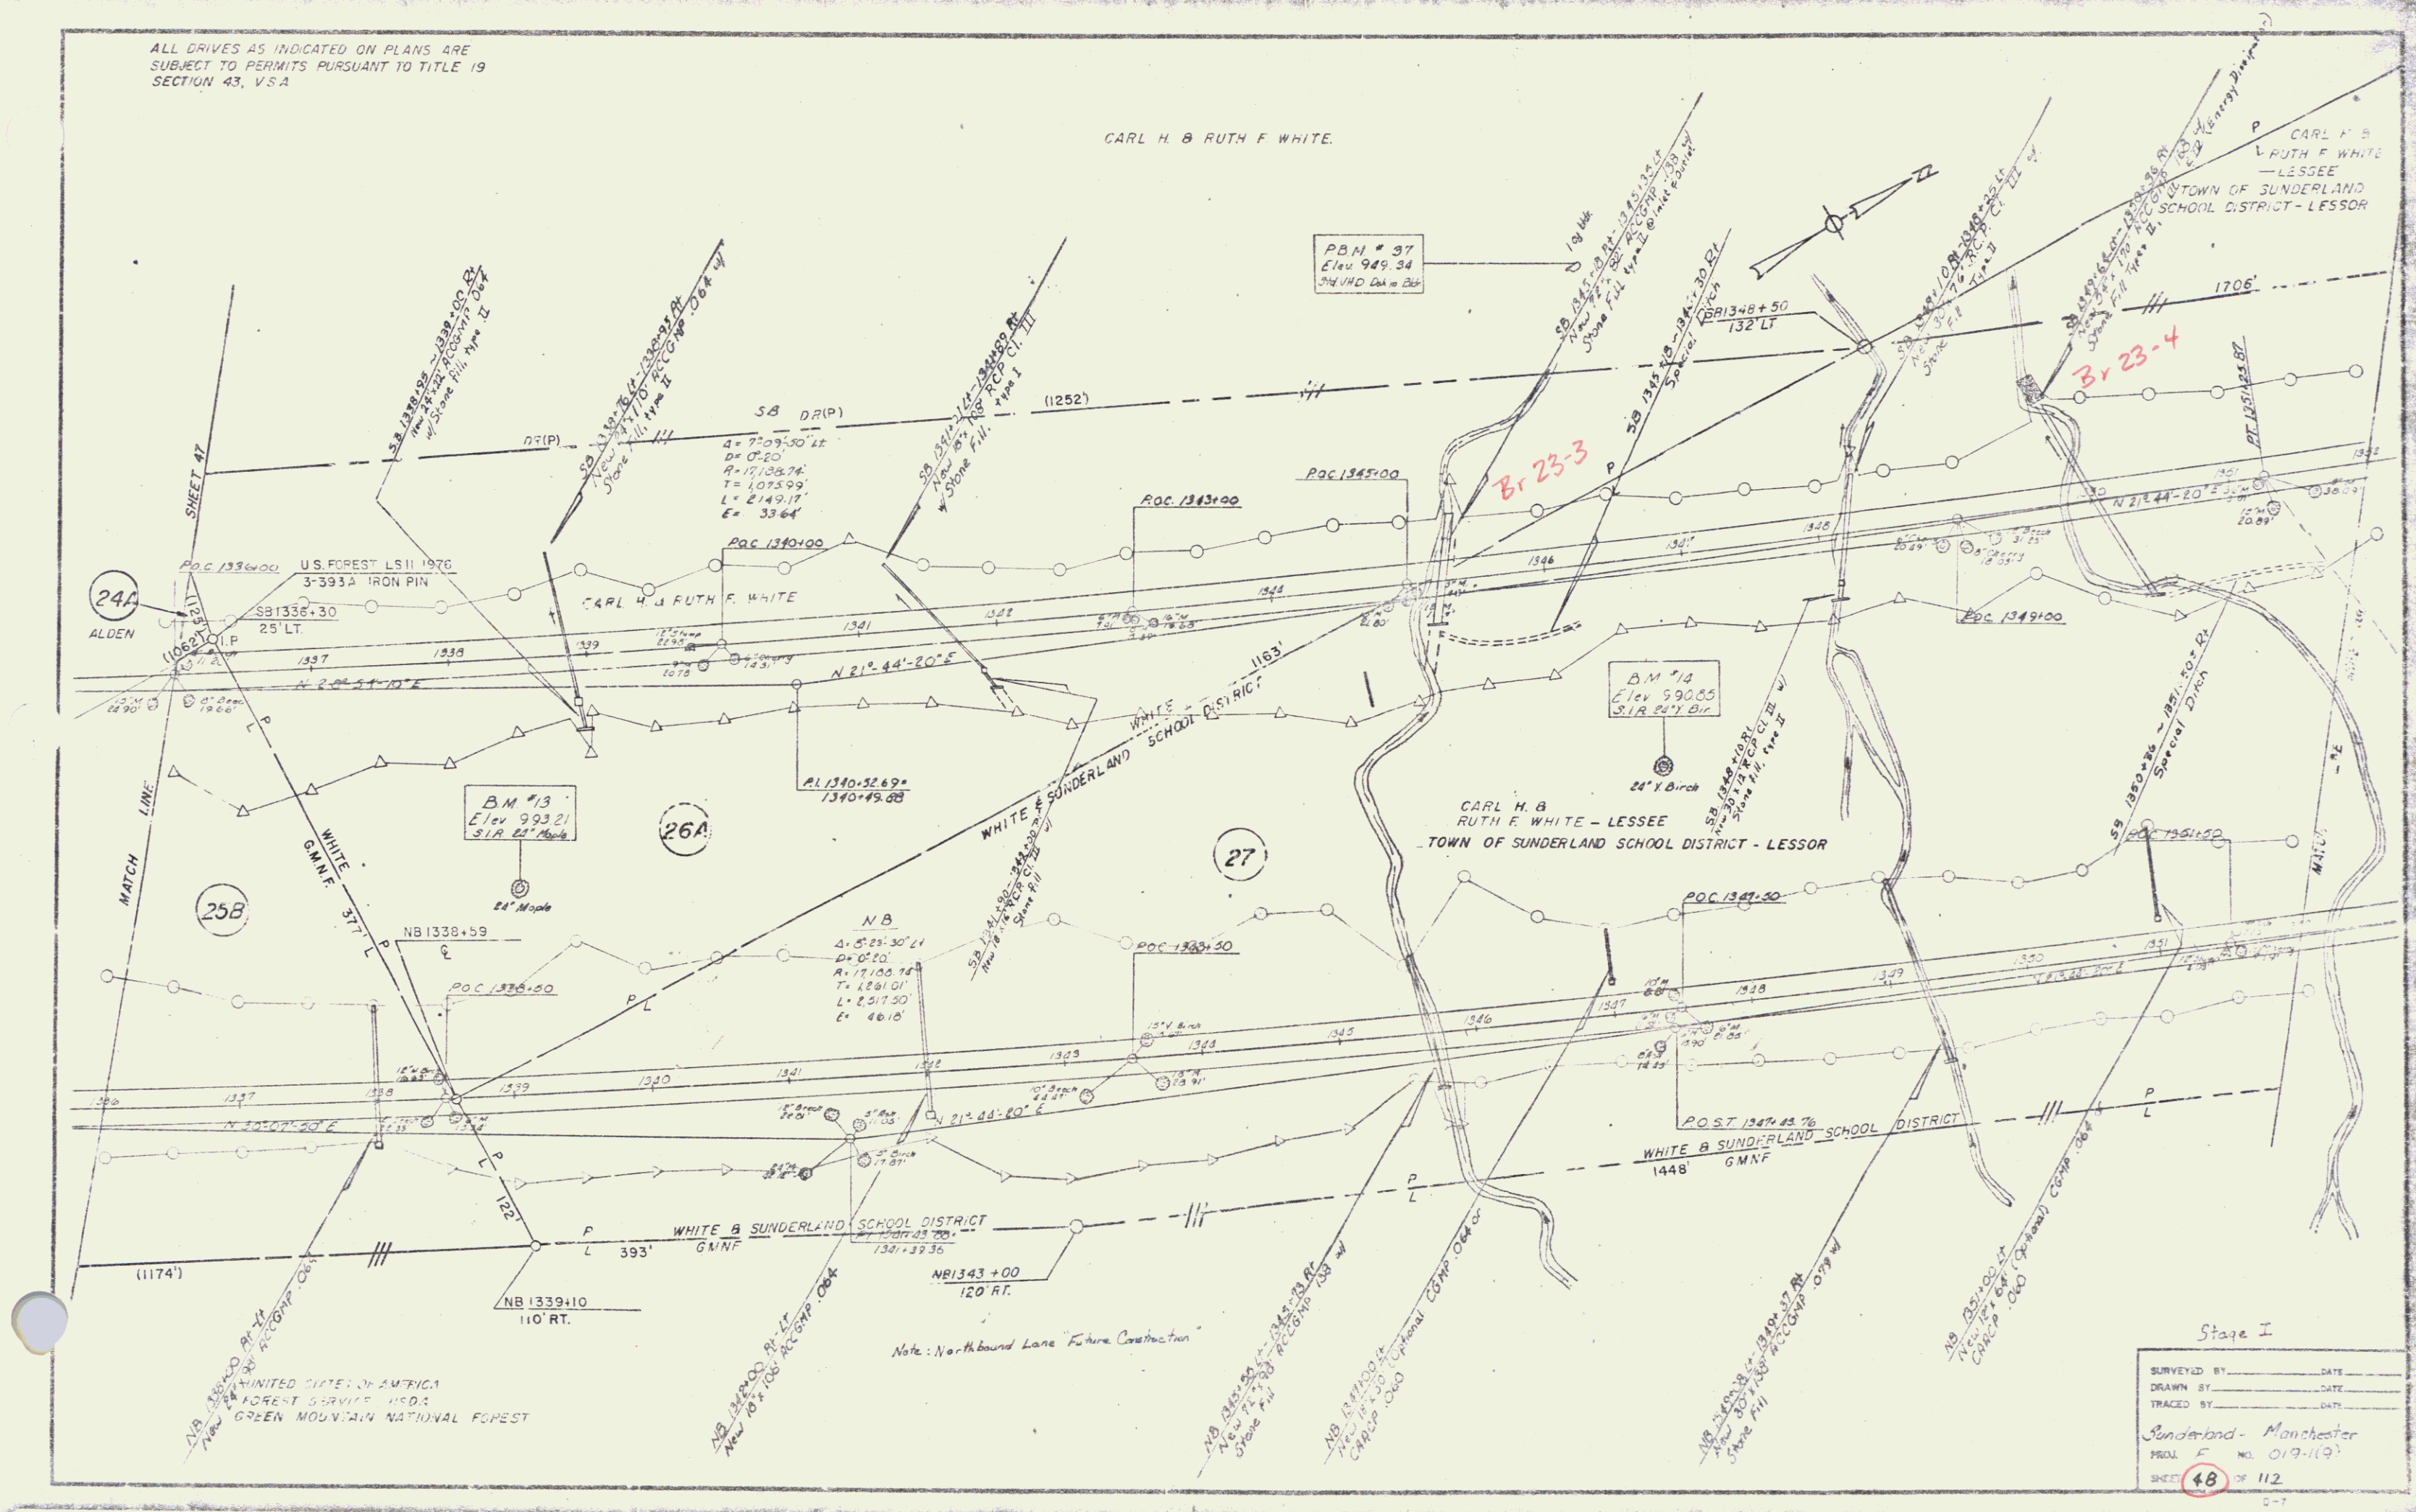

Stage I

SURVEYED BY	DATE
DRAWN BY	DATE
TRACED BY	DATE

Sunderland - Manchester
 PROJ. F. NO. 017-119
 SHEET **48** OF 112
 0-7