


ALL DRIVES AS INDICATED ON PLANS ARE
SUBJECT TO PERMITS PURSUANT TO TITLE 19
SECTION 43, V.S.A.

Stone Fill
Type Item 613
NB 1444+00 - 1444+90 Rt
NB 1444+50 - 1445+15 Rt

Life Mattings Item 63410
NB 1435+05 - 1436+05 Rt
NB 1439+00 - 1444+00 Rt
NB 1446+00 - 1449+00 Rt

Treated Timber Curb
Item 61635
NB 1433+00 - 1449+00 Lt

Three-Coat Guard Rail
Light Steel Posts Item 64221
NB 1433+00 - 1449+00 Lt
NB 1443+76 - 1445+84 Rt

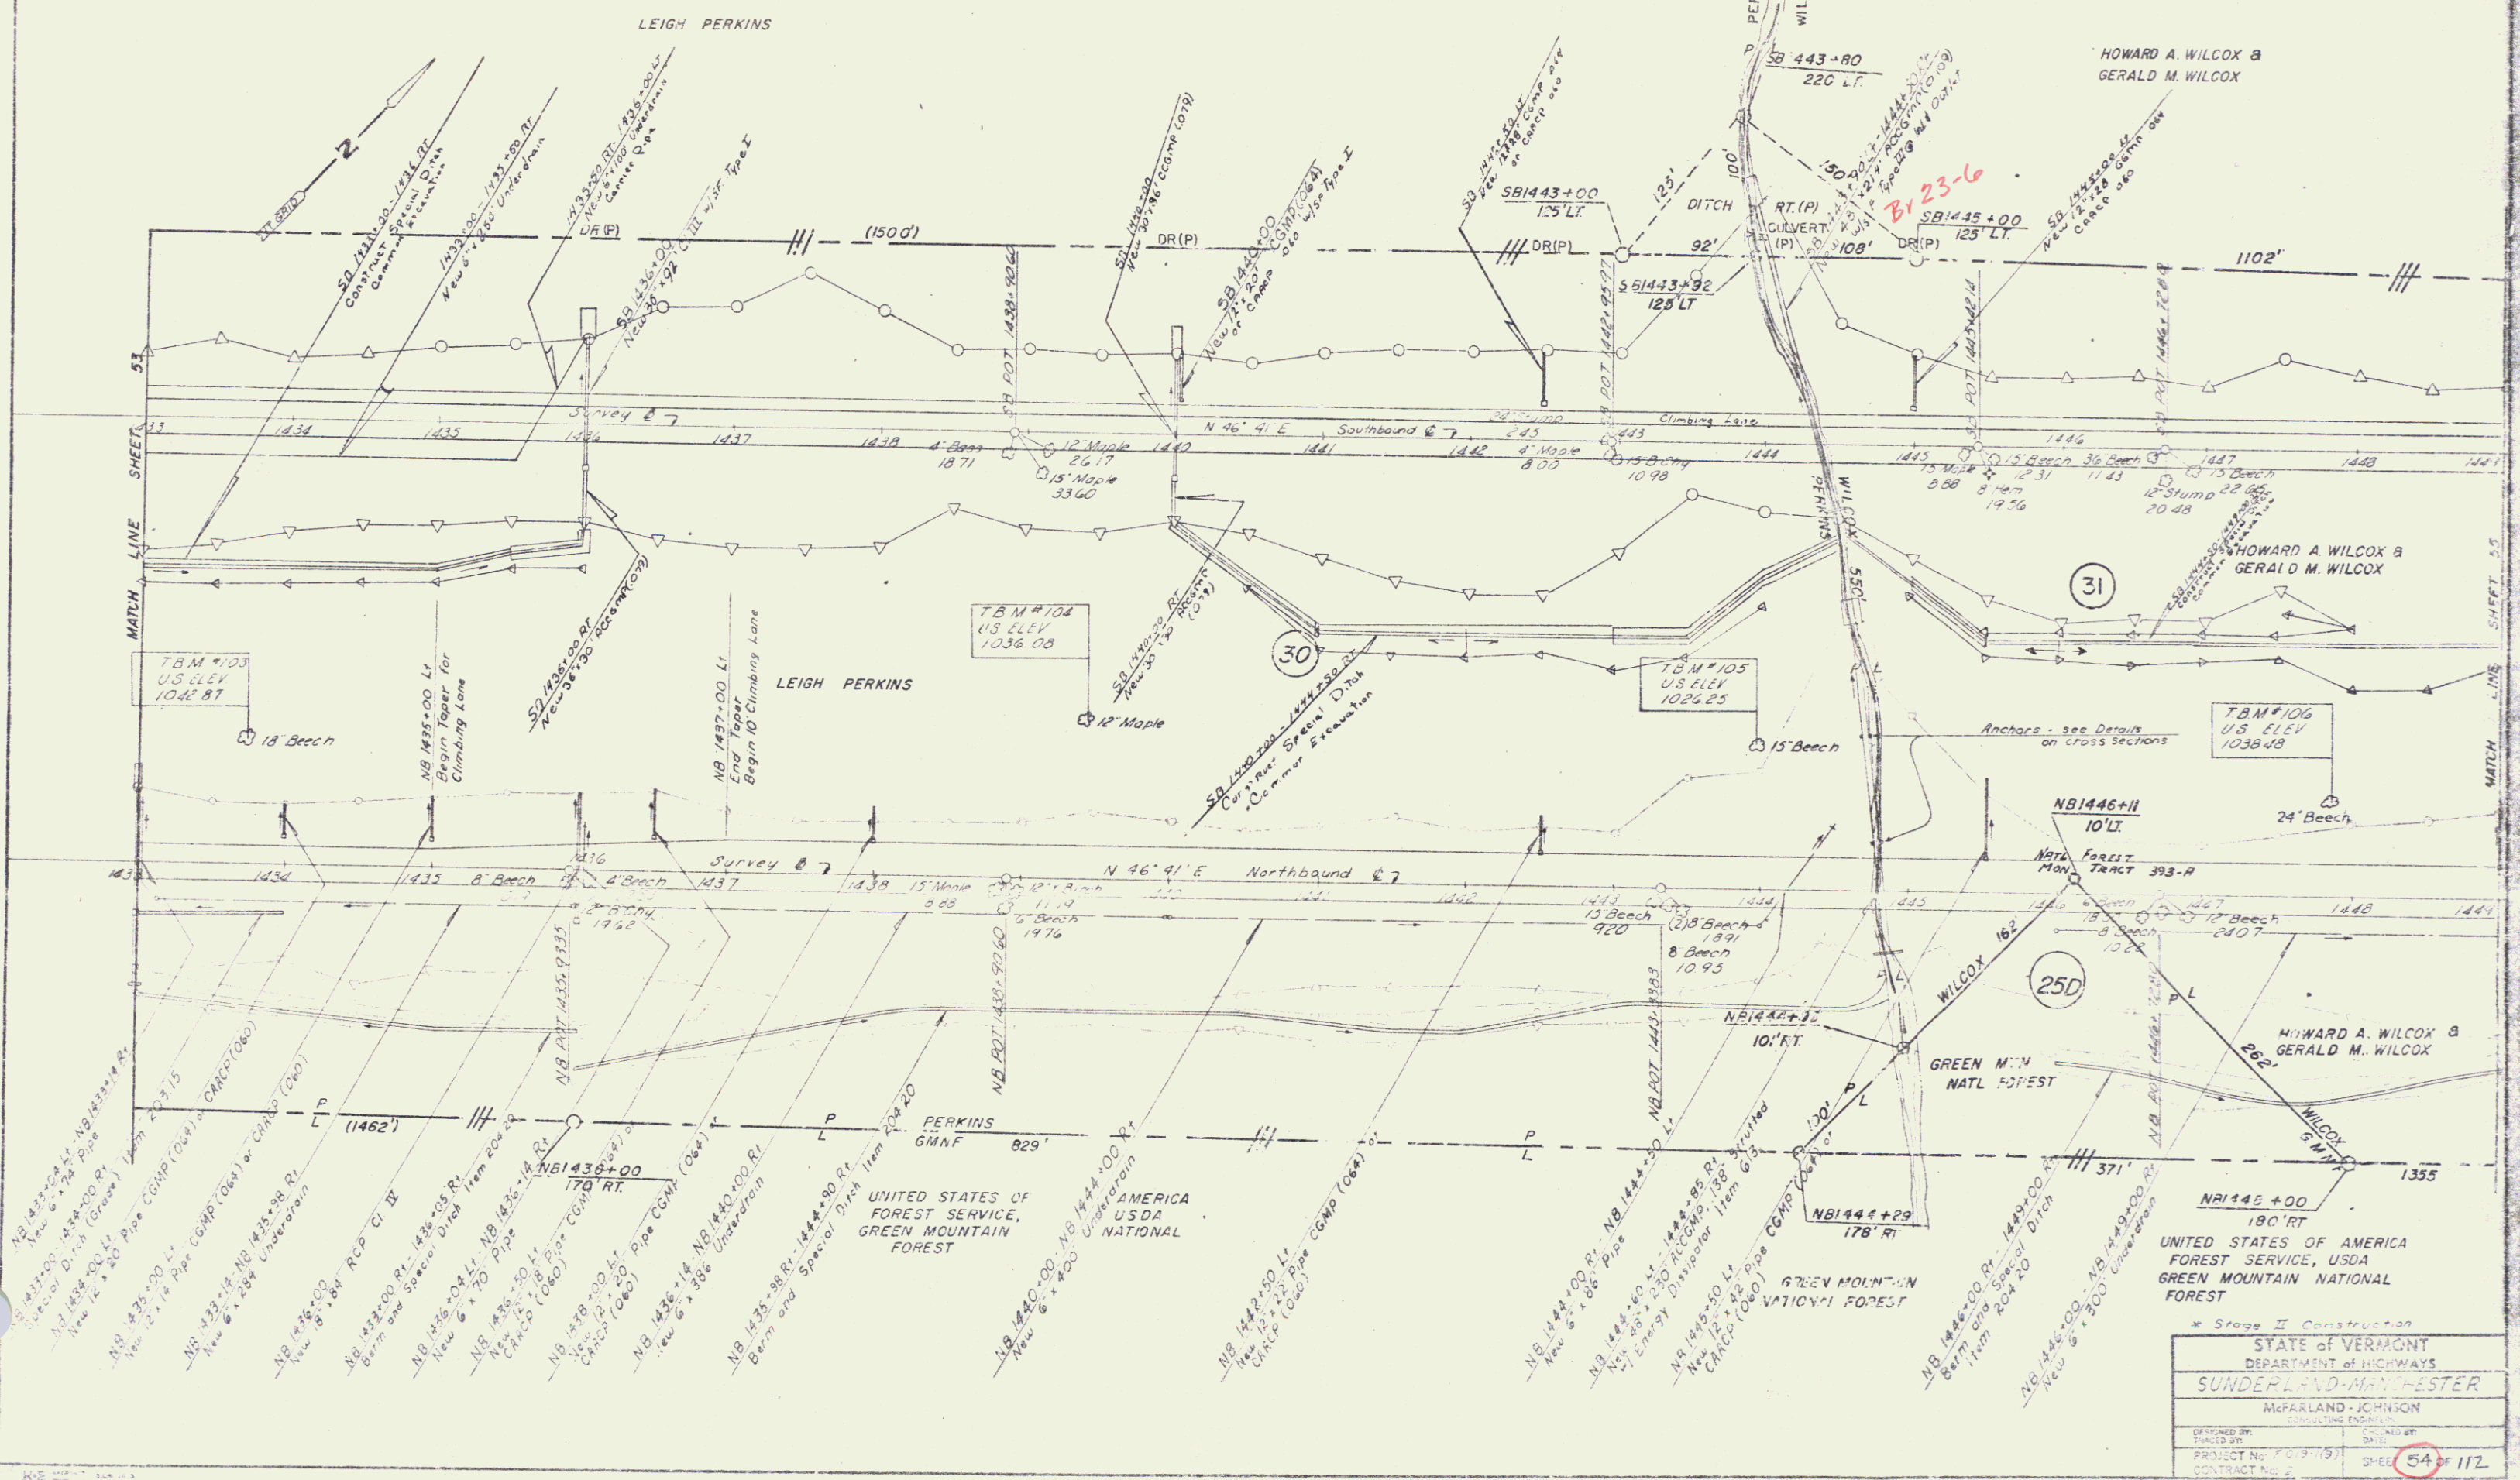

* Stage II Construction	
STATE OF VERMONT	
DEPARTMENT OF HIGHWAYS	
SUNDERLAND-MANFESTER	
MEARLAND-JOHNSON	
DESIGNED BY	DRAWN BY
PROJECT NO. 143-15	SHEET 54 OF 112
CONTRACT NO. 2	