


Demolition & disposal of existing T-27
 T-27 9+50 LT
 T-27 10+10 RT
 T-27 10+50 RT
 T-27 10+95 RT

ALL DRIVES AS INDICATED ON PLANS
 ARE SUBJECT TO PERMITS PURSUANT
 TO TITLE 19 SECTION 43, VSA

PROJECT DRIVES
 T-27 4+00 LT
 T-27 5+50 LT (APPR TO T-27)
 T-27 6+00 RT (APPR TO T-30)

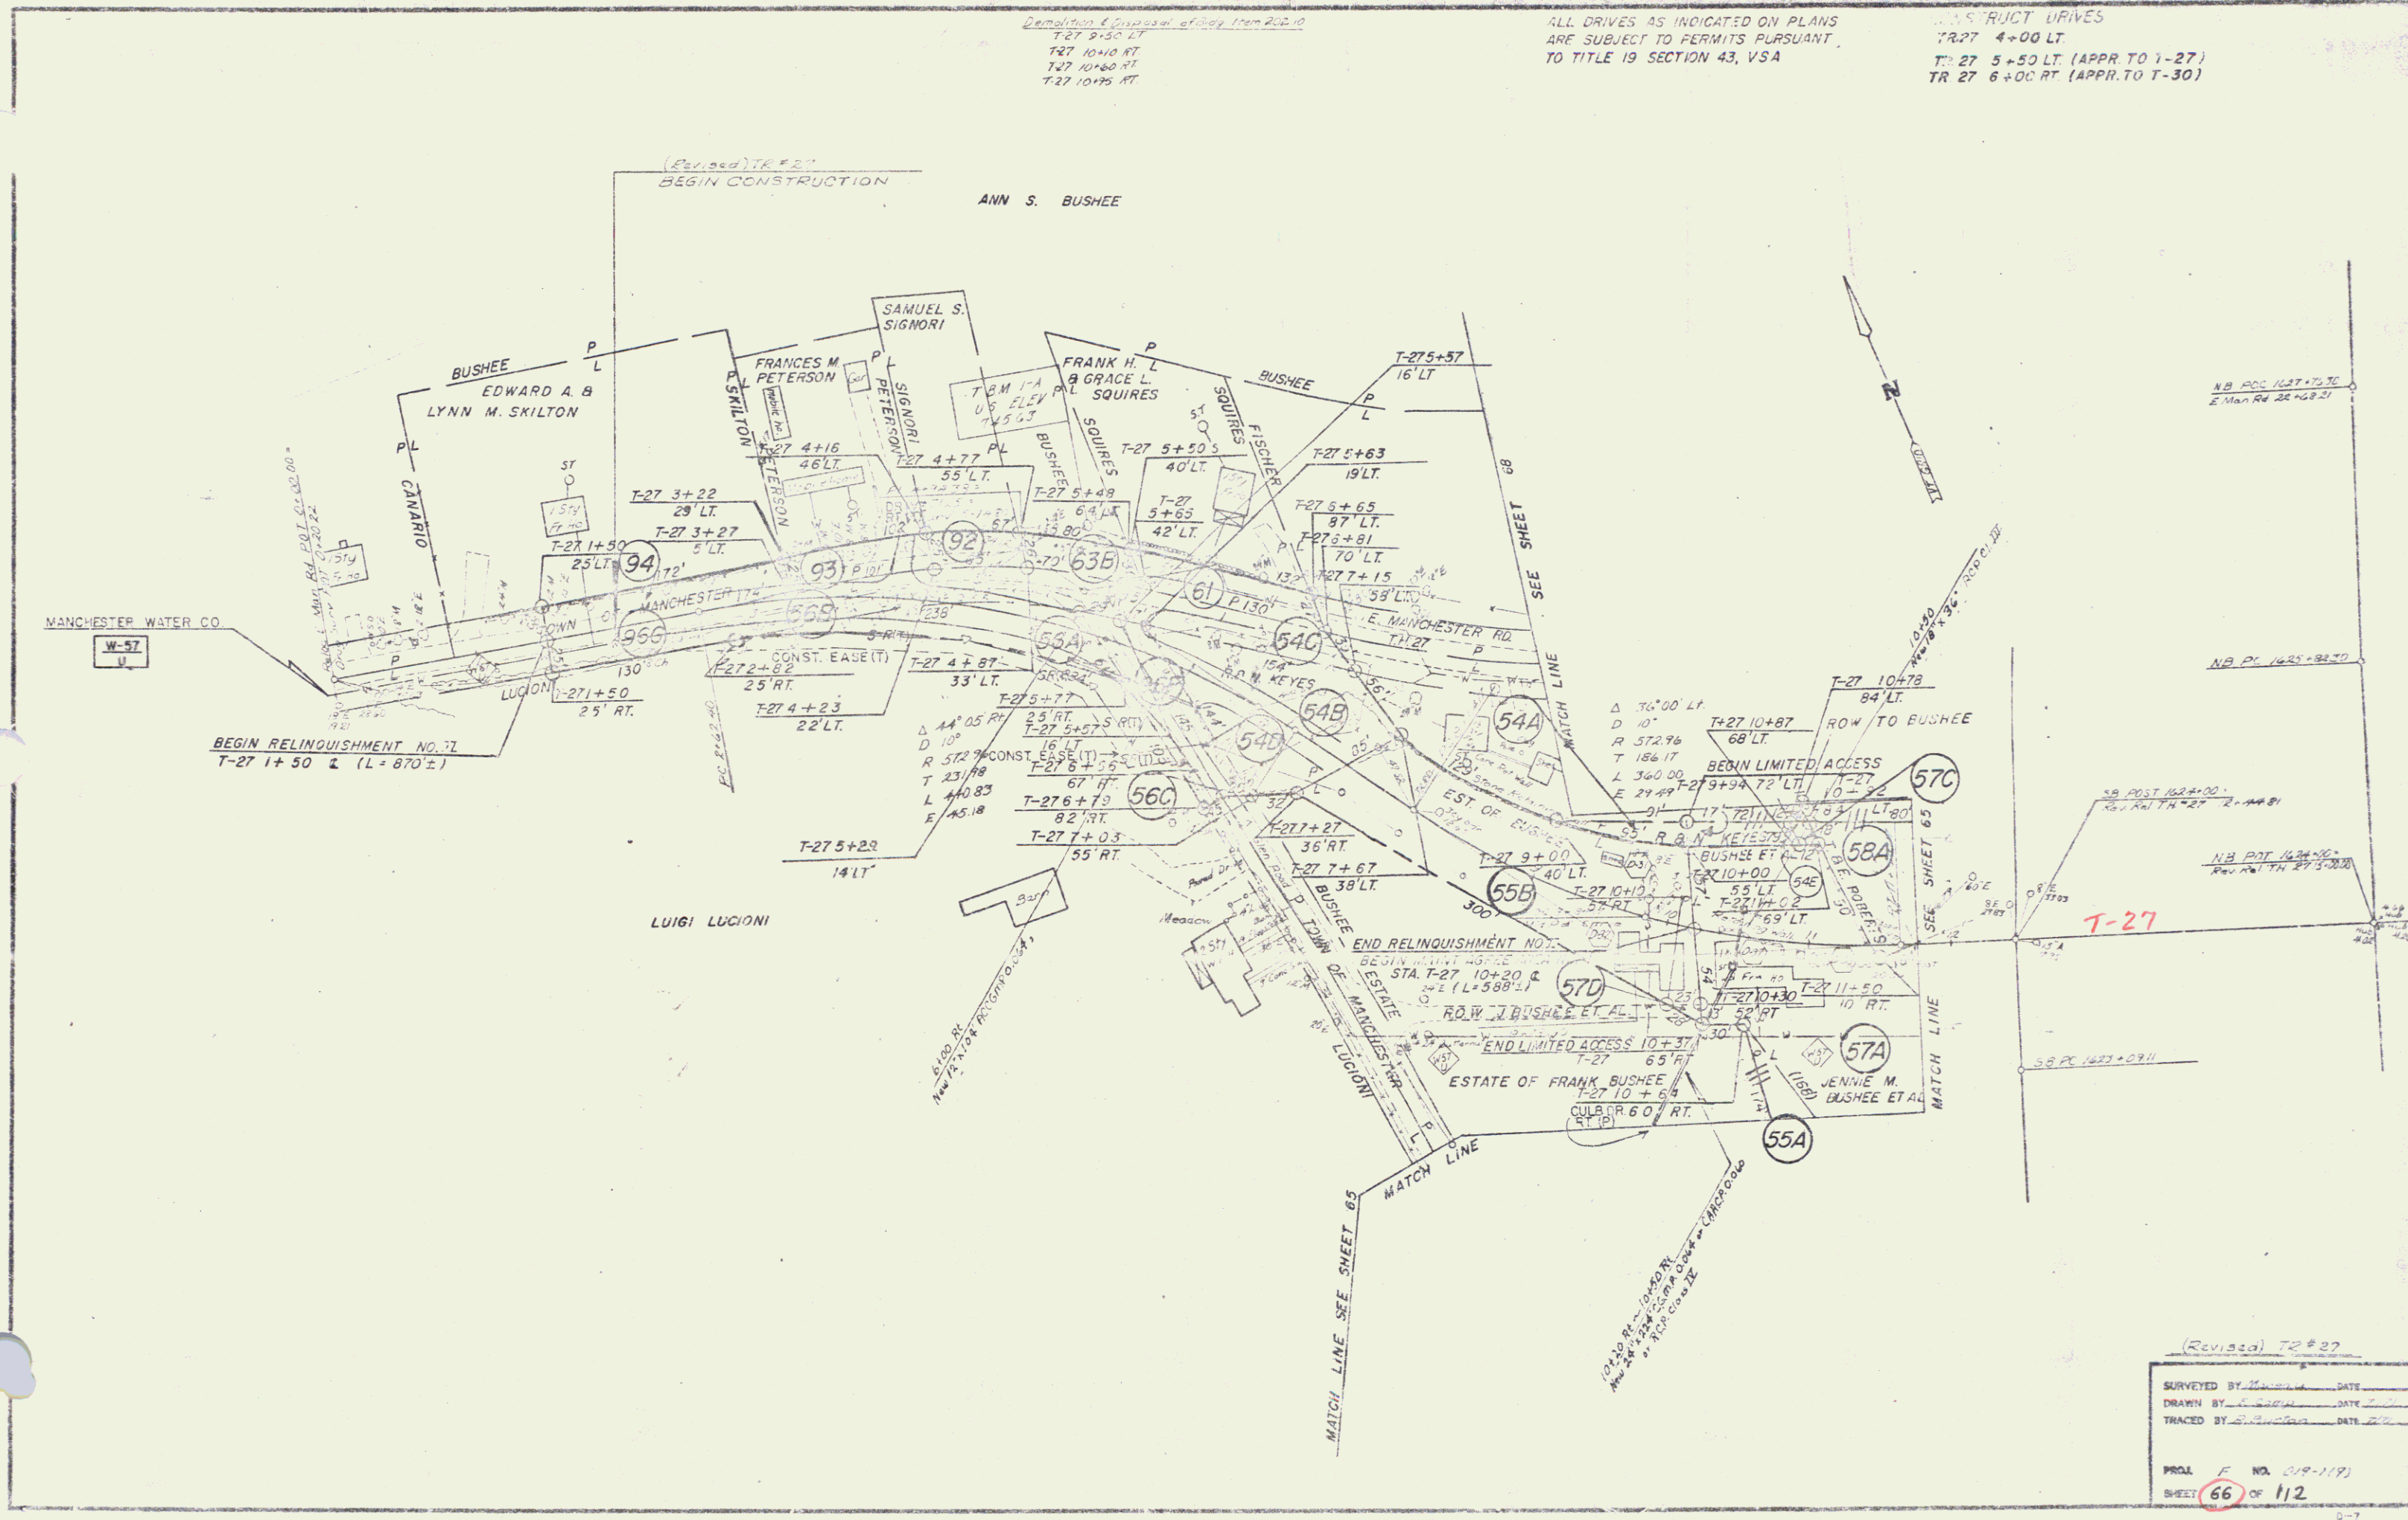

(Revised) T-27
 SURVEYED BY: _____ DATE: _____
 DRAWN BY: _____ DATE: _____
 TRACED BY: _____ DATE: _____
 PROJ. NO. 019-119
 SHEET 66 OF 112
 0-7