


INSTRUCT DRIVE  
 RELOC. TR 27 29+60 LT  
 EXIST. TR 27 33+60 RT  
 TR 27 RELOC 21+80 RT  
 RELOC. TH 27 25+37 RT (12' WIDE)

ALL DRIVES AS INDICATED ON PLANS  
 ARE SUBJECT TO PERMITS PURSUANT  
 TO TITLE 19 SECTION 43, V.S.A.

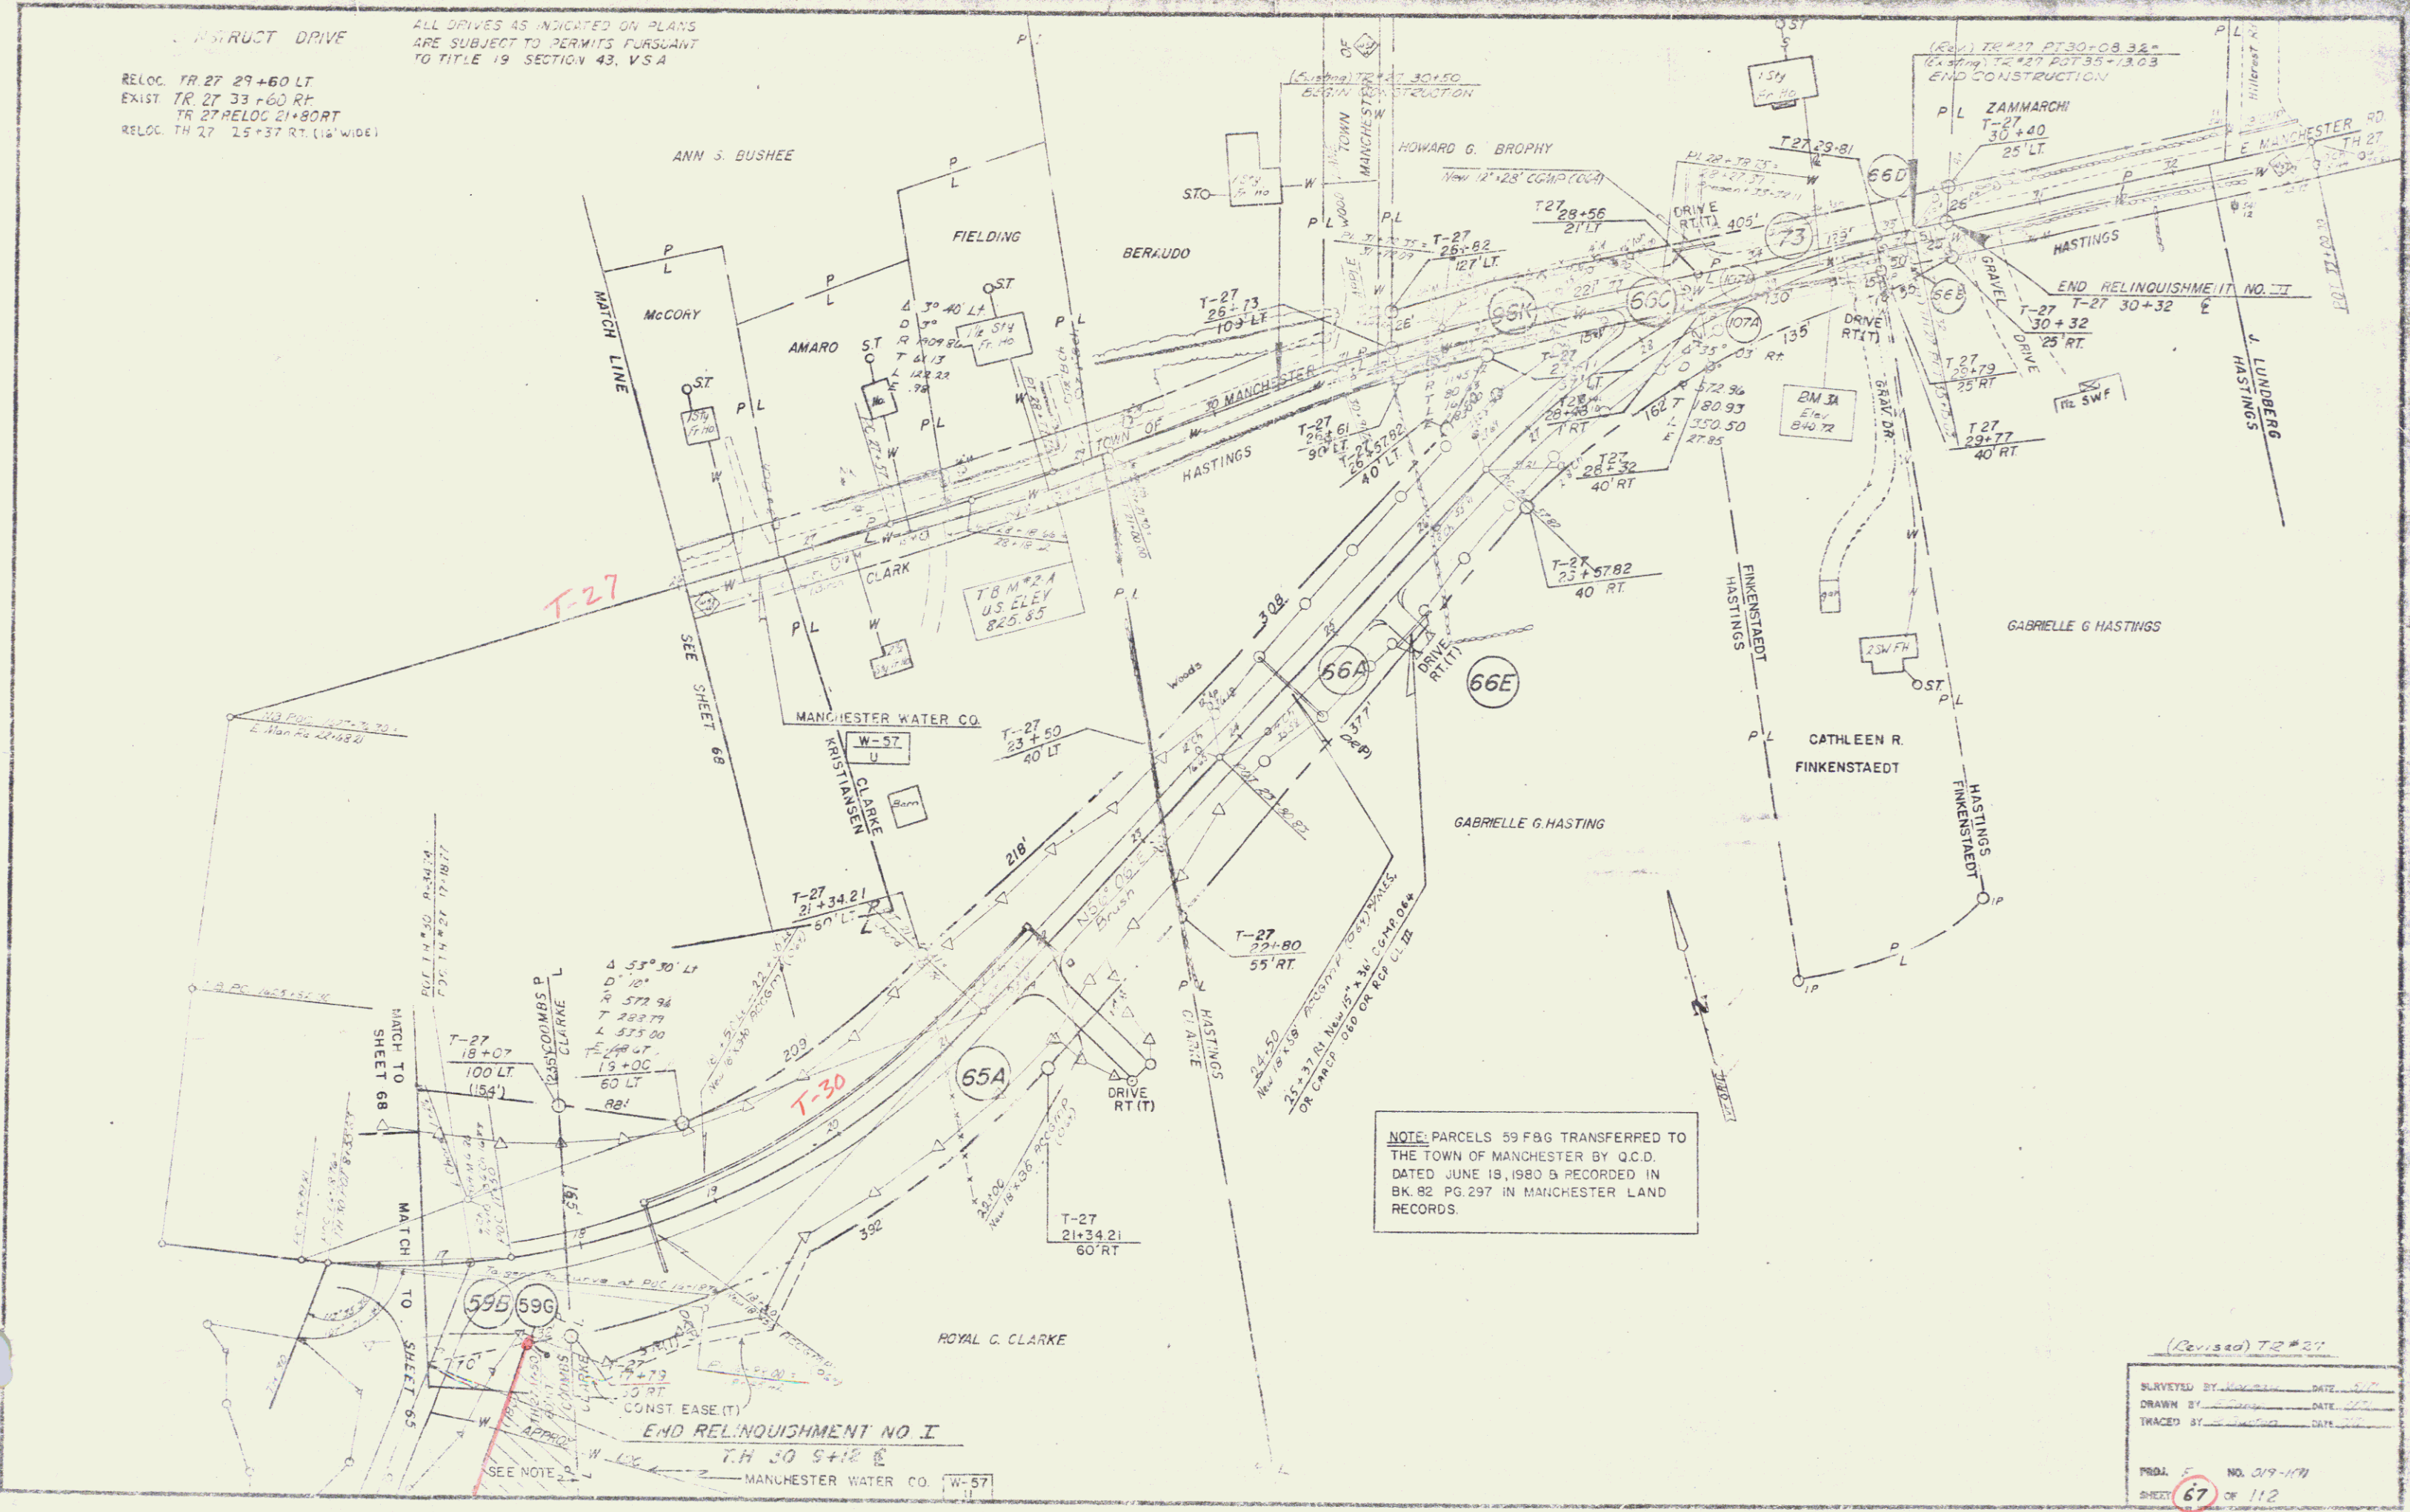

NOTE: PARCELS 59 FBG TRANSFERRED TO THE TOWN OF MANCHESTER BY Q.C.D. DATED JUNE 18, 1980 & RECORDED IN BK. 82 PG. 297 IN MANCHESTER LAND RECORDS.

(Revised) T-27

SURVEYED BY	DATE
DRAWN BY	DATE
TRACED BY	DATE
PROJ. NO.	NO. 019-109
SHEET	67 OF 112