


ALL STATION OFFSETS ARE REFERENCED TO RTE. 11 SURVEY LINE

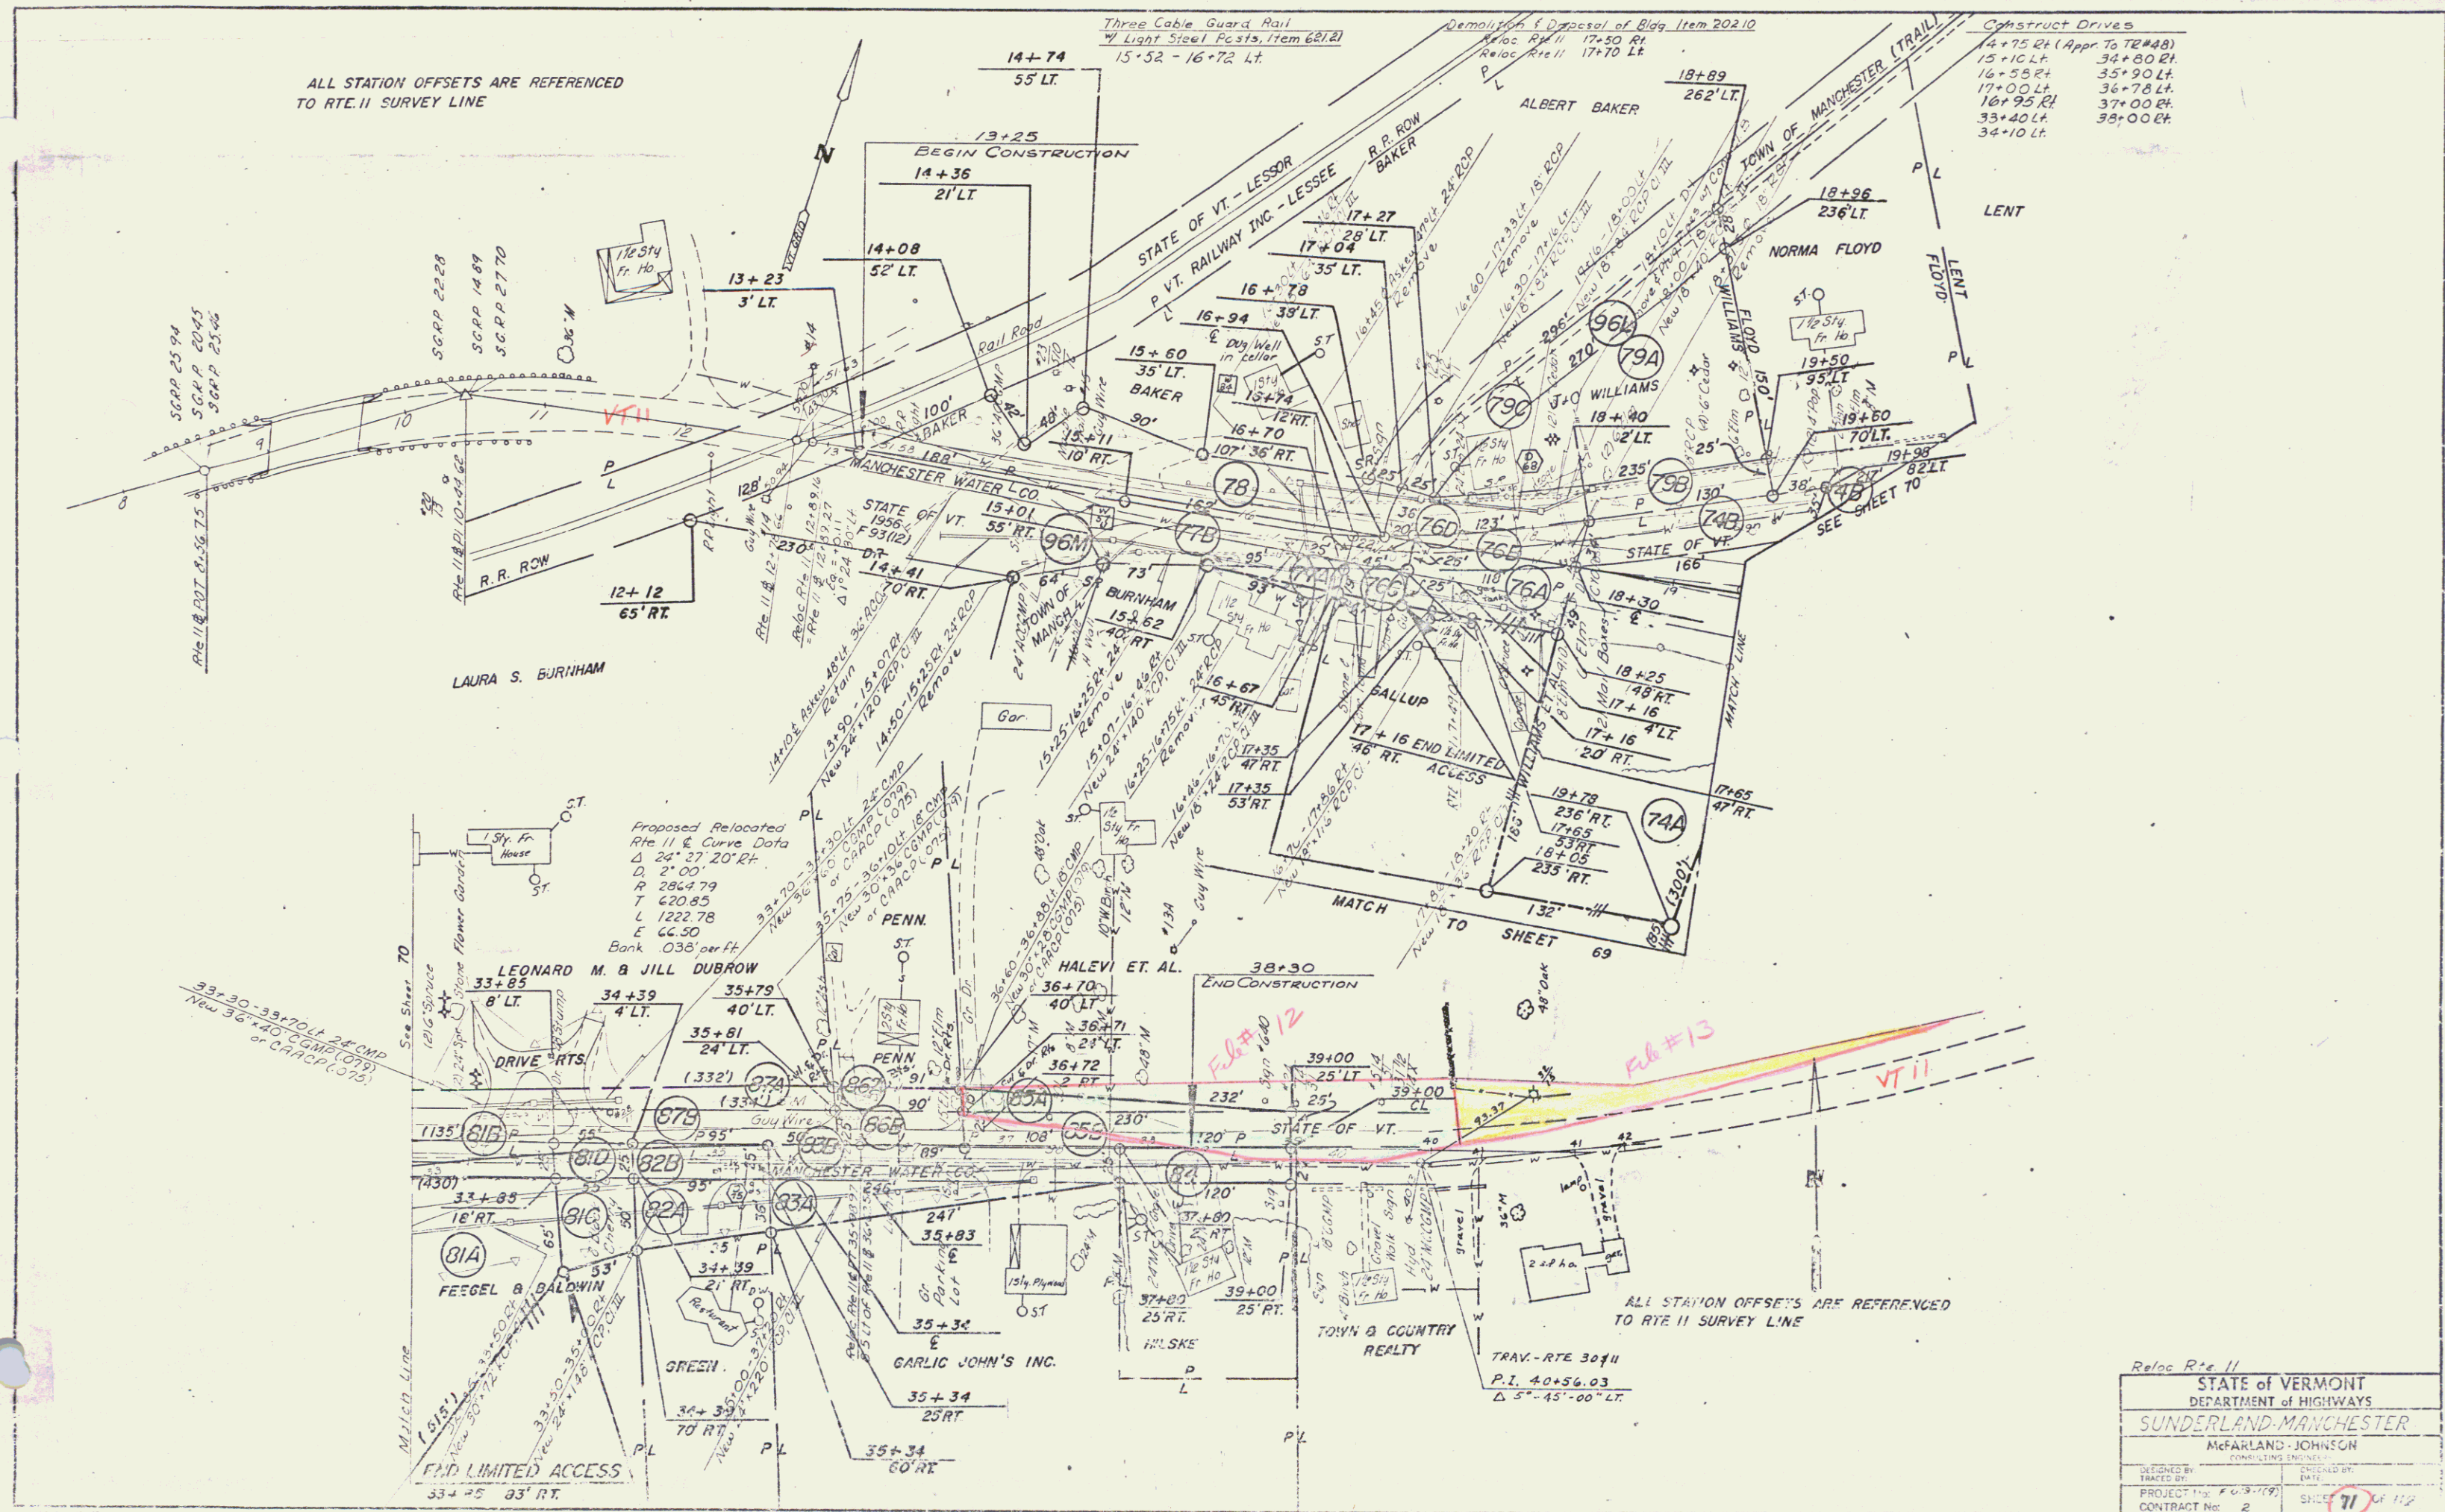

Reloc Rte 11	
STATE OF VERMONT DEPARTMENT OF HIGHWAYS	
SUNDERLAND-MANCHESTER	
McFARLAND-JOHNSON	
DESIGNED BY	ENGINEER
TRACED BY	DATE
PROJECT NO. 70-3-179	SHEET 71 OF 112
CONTRACT NO. 2	