
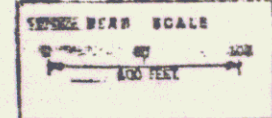


POOR ORIGINAL COPY

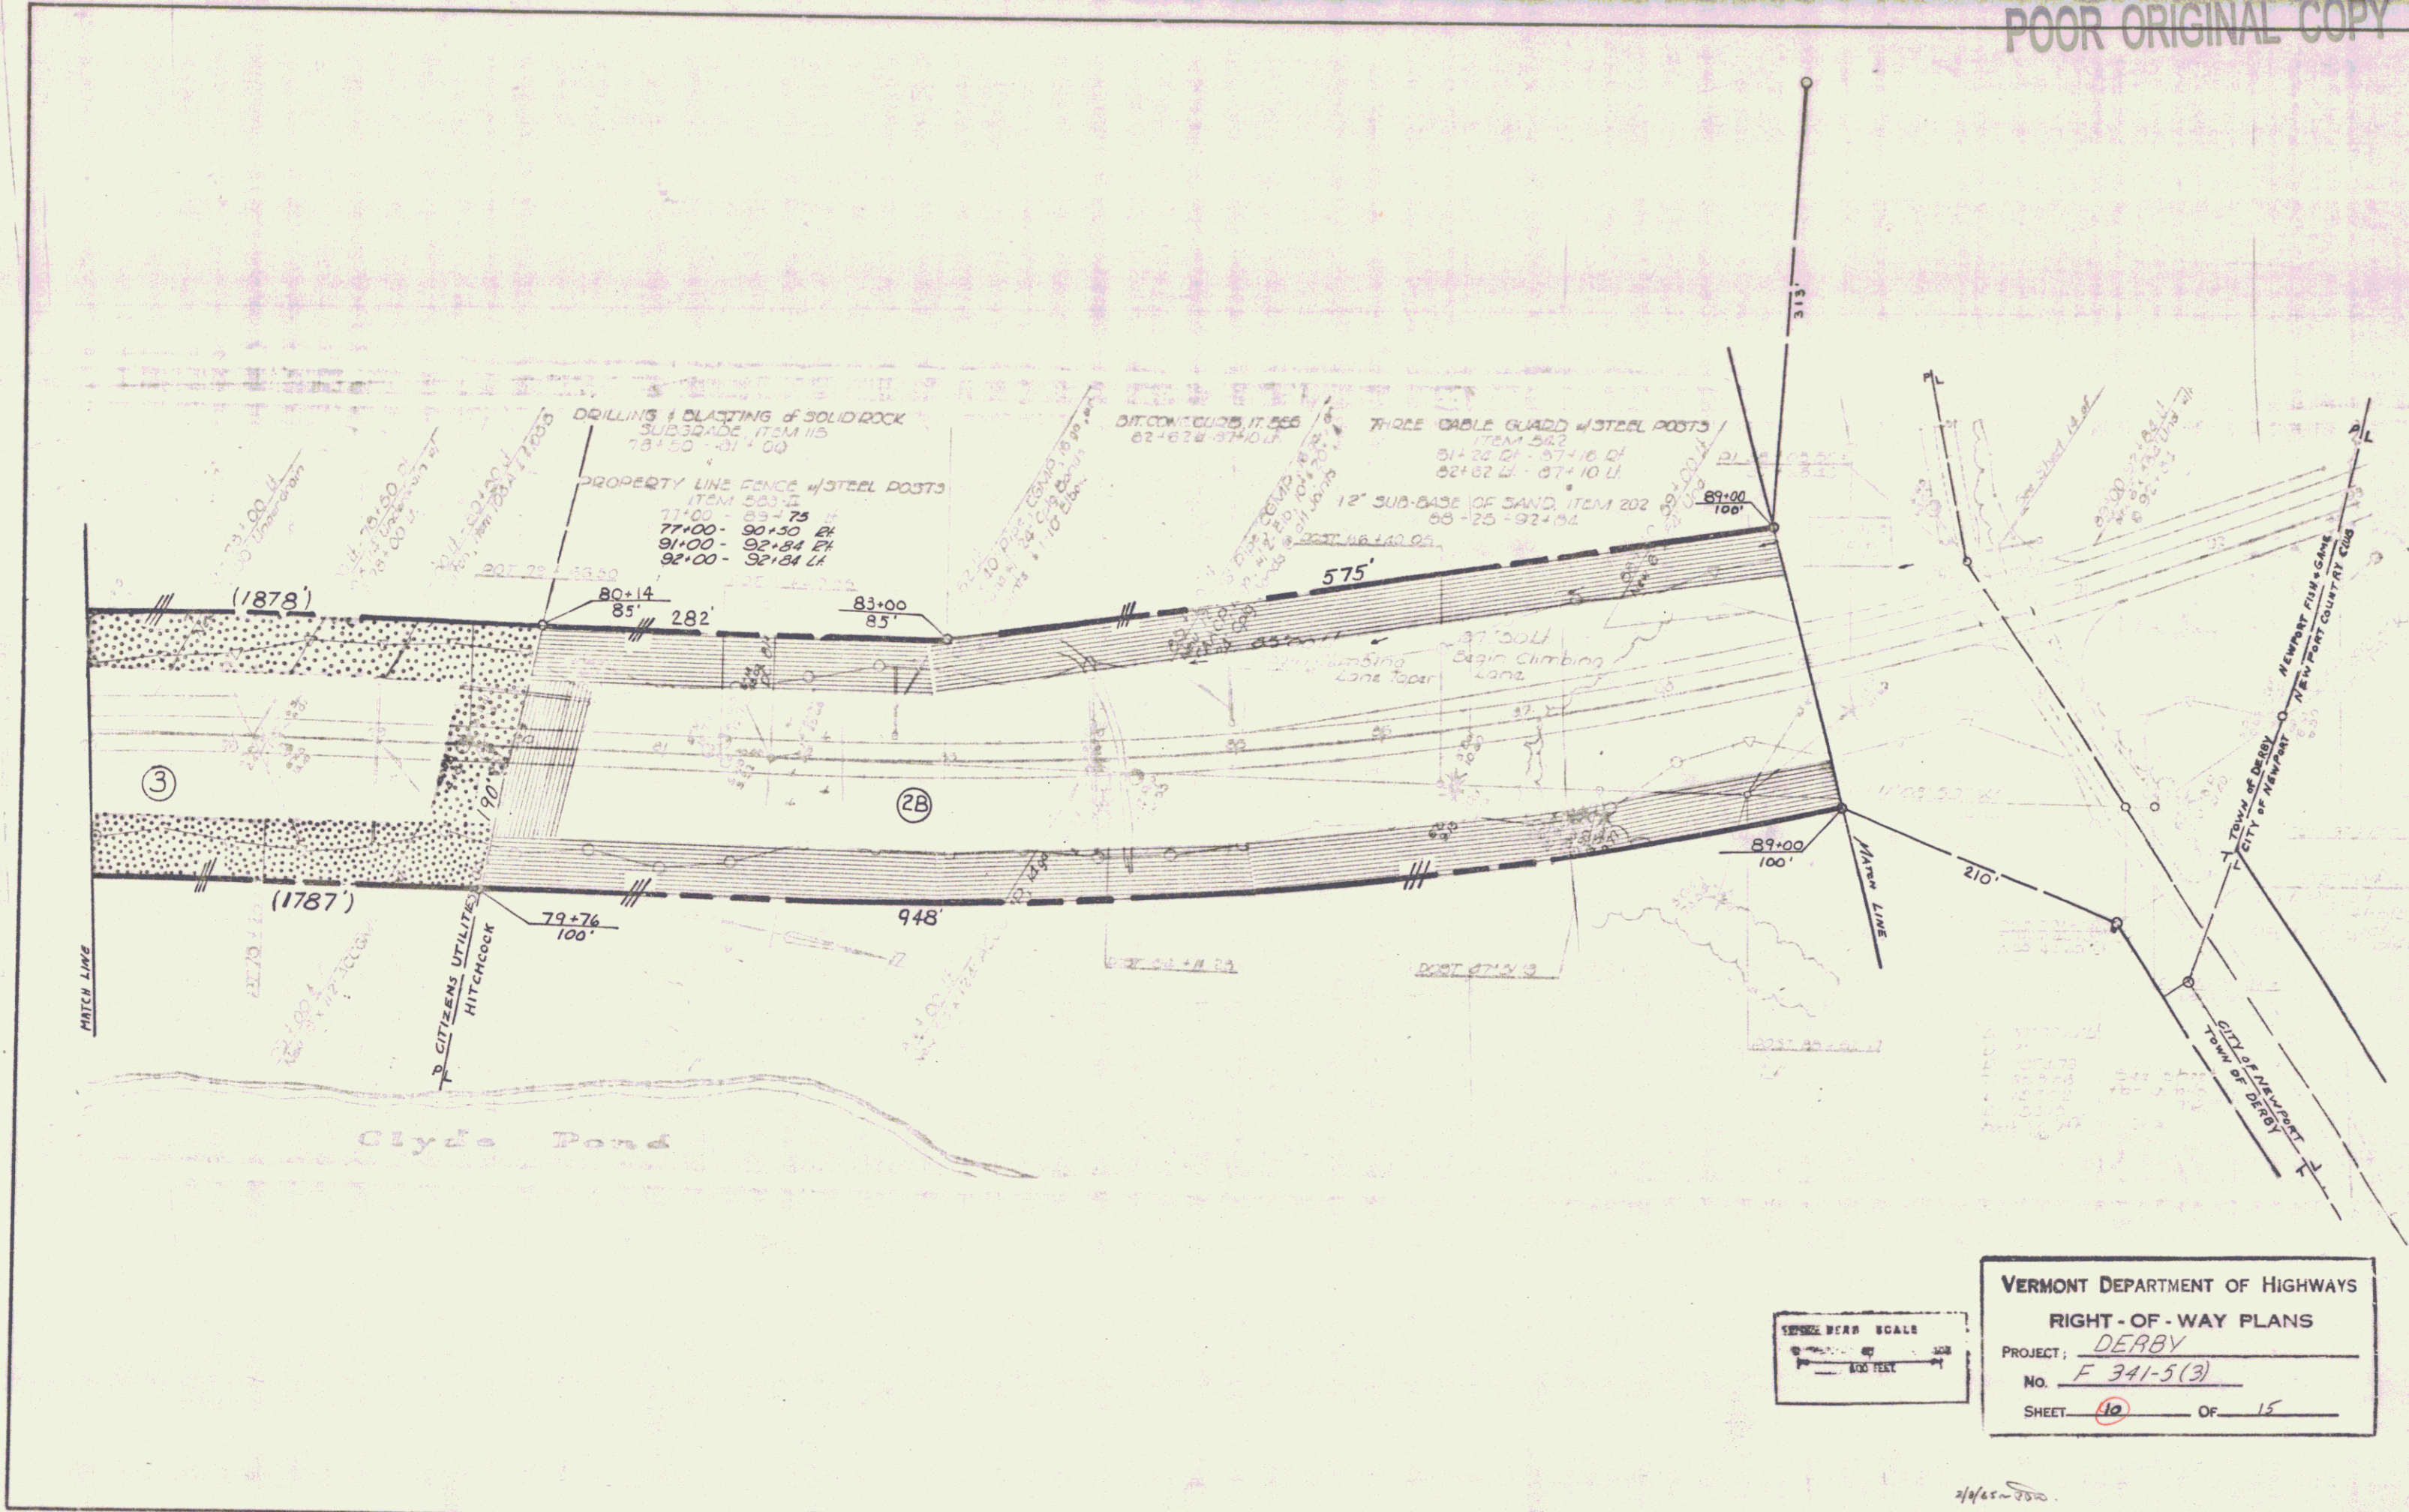

VERMONT DEPARTMENT OF HIGHWAYS
 RIGHT-OF-WAY PLANS
 PROJECT: DERBY
 NO. F 341-5(3)
 SHEET 10 OF 15

2/14/85 - JSD