


POOR ORIGINAL COPY



VERMONT DEPARTMENT OF HIGHWAYS
RIGHT-OF-WAY PLANS
PROJECT: DERBY
No. F 341-5(3)
SHEET 9 OF 15

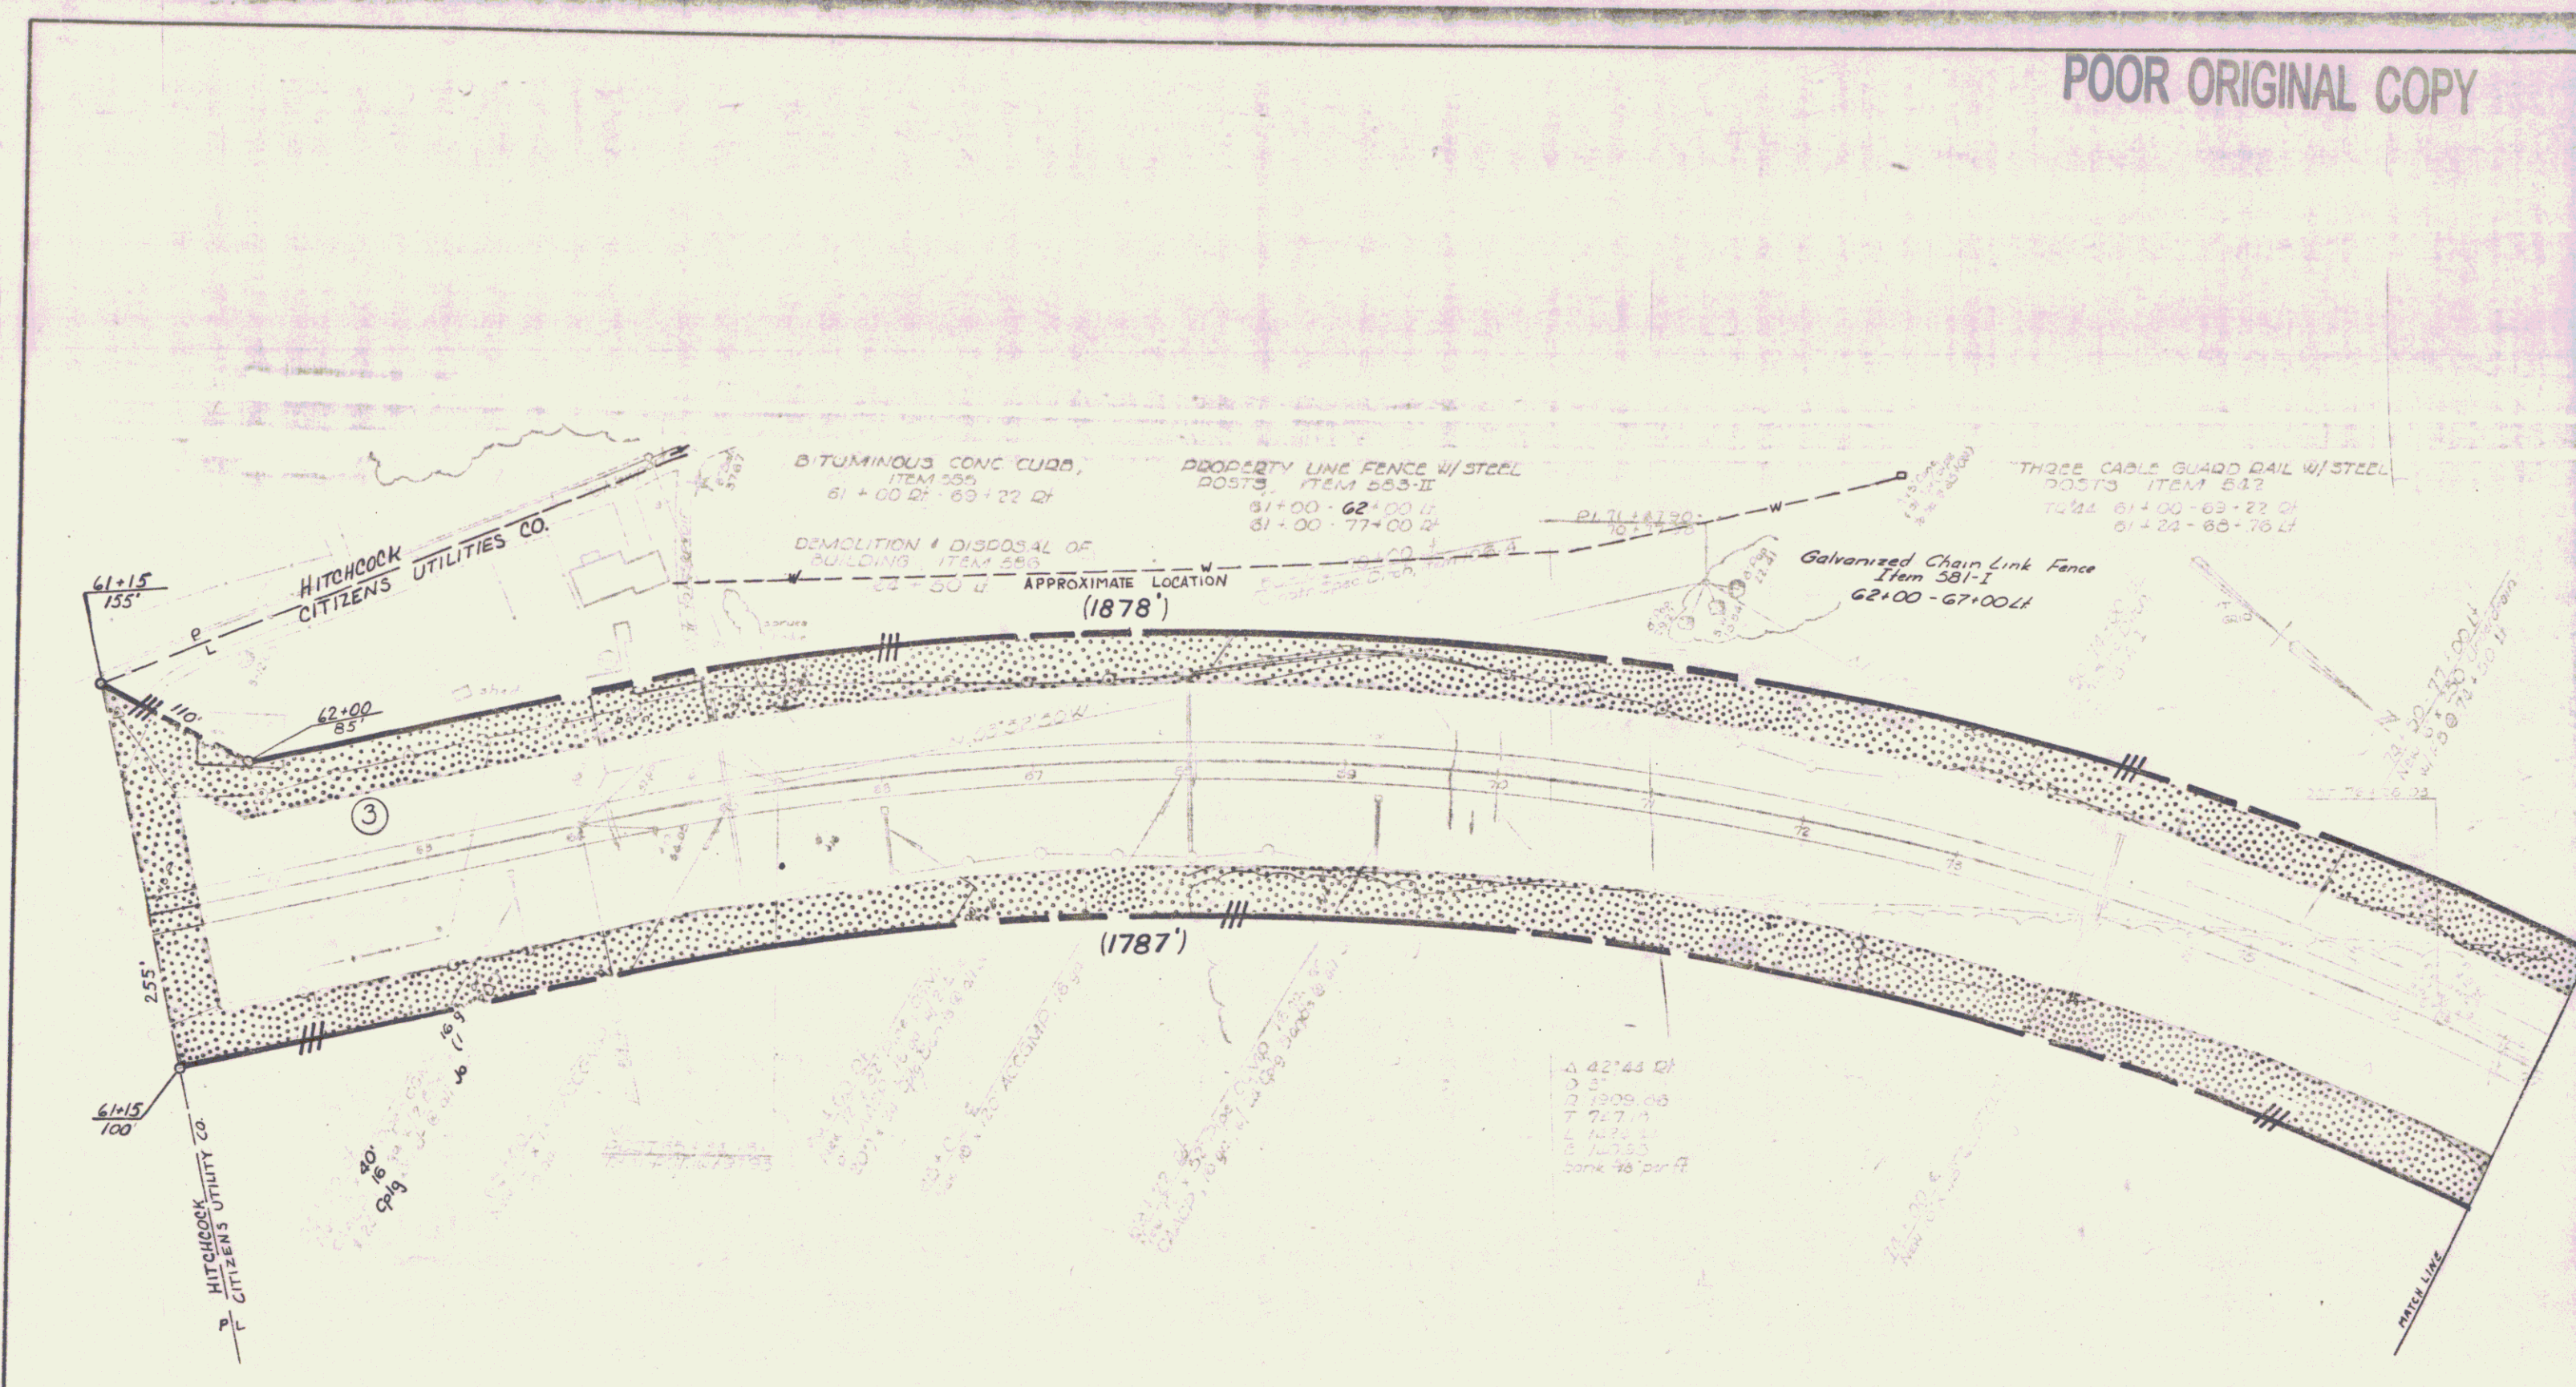