


POOR ORIGINAL COPY

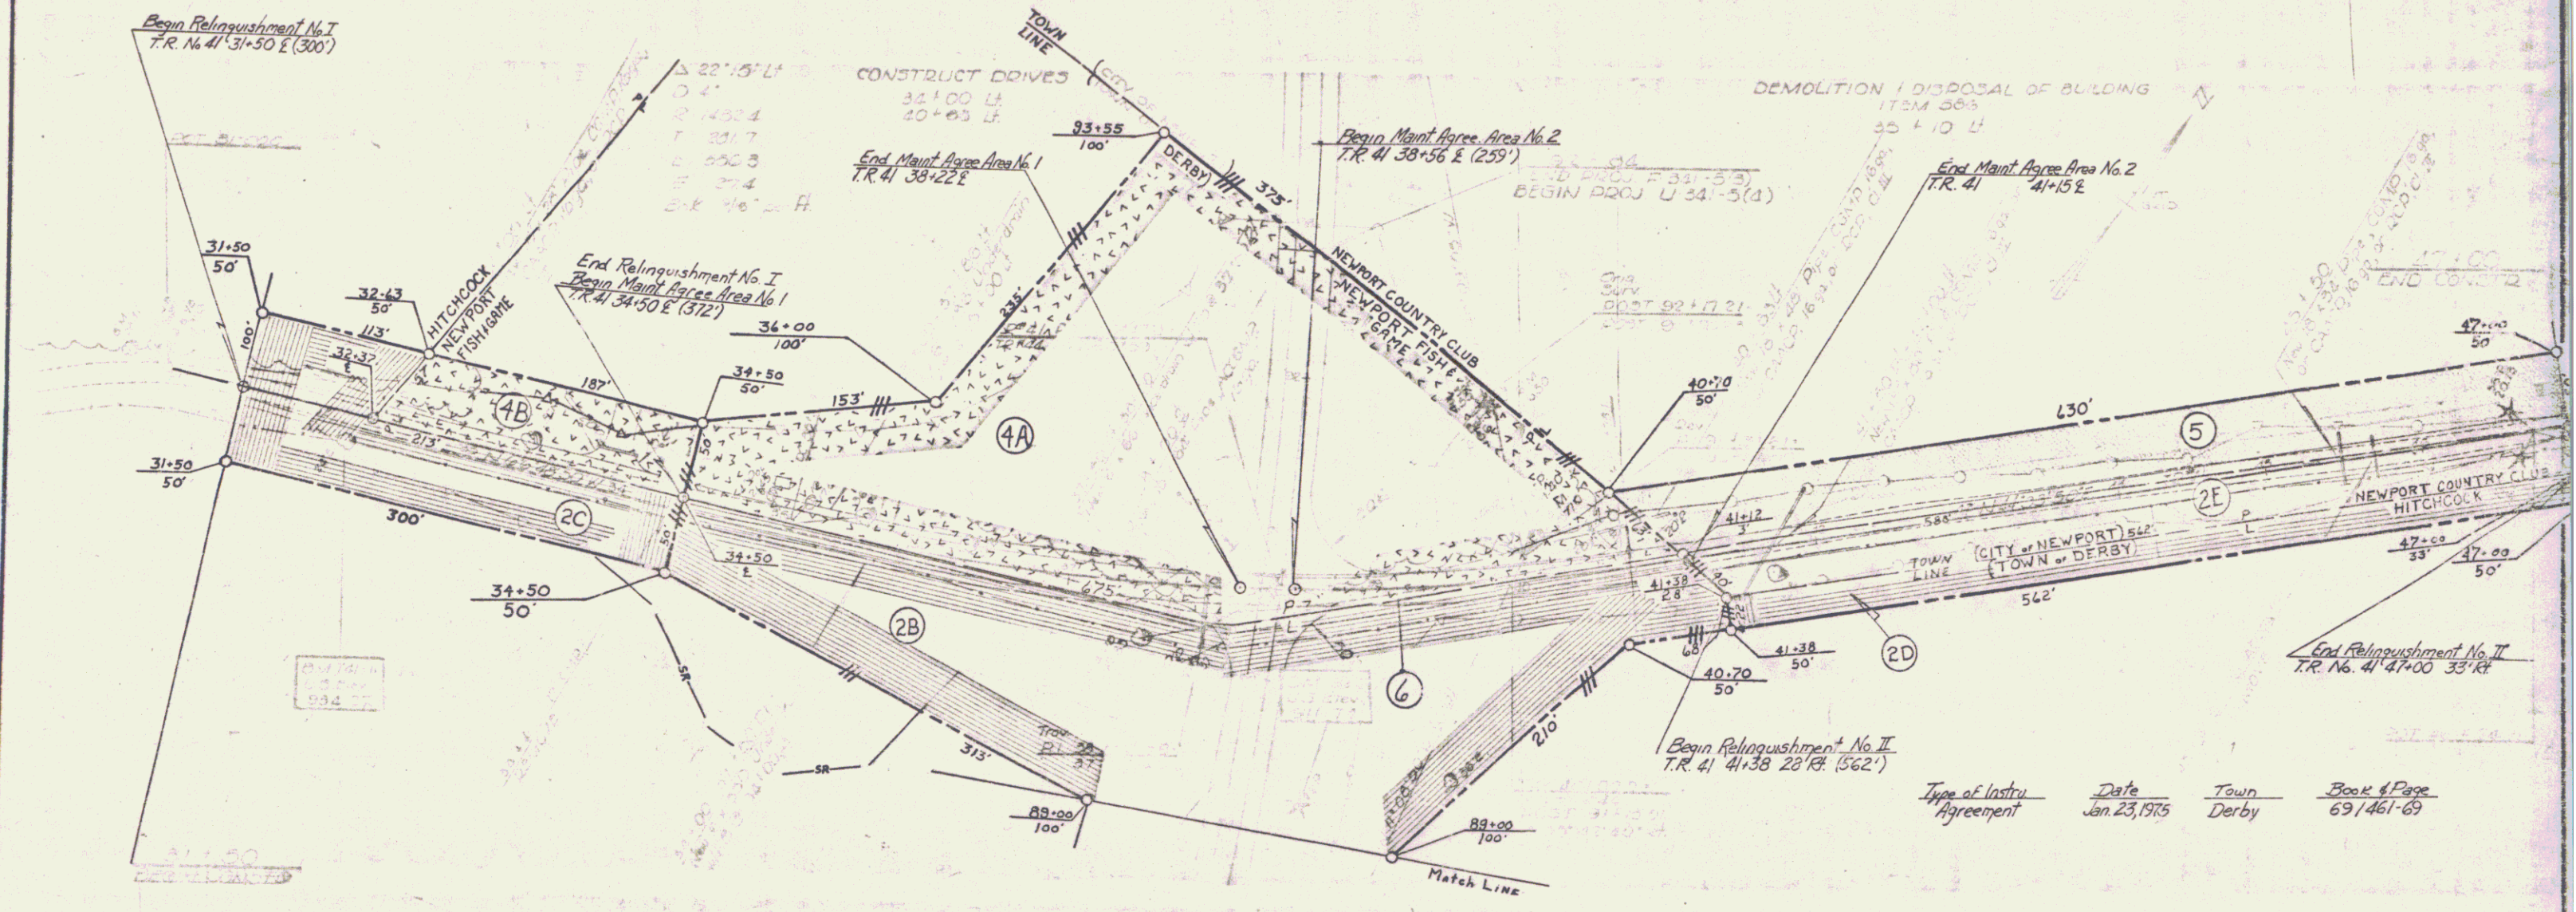

Type of Instru	Date	Town	Book & Page
Agreement	Jan. 23, 1975	Derby	69/461-69



VERMONT DEPARTMENT OF HIGHWAYS
RIGHT-OF-WAY PLANS
PROJECT: DERBY
No. F 341-5 (3)
SHEET 41 OF 15