


PLAN
 DATE: 3/64
 DRAWN BY: J. J. [unclear]
 CHECKED BY: [unclear]
 SCALE: 1" = 40'

PROFILE
 DATE: 3/64
 DRAWN BY: J. J. [unclear]
 CHECKED BY: [unclear]
 SCALE: 1" = 10'

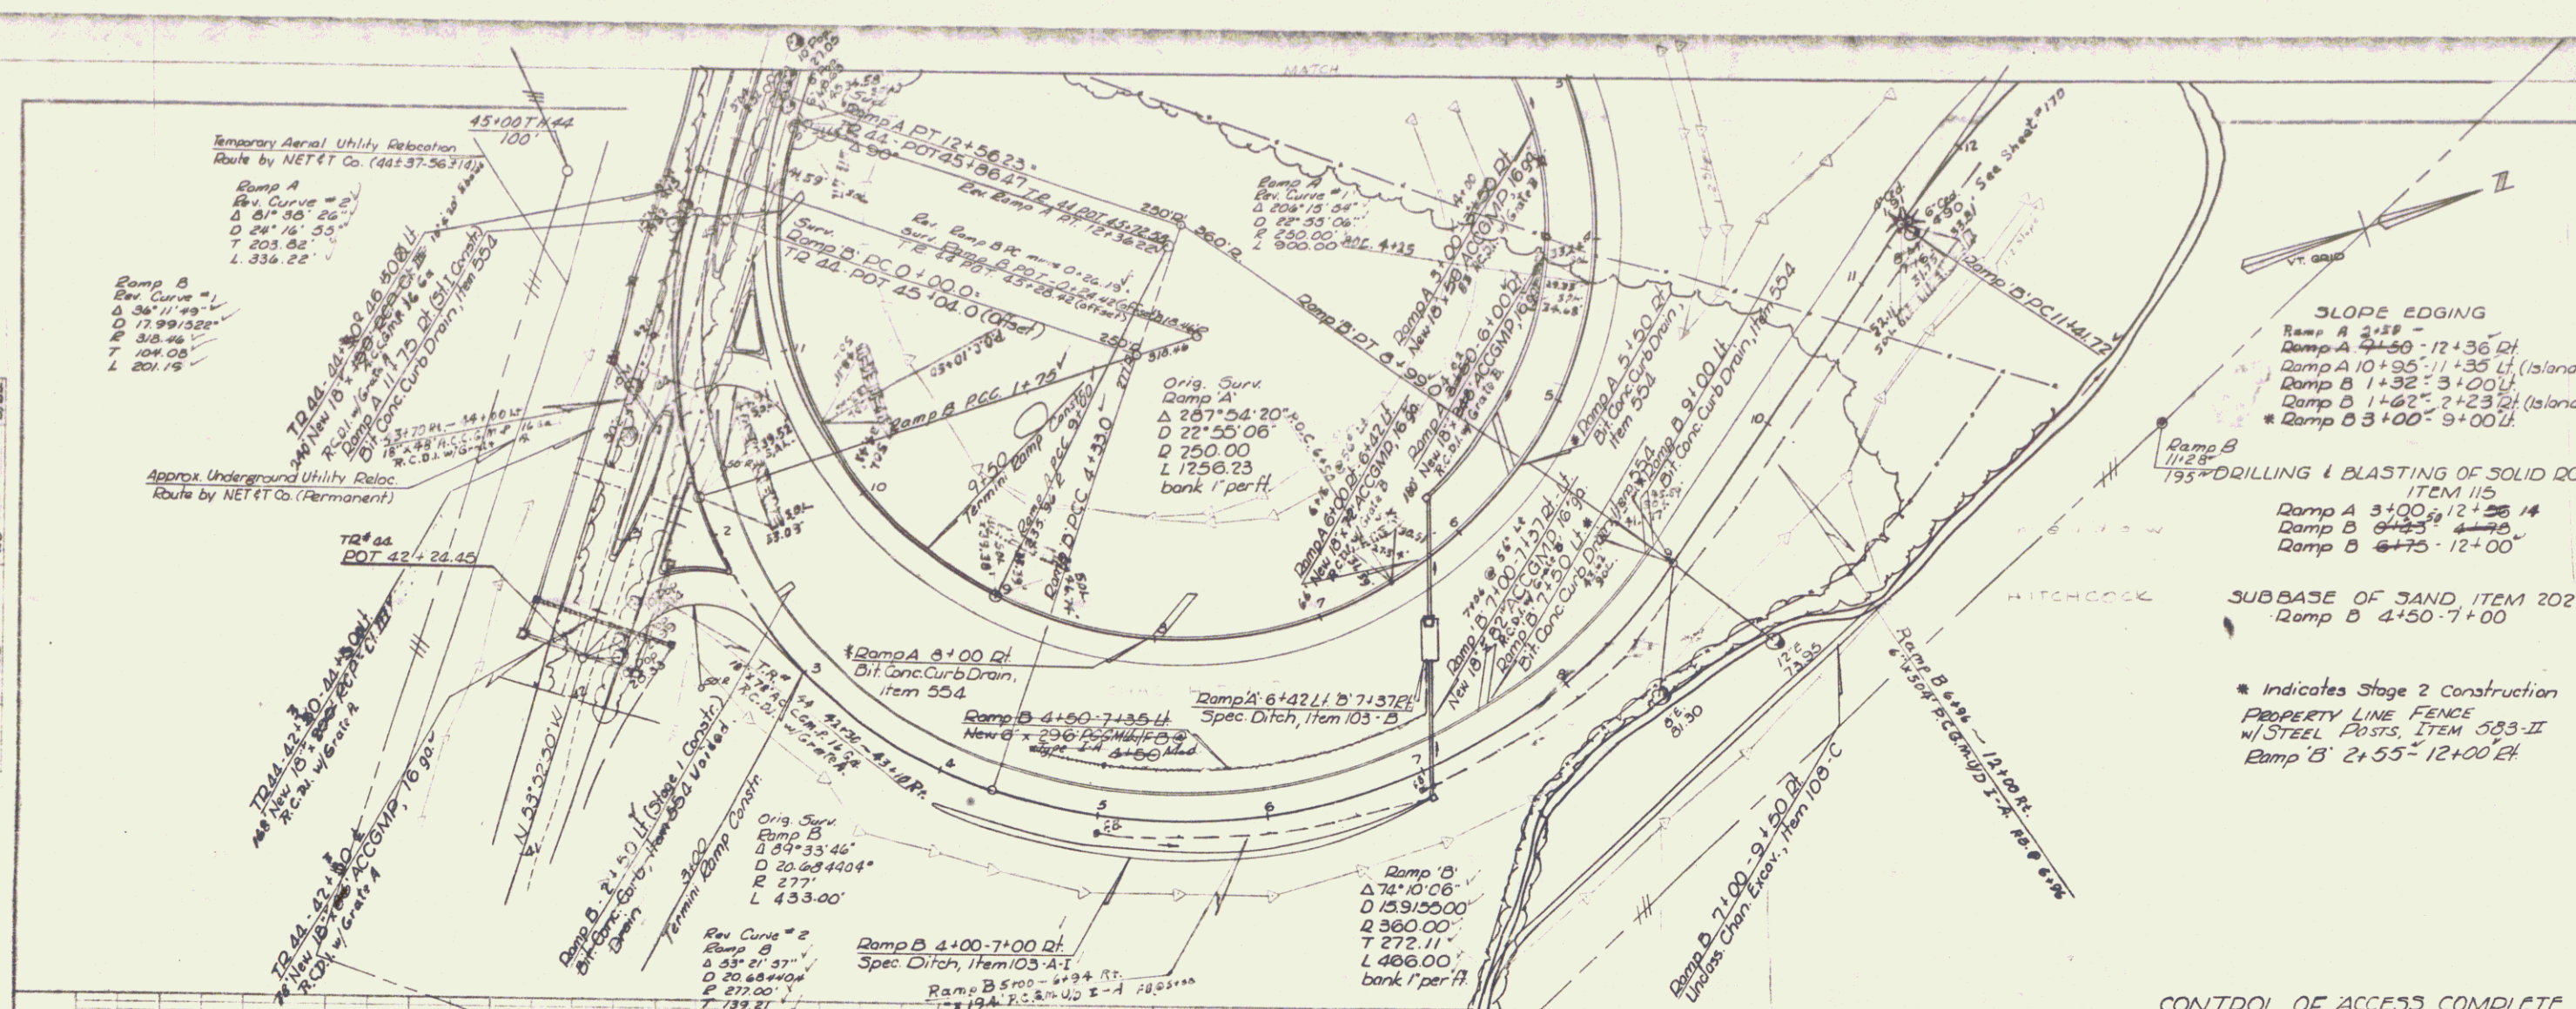

SLOPE EDGING
 Ramp A 2+55 -
 Ramp A 7+50 - 12+36 Rt.
 Ramp A 10+95 - 11+35 Lt. (Island)
 Ramp B 1+62 - 2+23 Lt. (Island)
 Ramp B 3+00 - 9+00 Lt.

DRILLING & BLASTING OF SOLID ROCK SUBGRADE
 ITEM 115
 Ramp A 3+00 - 12+36 Lt.
 Ramp B 6+75 - 12+00

SUBBASE OF SAND ITEM 202
 Ramp B 4+50 - 7+00

* Indicates Stage 2 Construction
PROPERTY LINE FENCE
 W/STEEL POSTS, ITEM 583-II
 Ramp B' 2+55 - 12+00 Lt.

CONTROL OF ACCESS COMPLETE
 ON THIS SHEET EXCEPT @ TR 44,
 STA. 45+04



2
 Stage 1 Construction
 DERBY-NEWPORT
 DERBY
 F 341-5(2)(6)
 Ramps A & B
 Sheet 104 of 205