

TRUCK CABLE STAYS w/ LIGHT
 ITEM 538
 Ramp D 0+30 - 1+50 ELV
 * Ramp C 9+00 - 10+35 ELV
 * Ramp C 7+73 - TR 44 53+42 ELV
 Ramp C 7+91 - TR 44 57+42 ELV
 Ramp C 10+79 - TR 44 57+42 ELV
 Ramp C 10+79 - TR 44 57+42 ELV
 TR 44 57+77 - Ramp D 1+87 ELV
 Ramp E 4+24 - Ramp D 3+73 ELV
 Ramp D 1+34 - 5+30 ELV


Bridge Railings
 NE Corner 27'5"
 NW Corner 27'5"
 SE Corner 27'5"
 SW Corner 27'5"
 * TREATED TIMBER CURB
 ITEM 558
 TR 44 46+35 - 46+75 ELV
 " 46+35 - 47+05 ELV
 " 51+05 - 51+35 ELV
 Ramp D 7+50 ELV - TR 44 55+00 ELV
 Ramp C 19+98 ELV - TR 44 55+00 ELV
 Ramp C 9+36 - 12+31 ELV

STAGE 2
 TR 44 45+00 - 47+22 ELV
 " 54+50 - 55+00 ELV
 Ramp C 9+00 - 11+50 ELV
 Ramp D 0+36 - 12+31 ELV

ROLLING AND BLASTING OF SOLID ROCK SUBGRADE
 ITEM 559
 NB 2907 00 2311'50"
 SB 2893 00 2893'30"
 TO 4 23'00 46'75"
 Ramp A 0'30 3'10"

* SLOPE EDGING
 TR 44 45+00 - 46+94.50 (Island)
 " 51+25 - 52+35 (Island)
 Ramp C 11+30 - 12+20 (Island)
 Ramp D 0+34 - 1+36 (Island)

STANDARD STEEL BEAM GUARDRAIL WITH STEEL POSTS
 ITEM 560
 46+35 - 46+75 ELV
 46+75 - 47+05 ELV
 51+05 - 51+35 ELV
 51+35 - 52+35 ELV

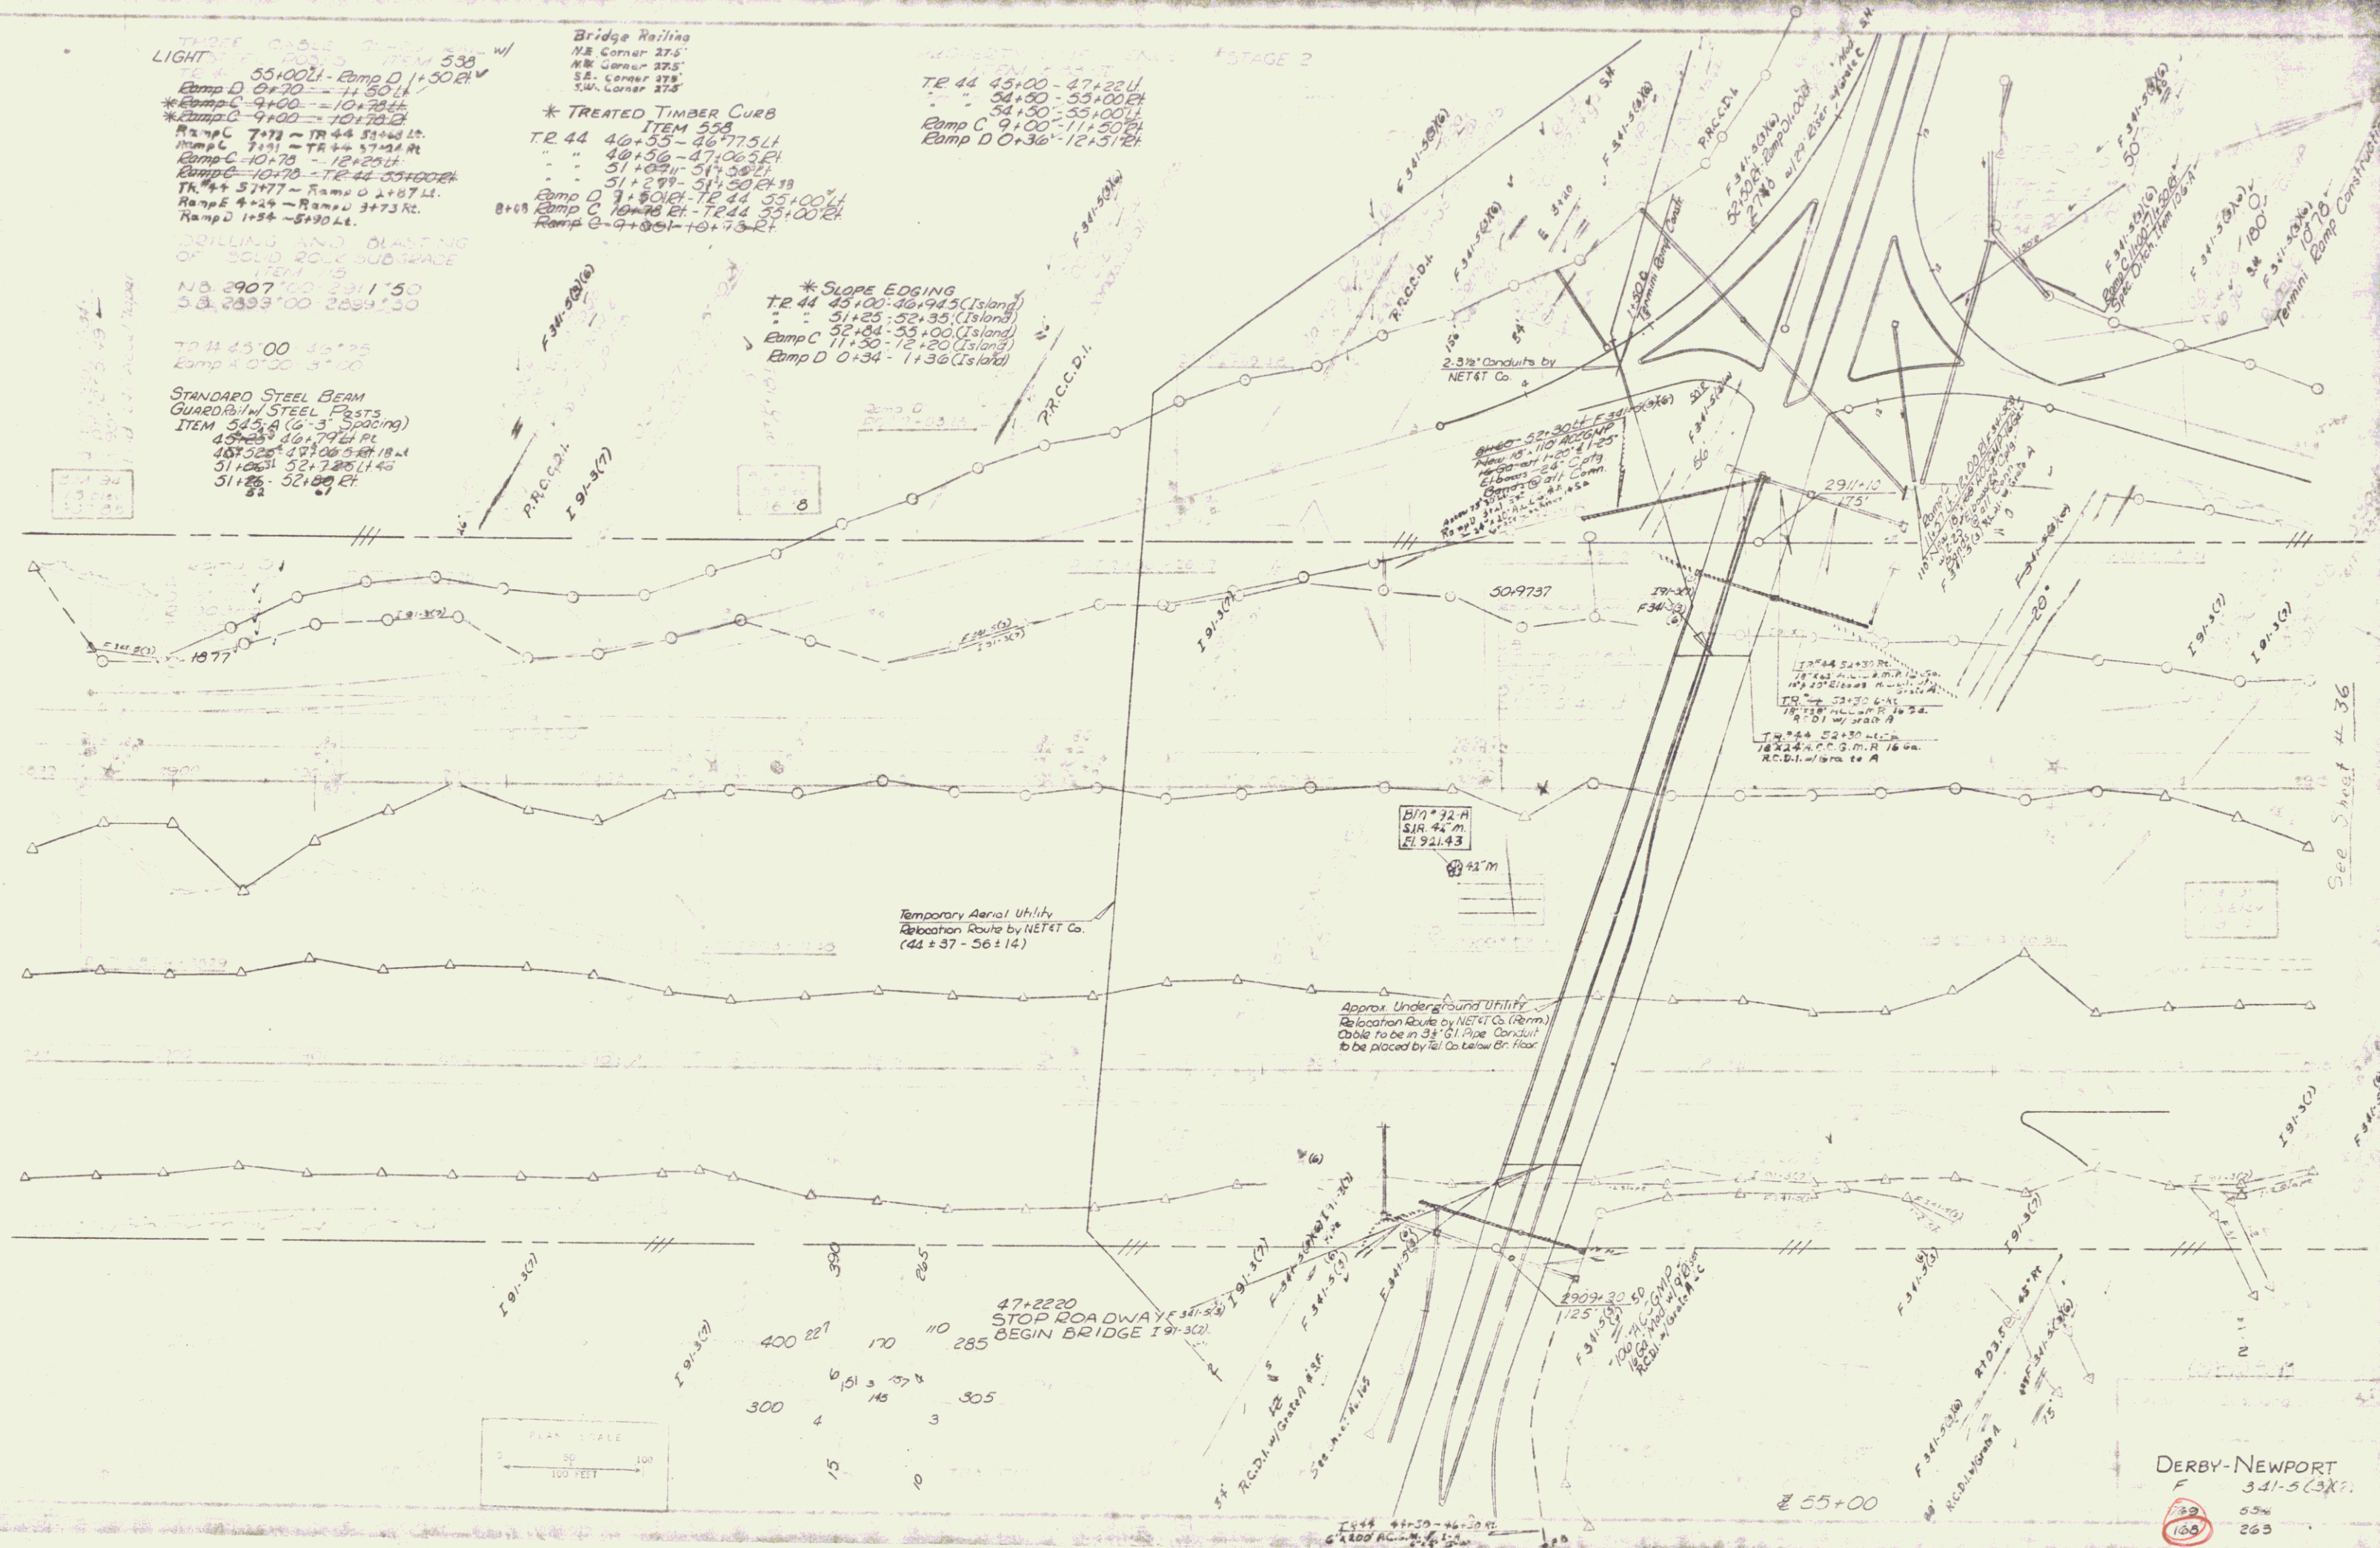

DERBY-NEWPORT
 F 3.41-5 (3X)
 158 55 263