
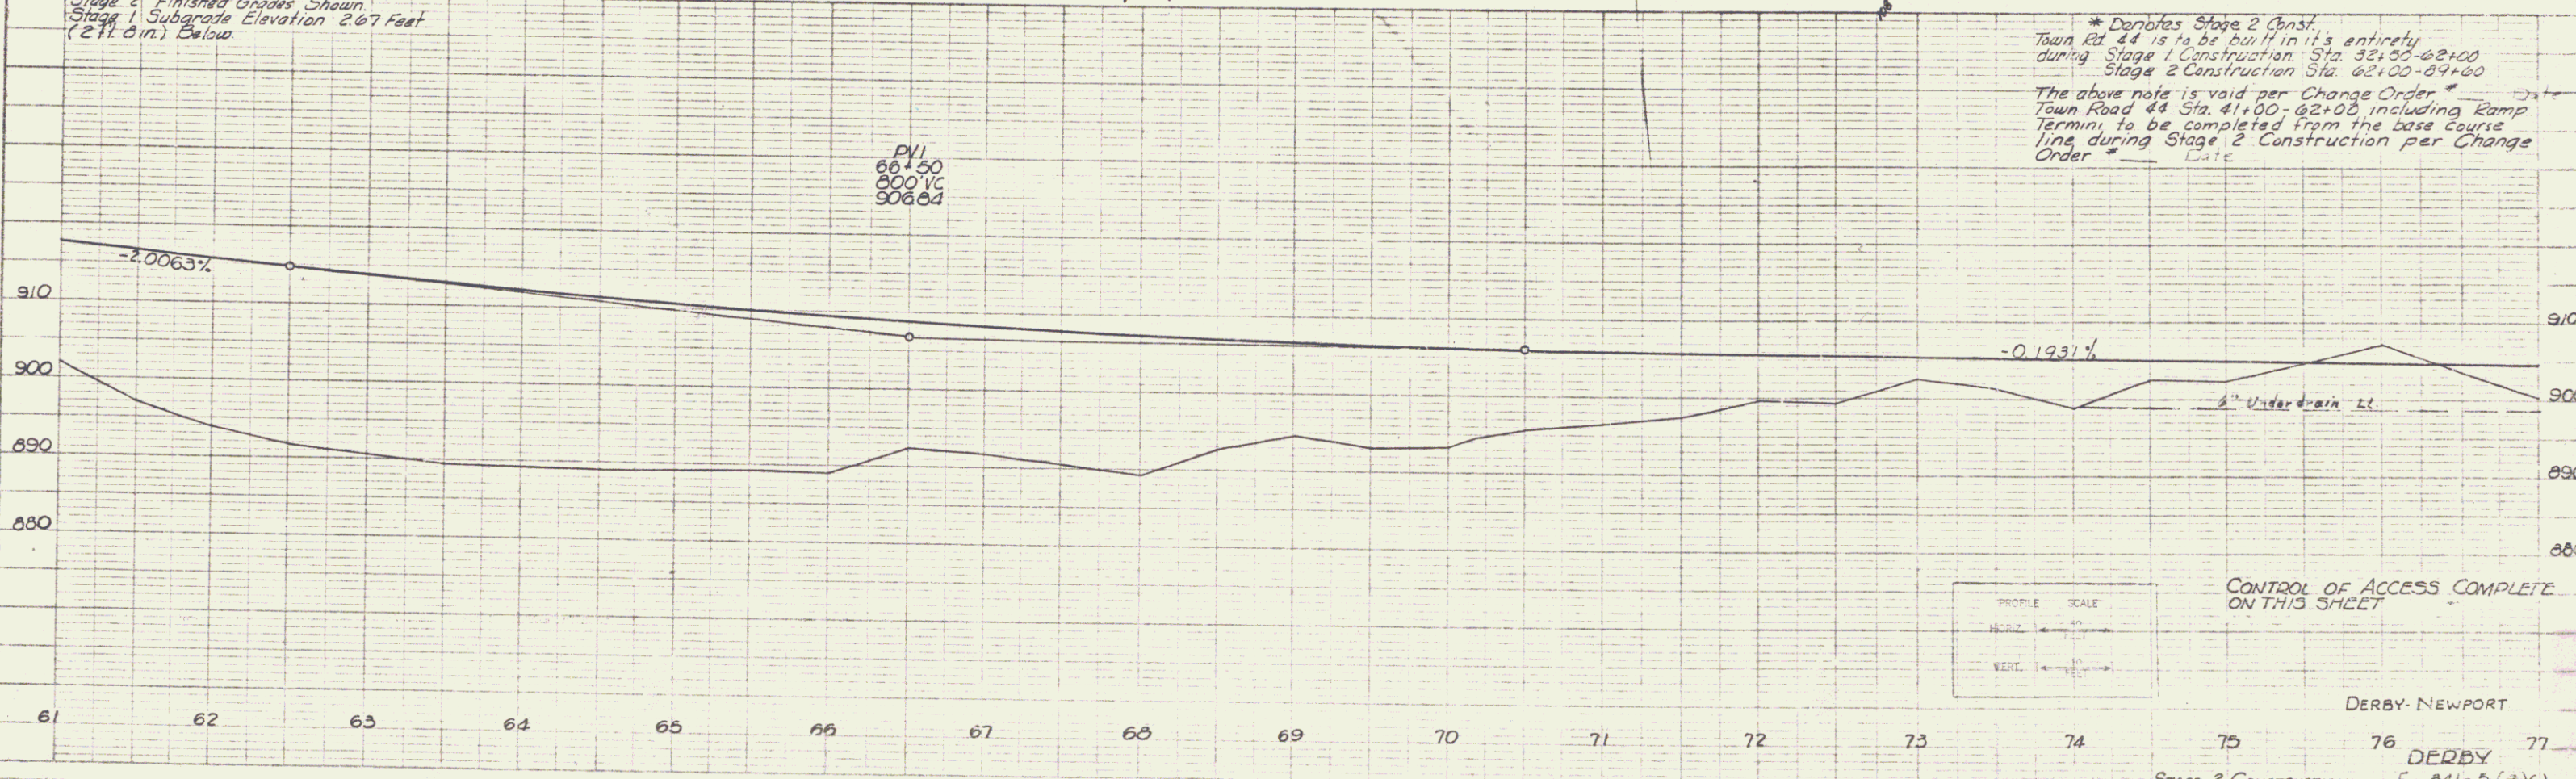


PLAN
 DATE: 1/15/64
 DRAWN BY: J. J. JONES
 CHECKED BY: K. J. JONES

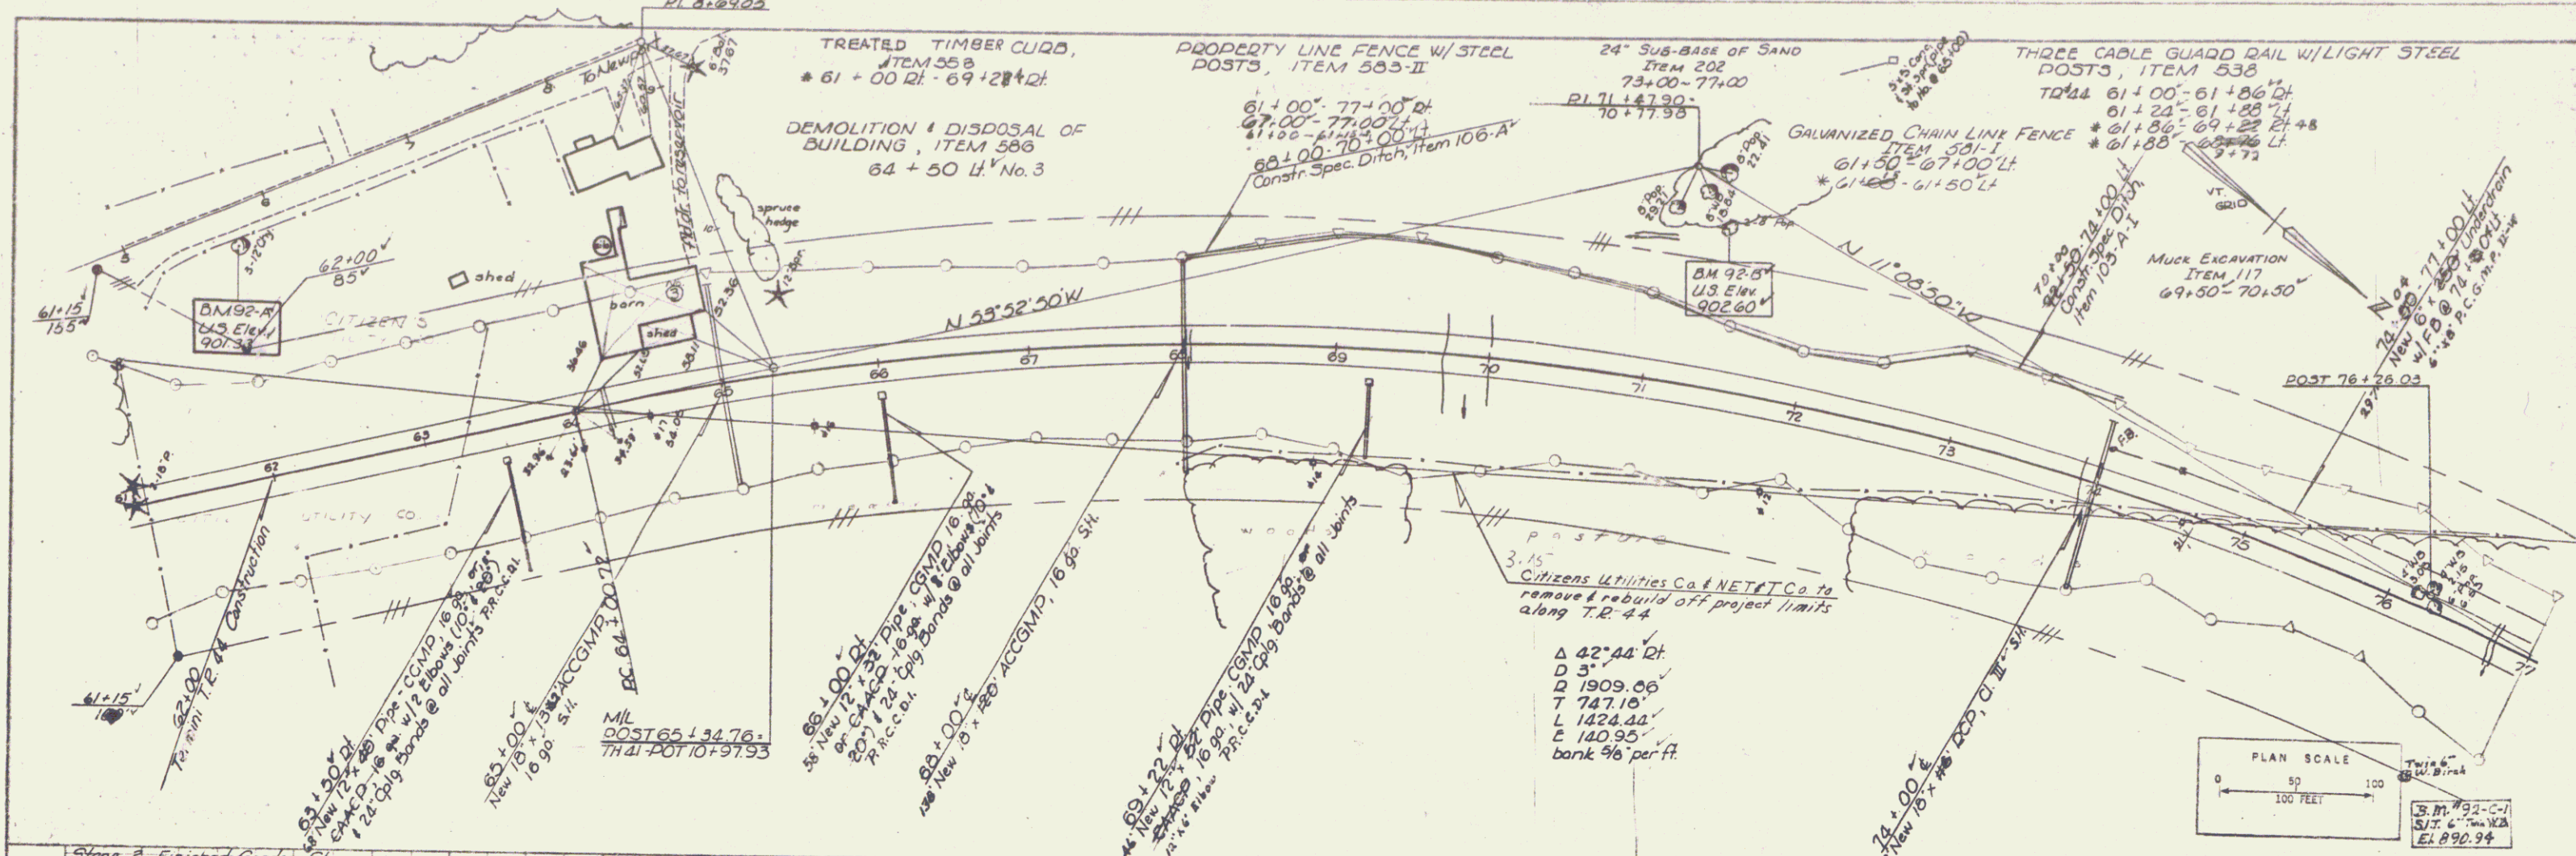

PROFILE
 DATE: 1/15/64
 DRAWN BY: J. J. JONES
 CHECKED BY: K. J. JONES

* Denotes Stage 2 Const.
 Town Rd 44 is to be built in it's entirety during Stage 1 Construction Sta 32+00-62+00
 Stage 2 Construction Sta 62+00-84+00
 The above note is void per Change Order # Town Road 44 Sta. 41+00-62+00, including Ramp Termin to be completed from the base course line during Stage 2 Construction per Change Order #

PROFILE SCALE
 HORIZ. 1" = 100'
 VERT. 1" = 10'

PLAN SCALE
 0 50 100
 100 FEET

CONTROL OF ACCESS COMPLETE ON THIS SHEET

DERBY-NEWPORT
 STAGE 2 CONSTRUCTION
 F 541-5(3)6
 TP 2
 Sheet 172 of 203