


STATE OF VERMONT
DEPARTMENT OF HIGHWAYS
RIGHT-OF-WAY PLANS
DETAIL SHEET
OF

TABLE OF PROJECT PROPERTY ACQUISITION

TABLE OF REVISIONS

PARCEL	OWNER	FILE NO.	STATIONING	TAKING #	REM. #	ACRES	TITLE TAKEN	DATE	TOWN OR CITY RECORDED	BK.	PG.	REMARKS
1	GERARD ROY & ELSE ROY (H&W)	9	17+50	20+98 _{USST}	0.37 A	14.03 A	FEE WD	6/3/68	IRASBURG	25	53	
		9	19+50	20+66 _{USST}								SLOPE (2000 ⁰) (T)
2	IRVIN B. INGALLS & ROY W. INGALLS	9	17+50	21+34 _{USST}	0.37 A	191.06 A	FEE WD	7/30/68	IRASBURG	36	17	
		9	18+50	21+76 _{USST}								SLOPE (14150 ⁰) (T)
3A	PHILIP C. ROYER & BERNADETTE K. ROYER (H&W)	9	20+66	26+76 _{USST}	1.6 A		FEE CONDA.	6/26/68	BARTON	55	100 102	SEE 191 FOR REMAINDER
		9	24+57 _{USST}									DRAINAGE (P)
		9	24+50 _{USST}									CULVERT (P)
		9	20+53	24+59 _{USST}								SLOPE (5250 ⁰) (T)
		9	21+34	24+45 _{USST}								SLOPE (23950 ⁰) (T)
3		7-8	20+65	28+10 _{USST}	2.0 A							Sewer
C		8	34+00	34+35 _{USST}	1.54 A							
D	Deleted		36+00	LA								DRIVE (T)
4	UVM LESSOR FERDINAND TANGUAY & CLAIRE TANGUAY (H&W) LESSEE	7	9+50	11+46 _{USST}	0.24 A	1.26 A	FEE CONDA.	6/26/68	BARTON	55	100 102	
		7	11+15	11+43 _{USST}								SLOPE (450 ⁰) (T)
5	UVM LESSOR EUGENE BOISVERT & SIMONNE BOISVERT LESSEE	7	11+43	13+73 _{USST}	0.35 A	1.05 A	FEE CONDA.	6/26/68	BARTON	55	100 102	
		7	12+00 _{USST}									DRIVE (T)
		7	11+54 _{USST}									CULVERT (P)
		7	11+41	12+20 _{USST}								SLOPE (1300 ⁰) (T)

REVISION NO.	SHEET NO.	DESCRIPTION OF REVISION	DATE	MADE BY	APPROVED BY
1		Parcel #11, Changed Slope Rights per Change Order #579	1-24-67	RJP	H&R
2	8	Parcel #16 Change of Ownership Per Change Order #842	9-18-67	R.P.D.	JUL
3	8	Parcel #15 Deleted, Per Change Order #835	9-18-67	R.P.D.	JUL
4	7	Parcel #17 Added New Parcel & Drive Per Change Order #834	9-18-67	R.P.D.	JUL
5	7	Parcel #12 Replace Culvert Under R.R., Per Change Order #820	9-21-67	R.P.D.	JUL
6	7,8	Parcel #18 New Parcel Added Per Change Order #847	9-21-67	R.P.D.	JUL
7	7	Parcel #7 Changed Sewer Line Crossing on Layout Sheet to Cross at Sta. 16+00 Per Change Order #822	11-6-67	R.P.D.	JUL
8	8	Parcel #3, 10 & 11, Eonin Purchased Additional Land From Royer Increasing Take by 0.8 Ac & Remainder by 1.25 Ac. Eastman's Take was Reduced by .05 Ac Remainder Didn't Change. Royer's Take was Reduced by 0.7 Ac & Remainder by 1.25 Ac on 191. Per Change Order #821 & 851	11-7-67	R.P.D.	JUL
9	8	Parcel #3B Changed Ending Sta. from 30+01 to 28+10 per Change Order #1041	3-26-68	M.N.R.	JUL
10	4 & 7	PARCEL #5 CHANGED TITLE FROM NADAU TO BOISVERT ON DETAIL SHEET #4 AND LAYOUT SHEET #7 PER CHANGE ORDER #1075	5-1-68	WJM	JUL
11	6 & 7	PARCEL #11 CHANGED LISTING OF PROPOSED CULVERT AT STA. 11+63.5 RT. TO 48" BY 62" ACCOMP & GAUGE ON LAYOUT SHEET #7 PARCEL #12, DELETED CULVERT RIGHT AT 11+63.5 RT. PER CHANGE ORDER #1076	5-1-68	WJM	JUL
12	5 & 7	Parcel #7 Russell - Slope rights added per Change Order #1102.	5-3-68	M.H.M.	JUL
13	6 & 8	PARCEL #30 & 14 CHANGED PROPERTY LINE THEREBY AFFECTING TAKE AND REMAINDERS PER CHANGE ORDER #1168	6-4-68	L.S.	JUL

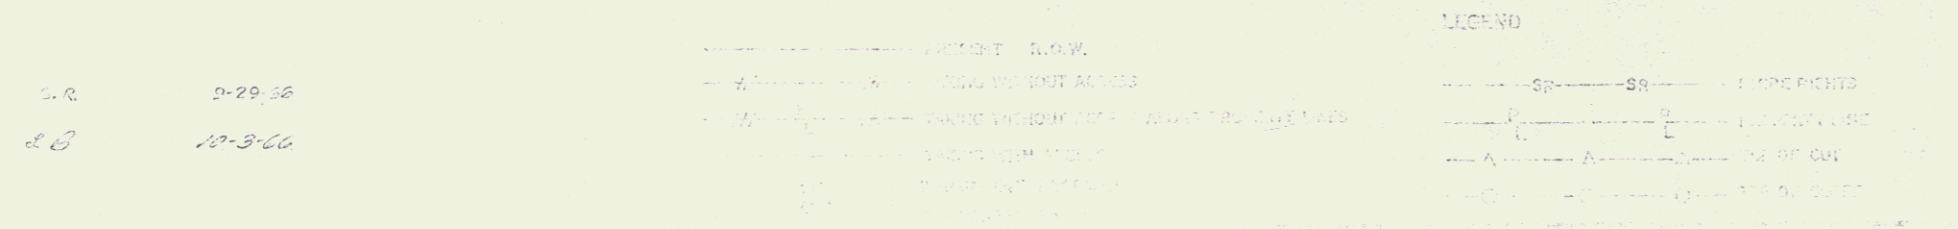

APPROVED: *Thomas E. Rosenthal* 10-10-66
 APPROVED: *Charles W. Lane* 10-13-66
 APPROVED: *H.P. Redington* 10-27-66

Stage I Construction
 BARTON - IRASBURG
 FO41 - 5(5)
 4
 8

POOR ORIGINAL COPY