


CONSTRUCT U-TURN  
 EB 1294+00-WB 1296+05

STONE FILL FOR SLOPE PROTECTION (LIGHT TYPE) ITEM 512

| STATION   | STATION | POS |
|-----------|---------|-----|
| WESTBOUND |         |     |
| 1293+30   | 1297+20 | ET  |
| EASTBOUND |         |     |
| 1293+20   | 1293+20 | ET  |

CONSTRUCT SPEED CHANGE LANE

| STATION   | STATION | POS |
|-----------|---------|-----|
| WESTBOUND |         |     |
| 1294+20   | 1294+20 | LT  |

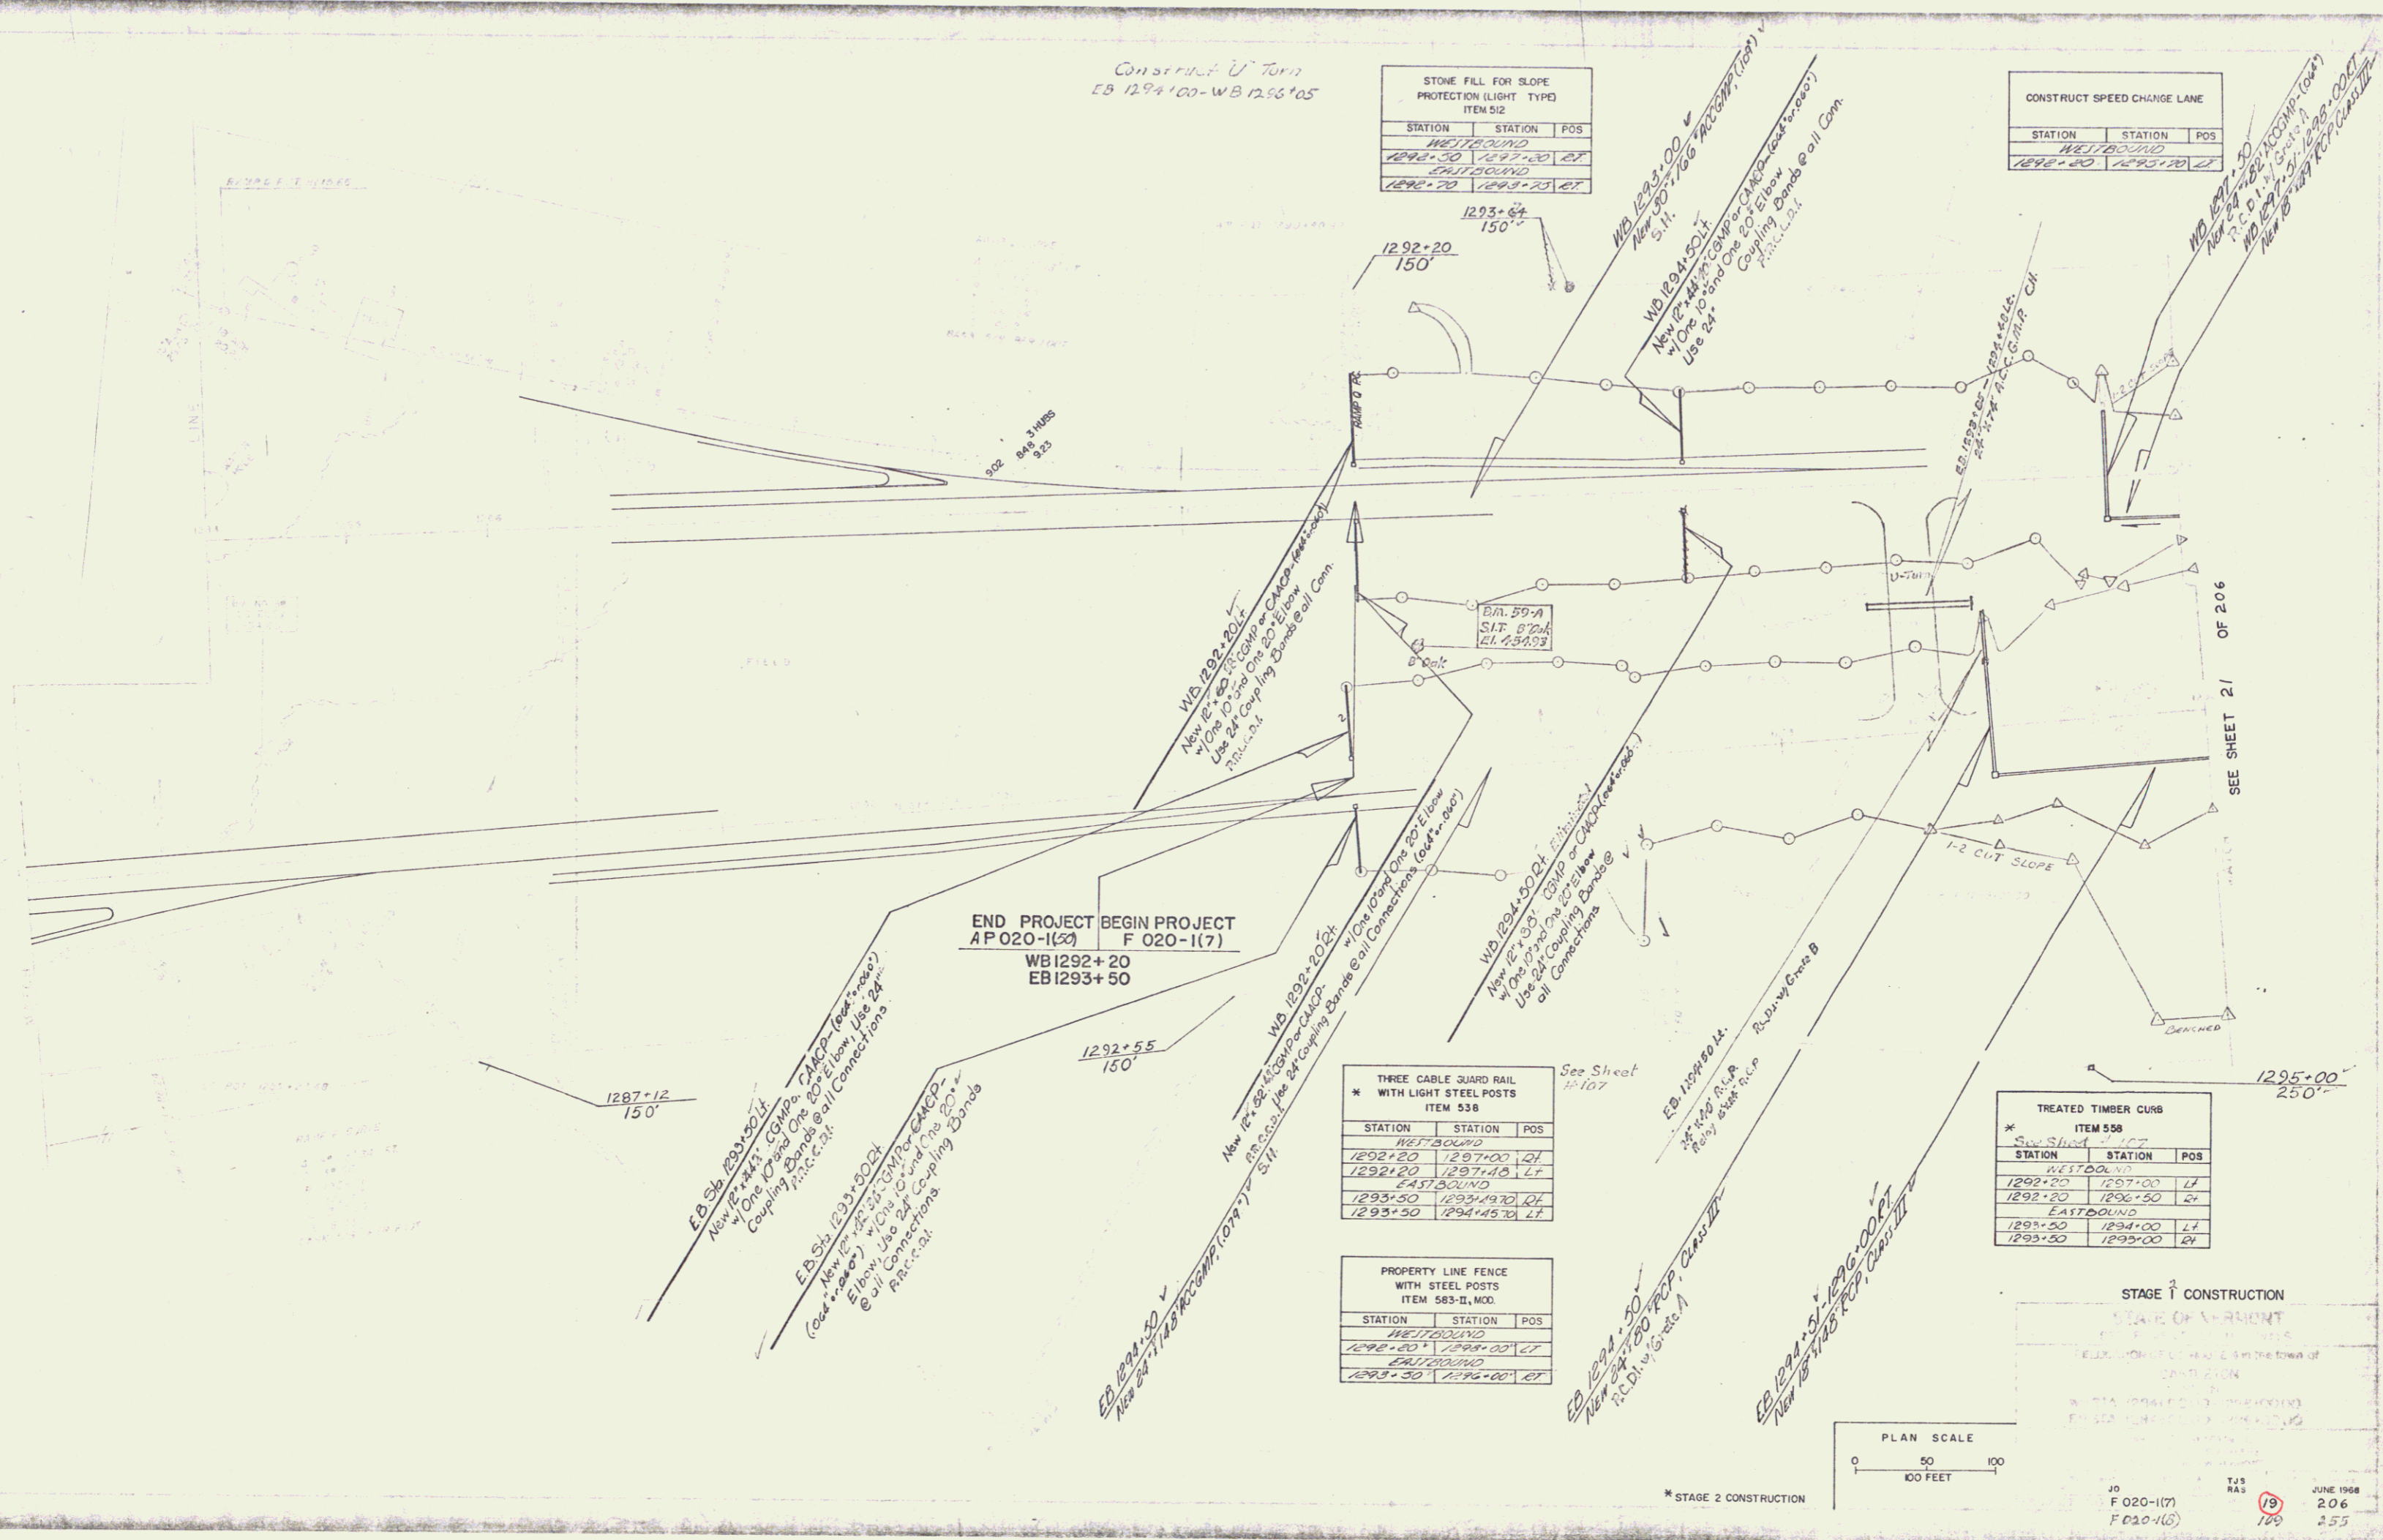

THREE CABLE GUARD RAIL WITH LIGHT STEEL POSTS ITEM 538


| STATION   | STATION | POS |
|-----------|---------|-----|
| WESTBOUND |         |     |
| 1292+20   | 1297+00 | LT  |
| 1292+20   | 1297+15 | LT  |
| EASTBOUND |         |     |
| 1293+50   | 1293+50 | LT  |
| 1293+50   | 1294+50 | LT  |

PROPERTY LINE FENCE WITH STEEL POSTS ITEM 583-II, MOD.

| STATION   | STATION | POS |
|-----------|---------|-----|
| WESTBOUND |         |     |
| 1292+20   | 1293+20 | ET  |
| EASTBOUND |         |     |
| 1293+30   | 1294+00 | ET  |

TREATED TIMBER CURB ITEM 558

| STATION   | STATION | POS |
|-----------|---------|-----|
| WESTBOUND |         |     |
| 1292+20   | 1297+00 | LT  |
| 1292+20   | 1296+50 | LT  |
| EASTBOUND |         |     |
| 1293+50   | 1294+00 | LT  |
| 1293+50   | 1293+00 | LT  |

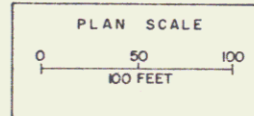

STAGE 2 CONSTRUCTION

STATE OF VERMONT  
 DEPARTMENT OF TRANSPORTATION  
 VERMONT HIGHWAY DEPARTMENT  
 PROJECT NO. F 020-1(7)  
 F 020-1(5)

TJS  
 RAS

JUNE 1968  
 206  
 255