
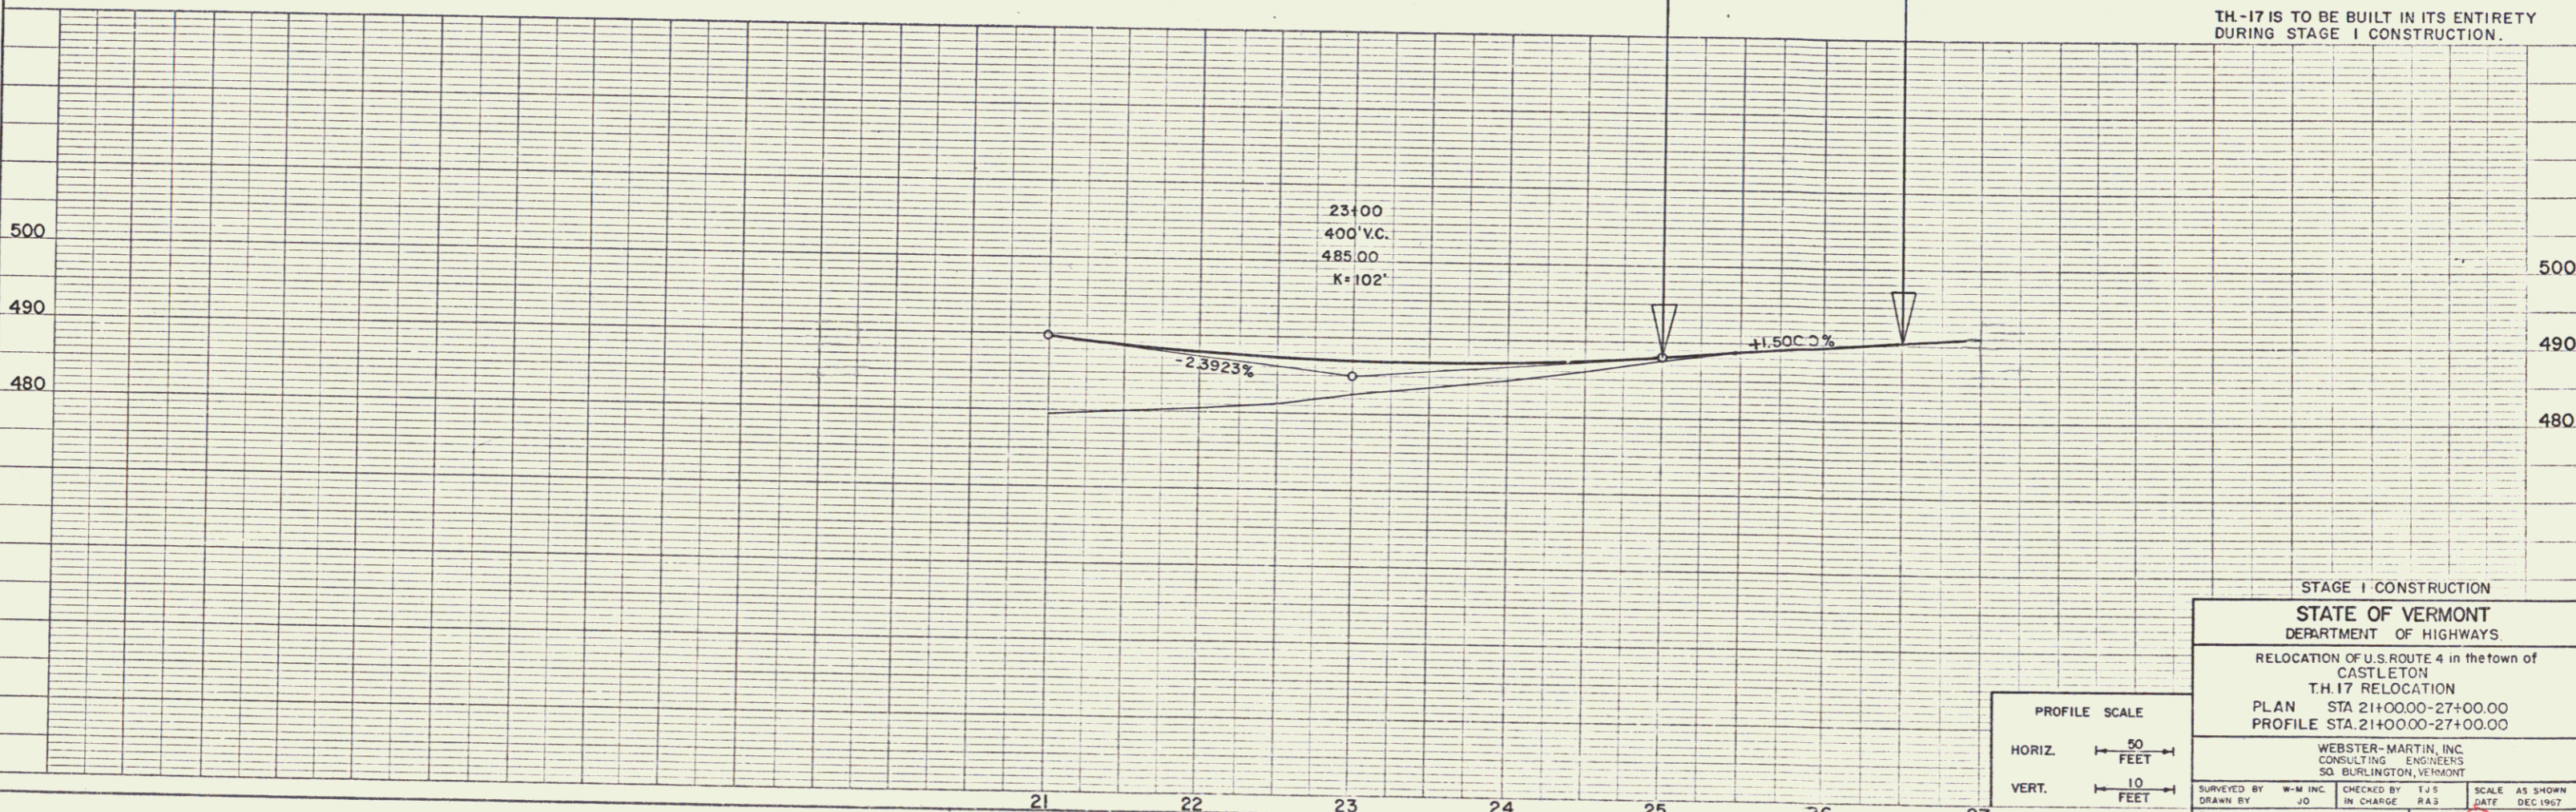


PLAN
 DRAWN BY: []
 CHECKED BY: []
 DATE: []

PROFILE
 DRAWN BY: []
 CHECKED BY: []
 DATE: []

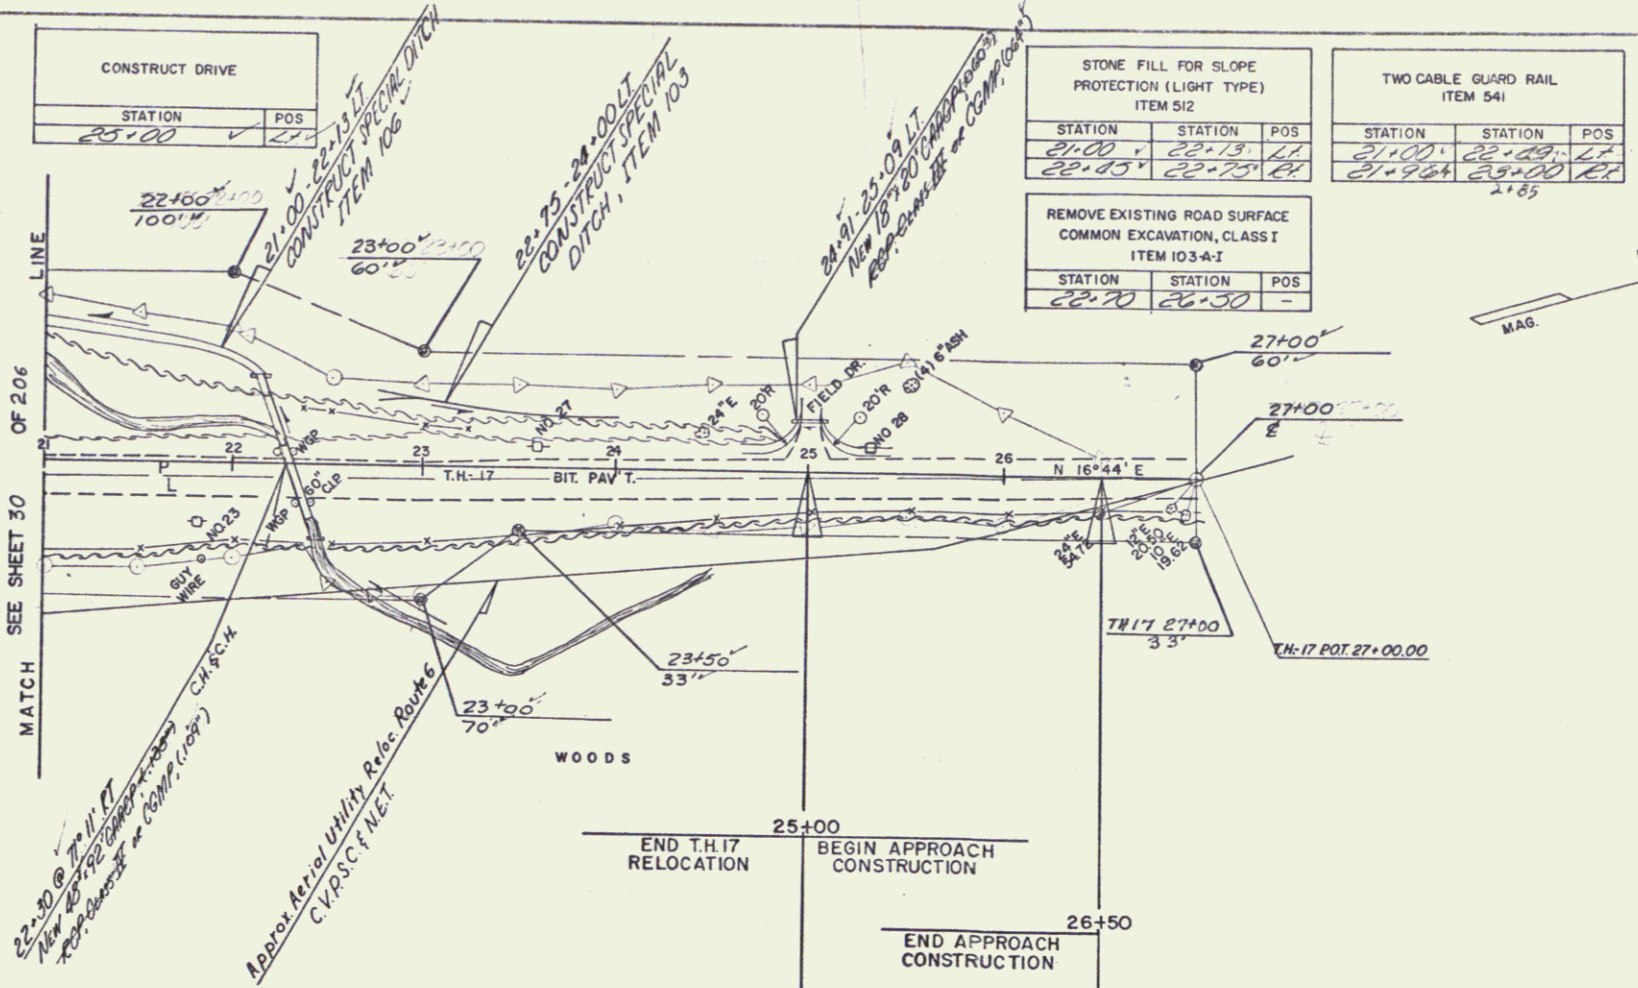

STAGE I CONSTRUCTION
 STATE OF VERMONT
 DEPARTMENT OF HIGHWAYS
 RELOCATION OF U.S. ROUTE 4 in the town of CASTLETON
 T.H. 17 RELOCATION
 PLAN STA 21+00.00-27+00.00
 PROFILE STA 21+00.00-27+00.00

WEBSTER-MARTIN, INC.
 CONSULTING ENGINEERS
 50 BURLINGTON, VERMONT

SURVEYED BY: W.M. INC. CHECKED BY: T.J.S. SCALE AS SHOWN
 DRAWN BY: [] IN CHARGE: P.A.S. DATE: DEC 1987
 PROJECT NO. F020-1(7) SHEET 52 OF 206

K-E PLATE 1: PLAN/PROFILE
 487617 IMPRINTED IN VERMONT