


* JUTE MATTING ITEM 623		
STATION	STATION	POS
1374+75	1375+00	LT

THREE CABLE GUARD RAIL WITH LIGHT STEEL POSTS ITEM 538		
STATION	STATION	POS
1368+00	1371+00	LT

STONE FILL FOR SLOPE PROTECTION (LIGHT TYPE) ITEM 512		
STATION	STATION	POS
1360+30	1362+30	LT
1362+30	1364+30	LT
1364+30	1366+30	LT
1366+30	1368+30	LT
1368+30	1370+30	LT
1370+30	1372+30	LT
1372+30	1374+30	LT
1374+30	1376+30	LT
1376+30	1378+30	LT
1378+30	1380+30	LT

PROPERTY LINE FENCE WITH STEEL POSTS ITEM 583-II, MOD		
STATION	STATION	POS
1360+00	1375+00	LT

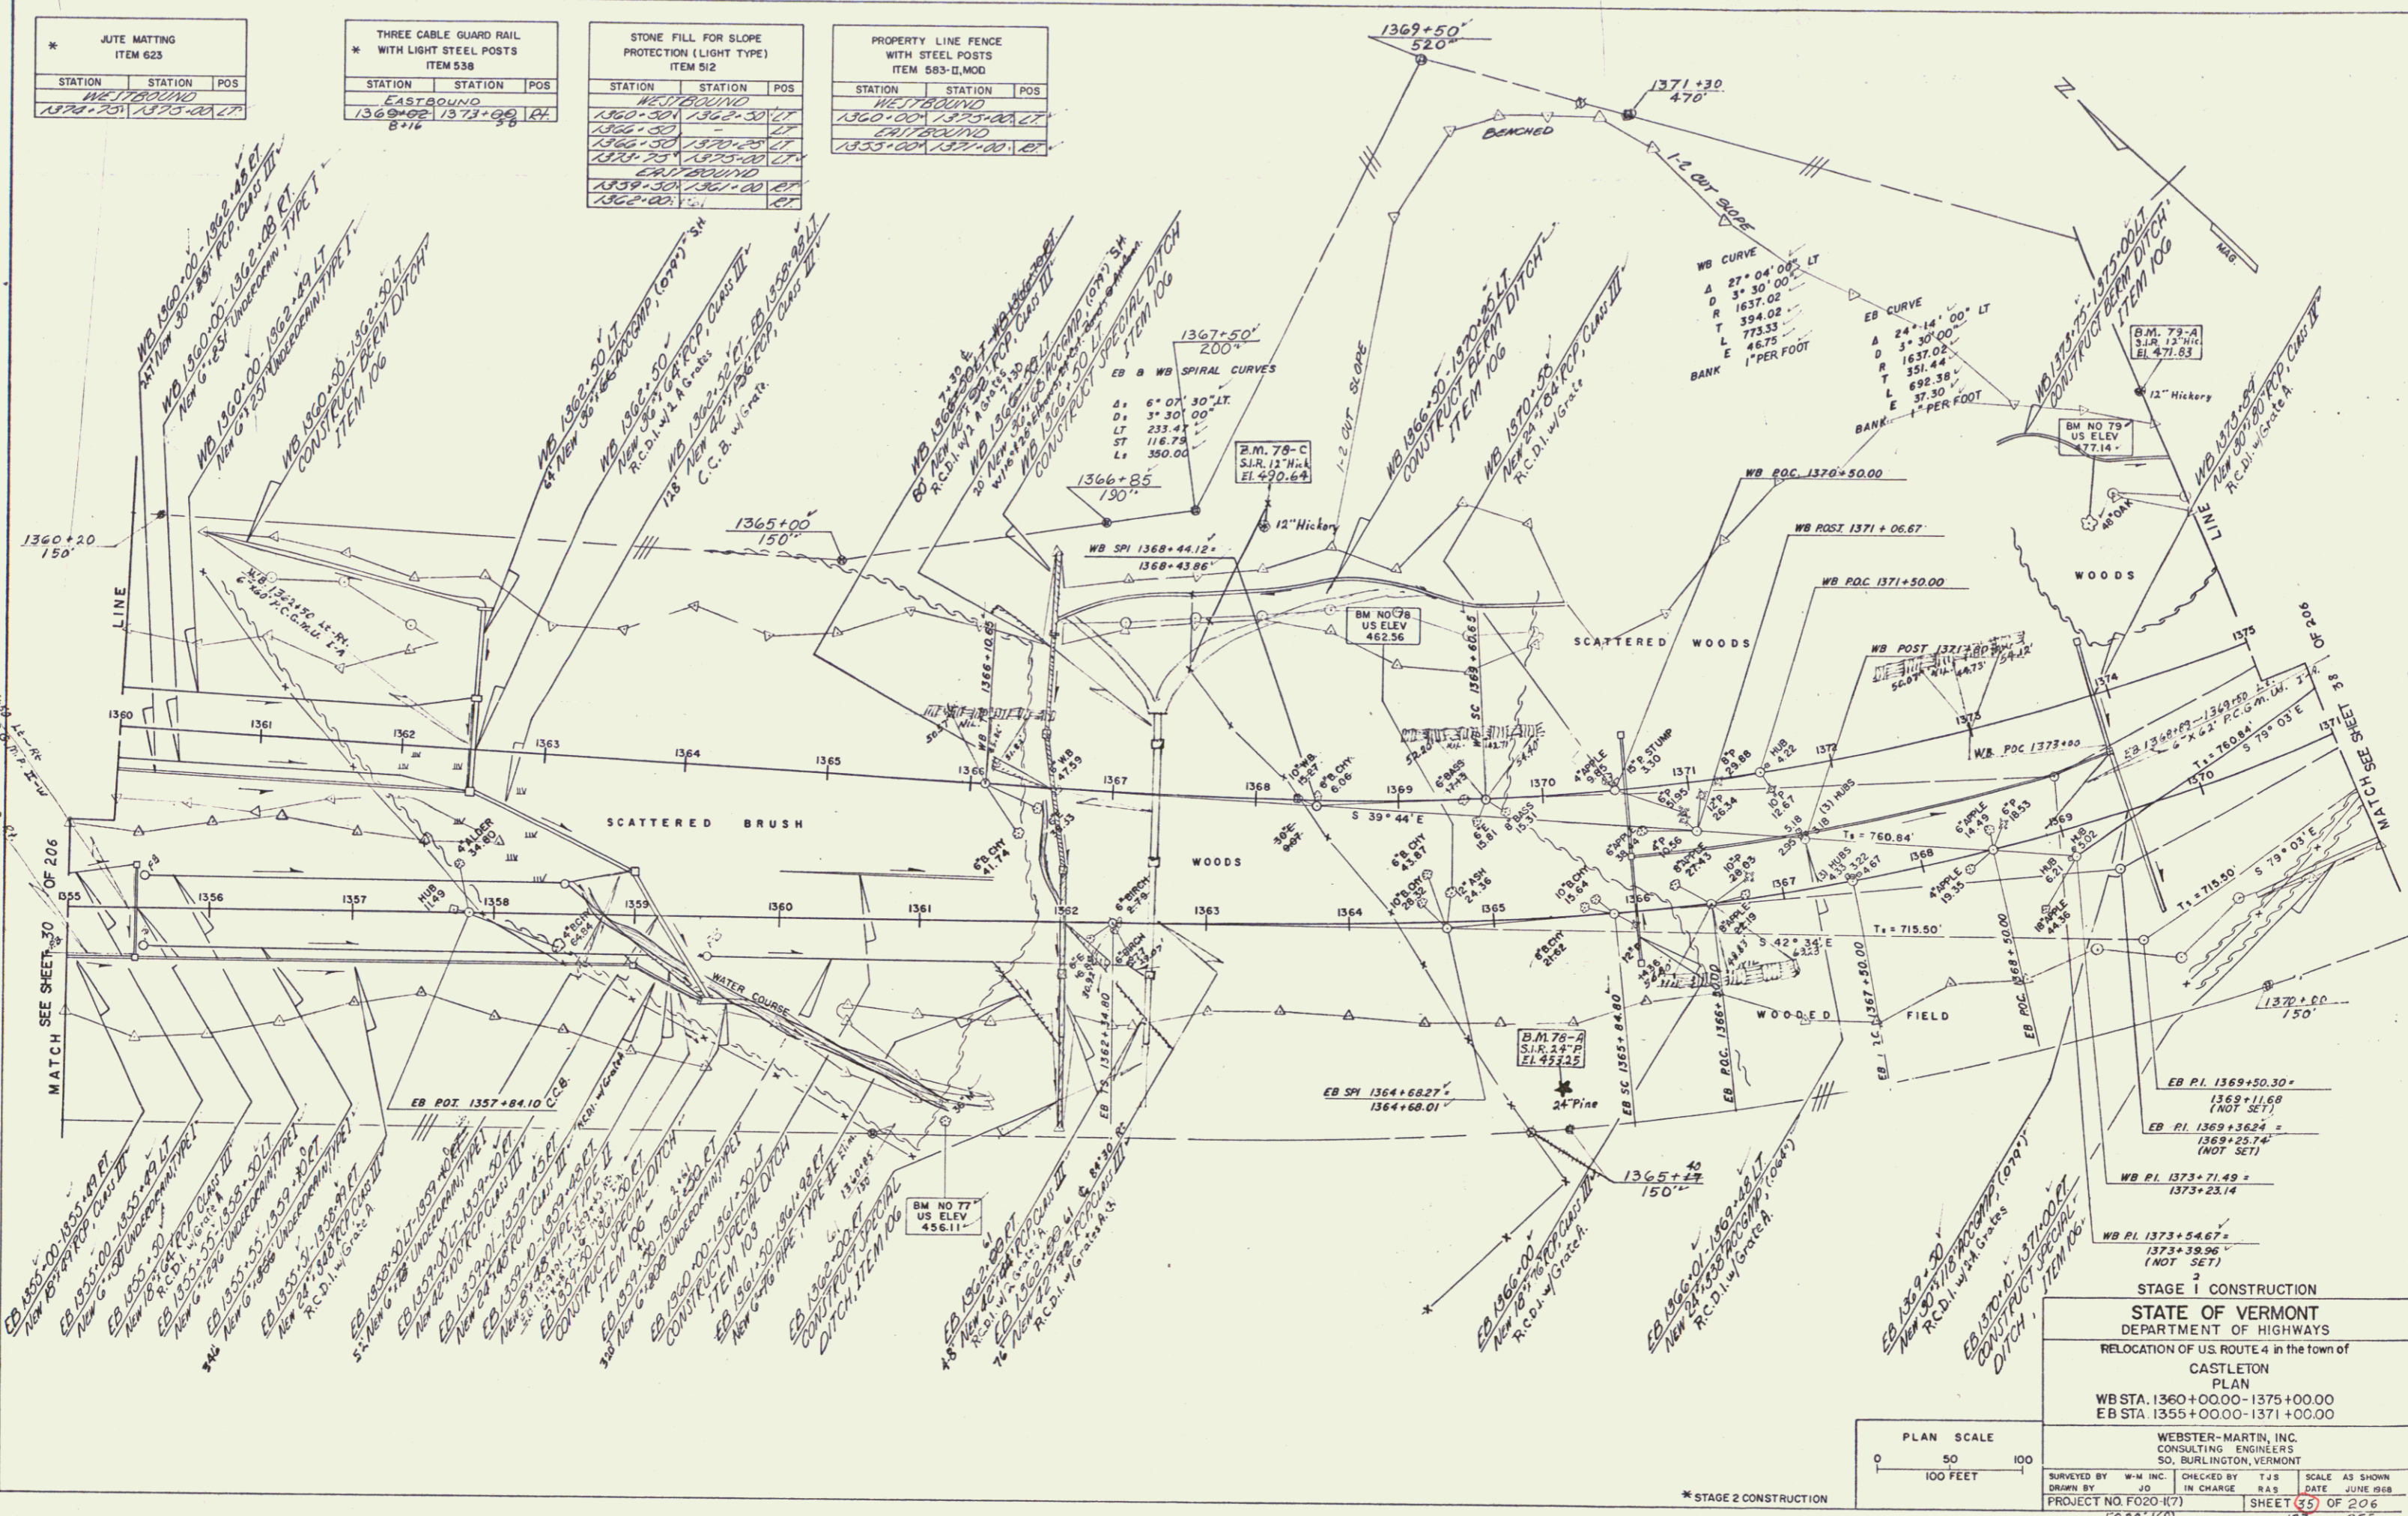

STAGE 1 CONSTRUCTION


**STATE OF VERMONT**  
DEPARTMENT OF HIGHWAYS

RELOCATION OF U.S. ROUTE 4 in the town of  
CASTLETON  
PLAN

WB STA. 1360+00.00-1375+00.00  
EB STA. 1355+00.00-1371+00.00

WEBSTER-MARTIN, INC.  
CONSULTING ENGINEERS  
50, BURLINGTON, VERMONT

SURVEYED BY W.M. INC. CHECKED BY T.J.S. SCALE AS SHOWN  
DRAWN BY J.D. IN CHARGE R.A.S. DATE JUNE 1958  
PROJECT NO. F020-1(7) SHEET 35 OF 206  
F020-1(8) 255

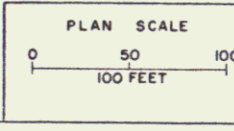

\* STAGE 2 CONSTRUCTION