

- 1 TITLE SHEET
- 2 ALIQUOT DATA SHEET
- 3-10 TYPICAL SECTIONS (MAINLINE)
- 11 TYPICAL SECTION SHOWING SURCHARGE LOAD PLACEMENT
- 12 PIEZOMETER & SETTLEMENT PLATFORM LOCATION SHEET
- 13-17C QUANTITY SHEETS
- 18-24 DRAINAGE SHEETS
- 25-39 EARTHWORK SHEETS
- 40-45 ROW DETAIL SHEETS
- 46 BLANK
- 47-53 PLAN & PROFILE SHEETS
- 54-59 2D SCAL PROFILE SHEETS
- 60-65 DETAILS OF ADAPTERS FOR CATCH BASINS & DROP INLETS
- 66-104 TRAFFIC SIGN SHEETS
- 105 UTILITY STRUCTURE DETAILS (RELOC. OF WATER SUPPLY LINE)
- 106 BR SERIES 500 RELOC. U.S. 4 OVER CASTLETON RIVER
- 107 BR SERIES 400 SA 6 OVER RELOC. U.S. 4
- 108-113 DETAILS OF 96" CGMP @ EB 1073.4
- 114-117 DETAILS OF 96" CGMP @ EB 1058.4
- 118-119 DETAILS OF 96" CGMP @ RAMP E 10+00.4
- 120-124 BR SERIES 500 RELOC. U.S. 4 OVER RELOC. VT. 22-A
- 125-128 DETAILS OF 96" CGMP @ VT. 22-A 71+00.4
- 129-132 BR SERIES 500 RELOC. U.S. 4 OVER TH 21
- 133-136 BR SERIES 700 RELOC. SA 5 OVER RELOC. U.S. 4
- 239-240 BLANK
- 241 A-60 SOLID ROCK EXCAVATION (IN AREAS OVER 50 MPH) 1-17-69 R
- 242 A-61 SOLID ROCK EXCAVATION (IN AREAS UNDER 50 MPH) 8-7-67 R
- 243 B-1 BANKING TABLES 7-17-67 R
- 244 B-5 TYPICAL SLOPE GRADING 3-10-65
- 245 B-6 MUCK EXCAVATION 3-10-65
- 246 B-10 EMBANKMENT ON A SLOPE 3-10-65
- 247 B-11 METHODS OF SLOPE STABILIZATION 3-10-65
- 248 C-1 CURBS 10-23-68 R
- 249 C-1a CURBS 3-10-65
- 250 D-2 HIC-20 WALLS & UNDERDRAIN 7-25-67 R
- 251 D-3 JUTE MATTING & UNGRADED GUTTERS 7-19-67 P
- 252 UNDERDRAIN FLUSHING BASINS & ELBOWS 12-4-68 R
- 253 RC. DROP INLETS W/ GRATES 12-23-66
- 254 D-9 RC. DROP INLETS 3-10-65
- 255 D-10 DROP INLET TOPS 3-10-65
- 256 D-11 DROP INLET TOPS 3-10-65
- 257 D-11a DETAILS OF GRATES & COVERS 3-10-65
- 258 D-13 CATCH BASIN OR MOUND 3-10-65
- 259 D-16 DROP INLET TYPE II 7-18-67 R
- 260 D-17 ACCOMP. VERTICAL RISER 7-1-68 R
- 261 BLANK
- 262 E-15 REGULATORY SIGNS 8-12-63 R
- 263 E-16 WARNING SIGNS 12-18-64 R
- 264 E-20 DELINEATORS, HAZARD MARKERS & MILEPOSTS 11-7-67 R
- 265 BLANK
- 266 E-26 STANDARD SIGN PLACEMENT 2-6-68
- 267 E-31 FEDERAL AID CONSTRUCTION IDENTIFICATION SIGNS 8-21-67 R
- 268 E-32 ROAD CONSTRUCTION APPROACH SIGNS 1-6-67
- 269 E-34 ON PROJECT CONSTRUCTION SIGNS 5-3-67 R
- 270 E-31 CONCRETE BASES AND PUL. BOXES 2-20-68 R
- 271 F-1 PROPERTY LINE FENCE 11-29-67 R
- 272 F-2 GALVANIZED CHAIN-LINK FENCE 5-26-67 R
- 273 F-3 ALUMINUM ALLOY CHAIN-LINK FENCE 5-26-67 R
- 274 G-2a TWO CABLE GUARD RAIL 12-3-68 R
- 275 G-3 THREE CABLE GUARD RAIL 9-1-66 R
- 276 G-3a DEAD END ANCHORAGE @ BRIDGE 2-8-66 R
- 277 G-4 PLANK GUARD RAIL 12-30-65 R
- 278 G-6 THREE CABLE GUARD RAIL W/ LIGHT STEEL POSTS 3-21-68 R
- 279 G-7 THREE CABLE GUARD RAIL W/ LIGHT STEEL POSTS 3-21-68 R
- 280 J-1 BOUNDARY MARKERS 3-10-65
- 281 L-1 SETTLEMENT PLATFORMS 7-22-68
- 282 L-3 PIEZOMETERS 12-9-68
- 283 BLANK
- 284 SCB-D1-67 GENERAL INFORMATION & NOTES 1-24-68
- 285 SCB-D2-67 DETAILS A,B,C 1-24-68
- 286 SCB-D3-67 PLAN & REINFORCEMENT LAYOUT @ ABUTMENT 1-24-68
- 287 SCB-D4-67 PLAN & REINFORCEMENT LAYOUT @ PIER 1-24-68
- 288 SCB-D5-67 CONSTRUCTION JOINT DETAILS 1-24-68
- 289 SB -R1-64 ALUMINUM BRIDGE RAILING DETAILS SH 1 7-31-68 R
- 290 SB -R1-64 ALUMINUM BRIDGE RAILING DETAILS SH 2 8-8-68 R
- 291 SB -R2-65 ALUMINUM BRIDGE RAILING DETAILS SH 1 7-31-68 R
- 292 SB -AS-65 DETAILS OF APPROACH SLAB 7-24-67 R
- 293 SB -P1-65 CAST-IN-PLACE CONCRETE PILING 11-8-66
- 294 G-8 BRIDGE MATING FOR BRIDGE APPROACHES 2-13-68 R
- 295 G-9 BRIDGE MATING FOR BRIDGE APPROACHES 8-21-67 R
- 296-431 MAINLINE CROSS SECTIONS
- 432-473 RAMP CROSS SECTIONS
- 474-483 SA 6 CROSS SECTIONS
- 484-487 TH 21 CROSS SECTIONS
- 488-501 SA 5 CROSS SECTIONS
- 502-526 CHANNEL SECTIONS
- 527-532 DRAINAGE SECTIONS
- 532A-532I DISPOSAL AREA FOR UNSUITABLE MATERIAL.

TOWN OF FAIR HAVEN COUNTY OF RUTLAND RELOCATION OF U.S. ROUTE 4 L.A. FAIR HAVEN-WEST RUTLAND ROAD

BEGINNING AT A POINT APPROXIMATELY 0.010 MILES
EASTERLY OF THE NEW YORK-VERMONT STATE LINE AND
PROCEEDING EASTERLY 2.990 MILES

LENGTH OF ROADWAY 5,321.21 FEET 2.902 MILES
LENGTH OF BRIDGES 468.32 FEET 0.086 MILES
LENGTH OF PROJECT 15,789.53 FEET 2.990 MILES

TRAFFIC DATA				
1965	ADT	3,600	3,800	2,600
1995	ADT	7,490	7,850	5,450
1995	DHV	1,010	1,050	770
	D	52%	55%	57%
	T	8%	7%	9%
	V	60 MPH	60 MPH	60 MPH


FOR RECORD PLANS, MATERIALS, ETC. SEE
SHEET NO. 6.

PROJECT S 1142 (3)
BEGINNING AT THE POINT OF INTERSECTION OF
U.S. ROUTE 4 AND STATE AID ROUTE 5 AND
PROCEEDING NORTHERLY 0.187 MILES

LENGTH OF PROJECT 987.00 FEET = 0.187 MILES

TRAFFIC DATA				
1965	ADT	150		
1985	ADT	2300		
1985	DHV	315		
	D	54%		
	T	8%		
	V	50 MPH		

INDEX OF SHEETS	
1a	TITLE SHEET
2a	TYPICAL SECTION, BITUMINOUS CONCRETE PAVEMENT, ITEM 361, MOD.
3a	QUANTITY SHEET
4a	DRAINAGE SHEET
5a	GRADE AND EARTHWORK SHEET
6a-9a	PLAN AND PROFILE SHEETS
10a	B-5 TYPICAL SLOPE GRADING
11a-9	ROW DETAIL SHEETS
12a	C-1 CURBS
13a	C-1a CURBS
14a	C-2a SIDEWALK AND DRIVES
15a	C-2b SIDEWALK AND DRIVES
16a	D-2 UNDERDRAIN AND HEADWALLS
17a	D-4 CAST IRON COVERS FOR FLUSHING BASINS
18a	D-8 DROP INLETS
19a	D-9 DROP INLET TOPS
20a	D-10 DROP INLET TOPS
21a	D-11 DETAILS OF GRATES AND COVERS
22a	E-31 FEDERAL AID CONSTRUCTION IDENTIFICATION SIGNS
23a	E-32 ROAD CONSTRUCTION APPROACH SIGNS
24a	E-34 ON-PROJECT CONSTRUCTION SIGNS
25a	G-4 WOOD AND STEEL MARKER POSTS
26a	J-1 PROJECT MARKERS, BOUNDARY MARKERS
27a-31a	TRAFFIC SIGNS
32a-40a	SECTIONS
41a	DRAINAGE SECTIONS

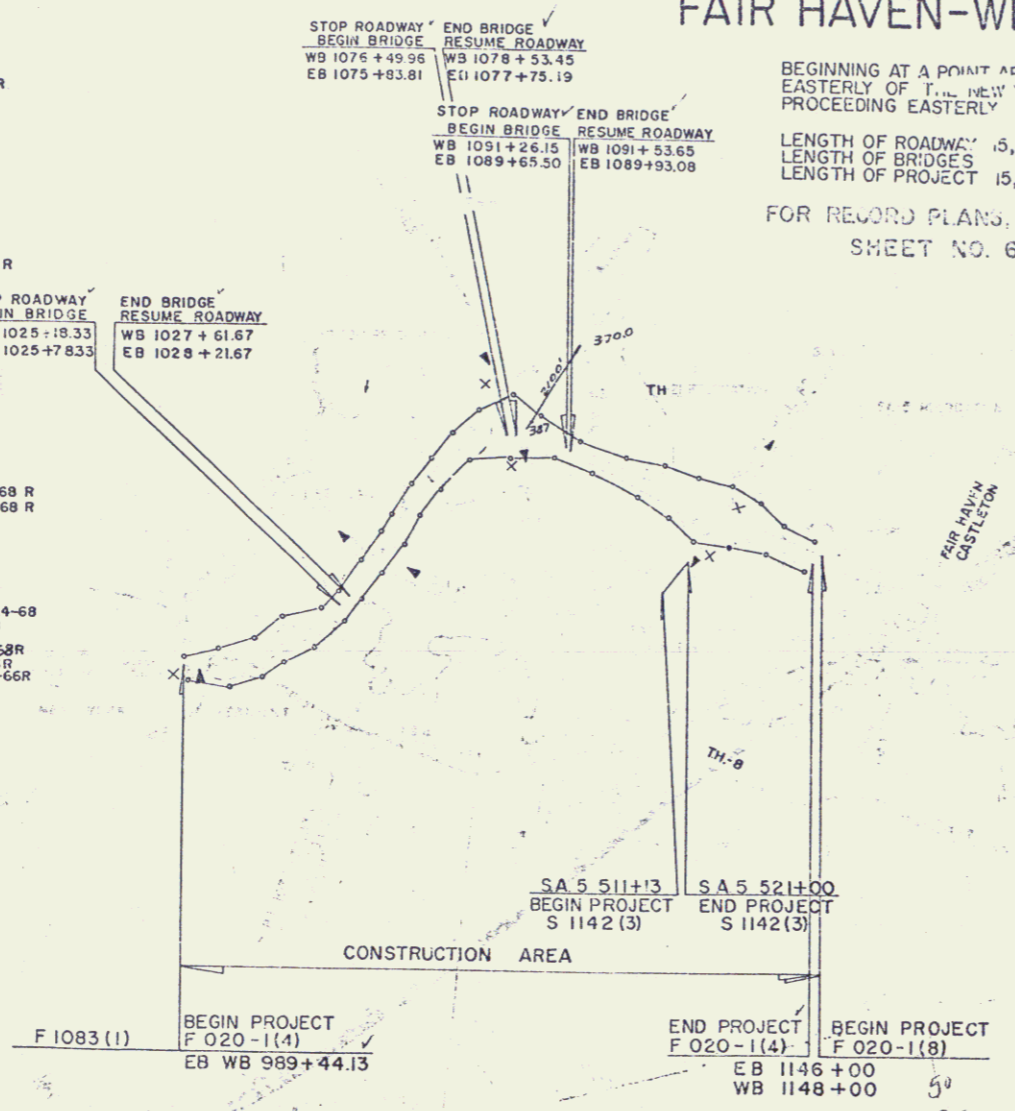

FAIR HAVEN F 020-1(4)
 COUNTY OF RUTLAND
 MERIDEN, CT
 06450
 10/31/67
 R.F. PLUMS - A.S. SPIDLE

APPROVED: *[Signature]*
 DATE: 10/10/67

[Signature]
 10/10/67

[Signature]
 14 Feb 69

[Signature]
 10/10/67

[Signature]
 10/10/67

[Signature]
 10/10/67

Permitted To R.O.W. Division
 10/31/67

532

2