

PROPERTY LINE FENCE WITH STEEL POSTS ITEM 583-II MOD.		
STATION	STATION	POS
987+65	997+75	LT
997+75	1007+85	LT
997+85	1007+95	RT
1007+95	1017+05	RT
1017+05	1027+15	RT

THREE CABLE GUARD RAIL WITH STEEL POSTS ITEM 542		
STATION	STATION	POS
989+45	991+00	RT
991+00	993+00	LT
993+00	995+00	RT
995+00	997+00	LT

DEMOLITION AND DISPOSAL OF BUILDINGS ITEM 586	
STATION	POS
997+00	997+00
997+00	997+00
997+00	997+00

GRANITE SLOPE EDGING ITEM 556-A		
STATION	STATION	POS
995+27	995+80	RT
995+80	997+10	RT

VERTICAL GRANITE CURB ITEM 556-B		
STATION	STATION	POS

STONE FILL FOR SLOPE PROTECTION (LIGHT TYPE) ITEM 52		
STATION	STATION	POS
997+55	997+100	RT

REMOVAL AND DISPOSAL OF PRESENT GUARD RAIL ITEM 549		
STATION	STATION	POS
993+00	993+00	LT
993+00	993+00	RT
993+00	993+00	RT

EXCAVATION AND REMOVAL OF ROAD SURFACES AND/OR PAVEMENTS ITEM 119		
STATION	STATION	POS

BITUMINOUS CONCRETE SURFACE FOR GUTTERS AND TRAFFIC ISLANDS ITEM 554 MOD.		
STATION	STATION	POS
995+27	995+80	RT
995+80	997+10	RT


Note: 1000+25 - 1004+00 WBLI. Property Line Fence to be Constructed prior to commencement of other work in this area.

Demoving and Reinstalling Three Cable Guard Rail Item 548-B		
Station	Station	Pos
993+00	993+00	LT
993+00	993+00	RT
993+00	993+00	RT


* BOX BEAM GUARD RAIL ITEM 550-A		
STATION	STATION	POS
1000+25	1003+00	LT
1003+00	1003+00	RT
1003+00	1003+00	RT

RIPRAP (LIGHT TYPE) ITEM 513-B		
STATION	STATION	POS
997+00	997+50	LT

B.P. DETOUR Curve Data Curves #1 & 2
D: 7°00'00"
P: 810.51'
L: 204.29'
T: 102.60'
D: 14°18'01"

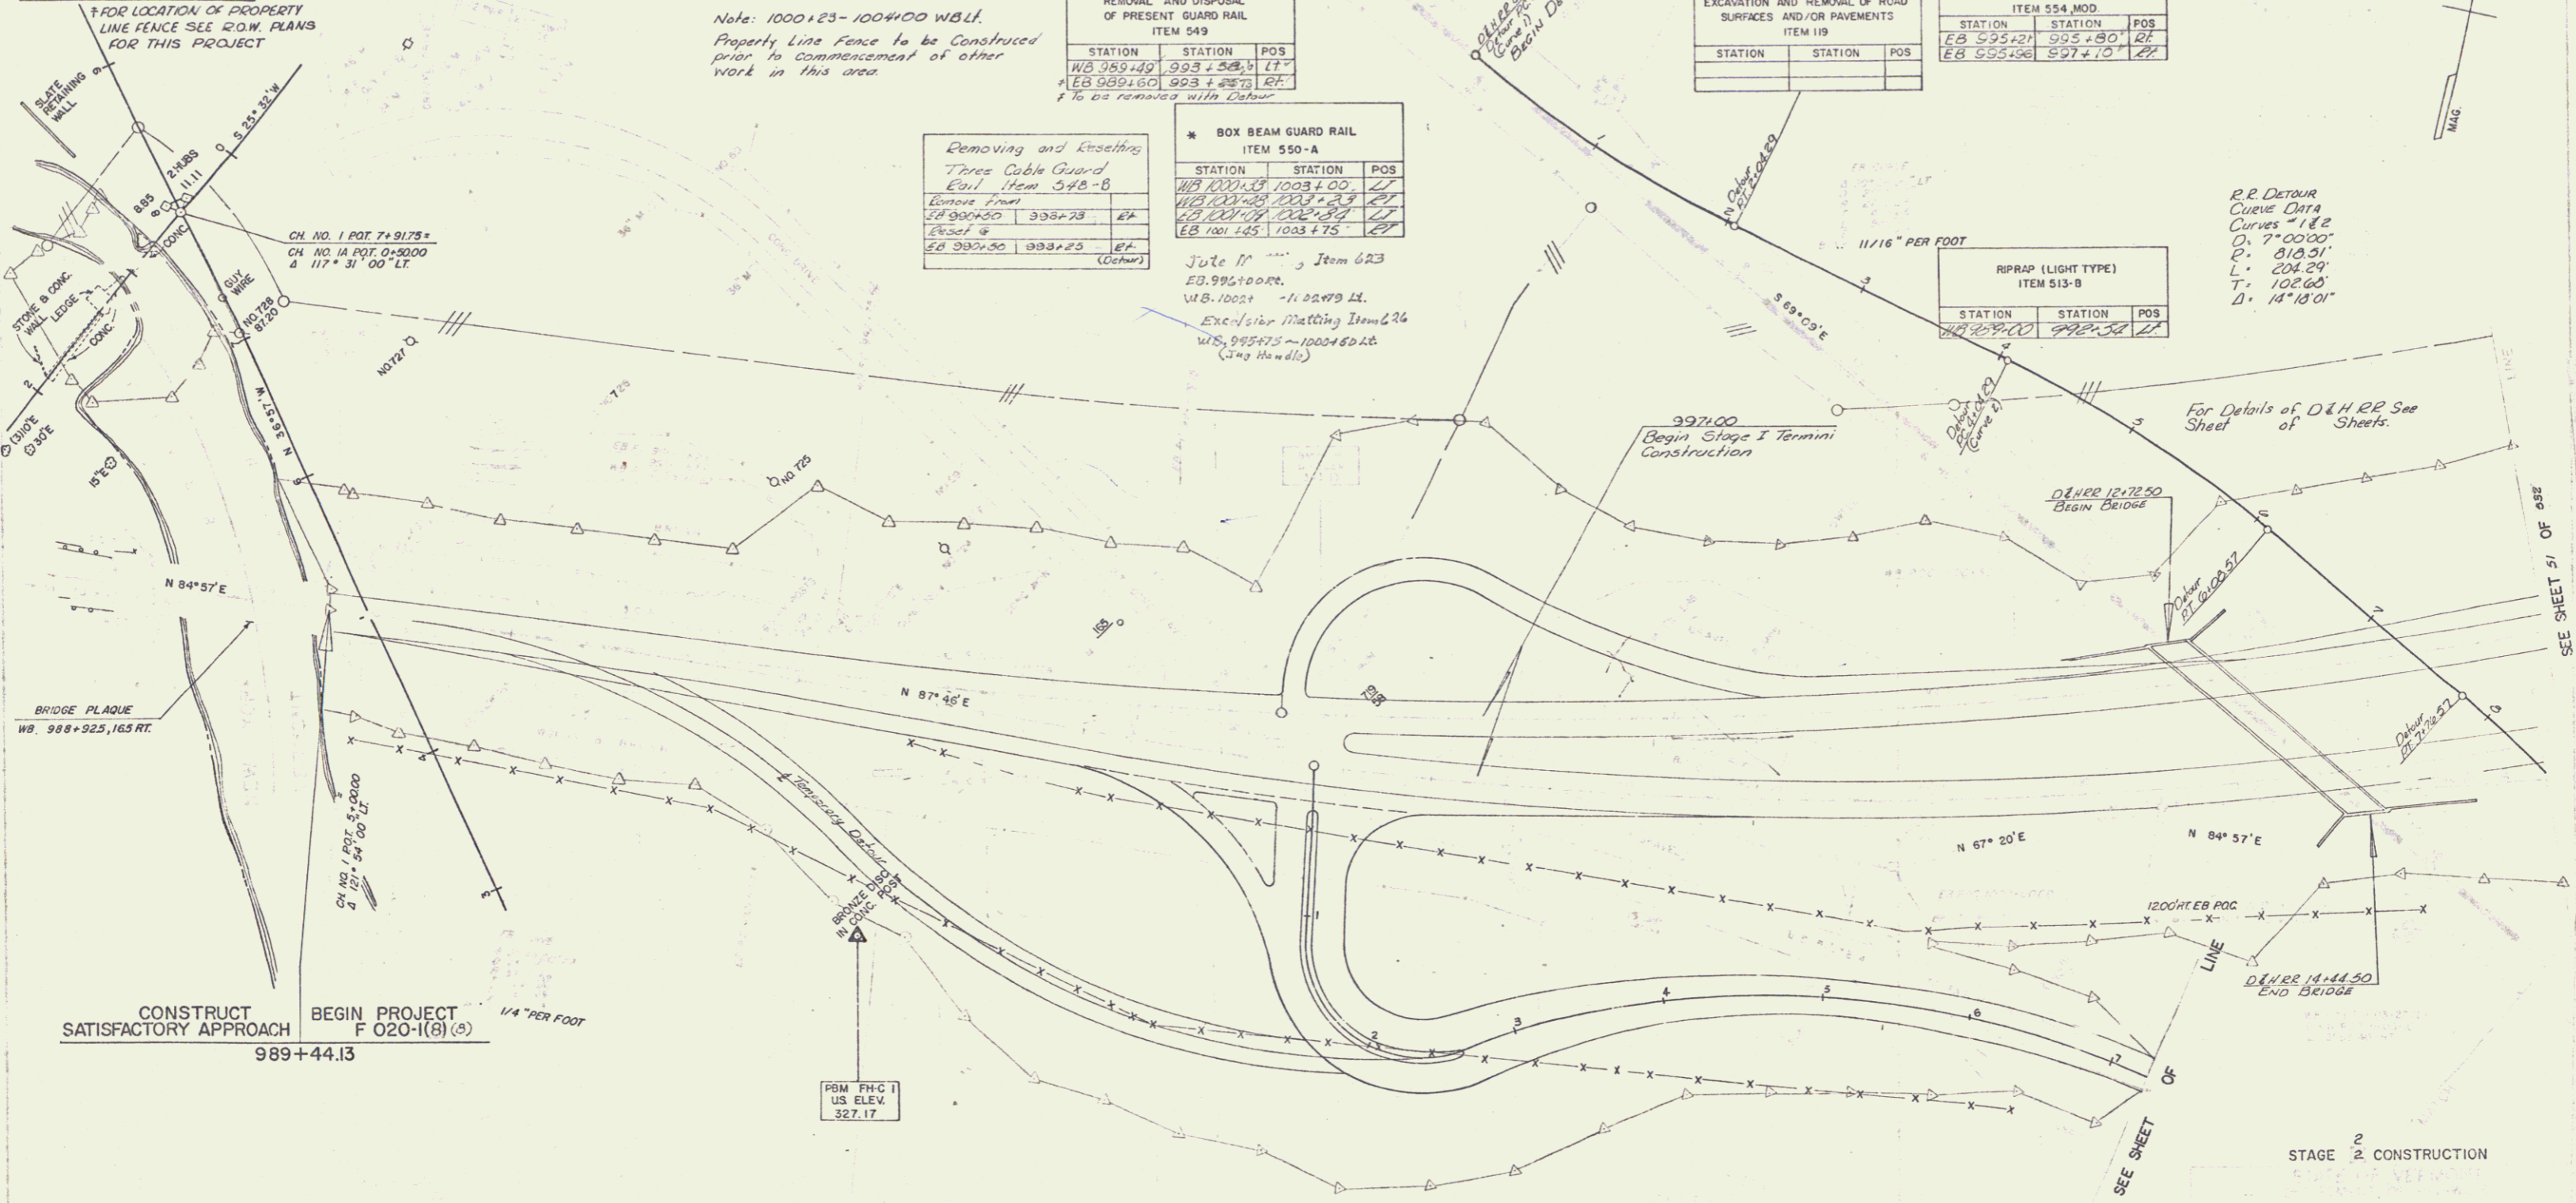

FOR PAVEMENT WIDTHS AND ELEVATIONS, (EB LANE, WB LANE AND TEMPORARY CONNECTOR) SEE SHEETS 48 & 49 OF 52

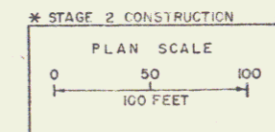

STAGE 2 CONSTRUCTION
RELOCATION OF U.S. ROUTE 4 in the town of FAIR HAVEN PLAN STA 988+00.00 - 1004+00.00

HEM F 020-1(1) 48 52 255