

JUTE MATTING ITEM 623		
STATION	STATION	POS
78+00	81+00	LT

GRANITE SLOPE EDGING ITEM 556-A		
STATION	STATION	POS
78+00	78+41.88	LT

CONSTRUCT DRIVE NON-GOVERNMENT PROP.		
STATION	STATION	POS
78+50	78+50	RT

THREE CABLE GUARD RAIL WITH LIGHT STEEL POSTS ITEM 559		
STATION	STATION	POS
77+00	77+00	RT


Excavation of Road Surf at 76+00

STONE FILL FOR SLOPE PROTECTION (LIGHT TYPE) ITEM 512		
STATION	STATION	POS
74+00	75+25	LT

BITUMINOUS CONCRETE SURFACE FOR GUTTERS AND TRAFFIC ISLANDS		
STATION	STATION	POS
75+00	75+41.88	RT

PROPERTY LINE FENCE WITH STEEL POSTS ITEM 583-II, MOD.		
STATION	STATION	POS
74+00	81+00	LT

VT 22-A CURVE
 Δ 11° 34' 12"
 S.P. 6+11.25
 L 211.17
 E 14.45
 MARK 76+32.25

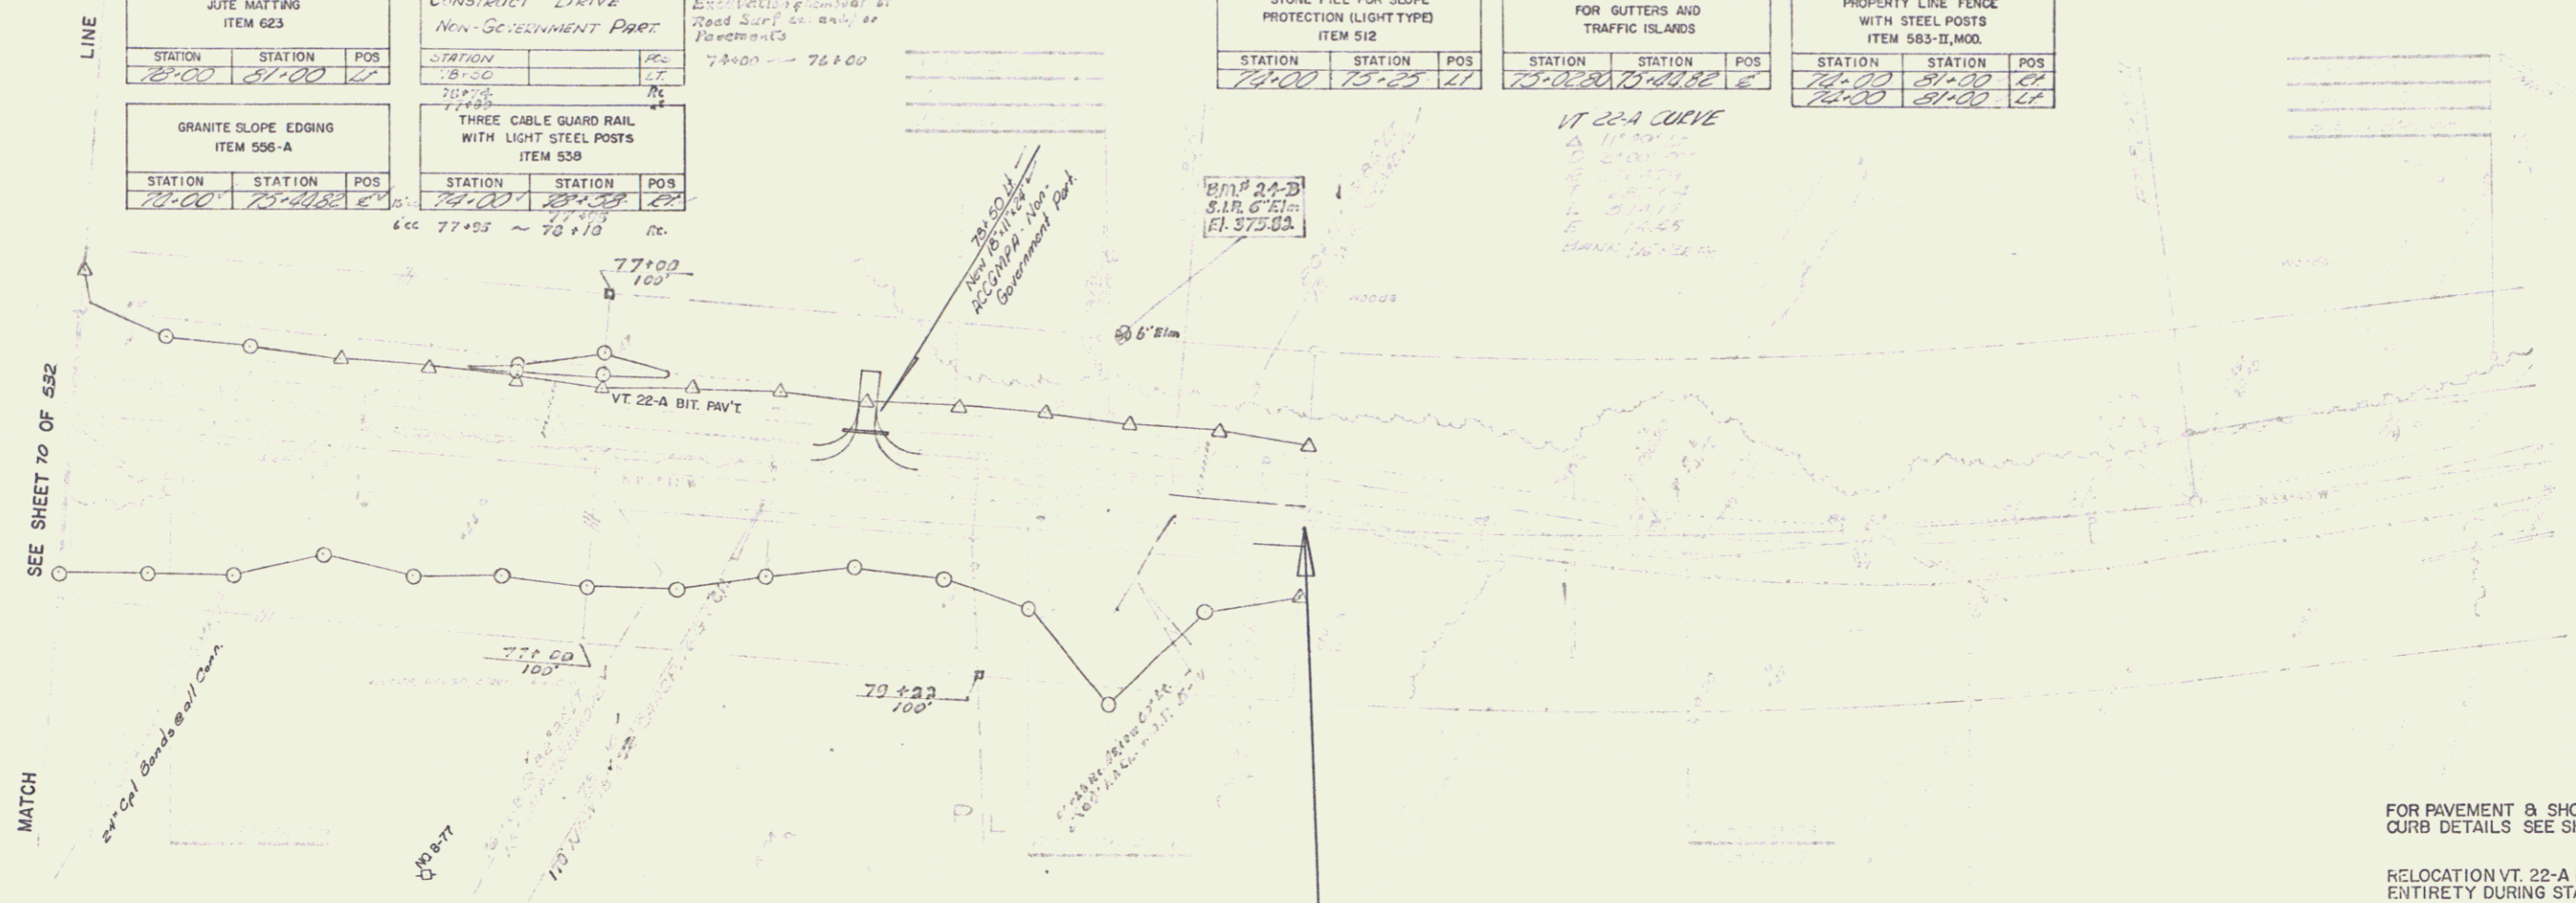

FOR PAVEMENT & SHOULDER WIDTH AND CURB DETAILS SEE SHEET OF
 RELOCATION VT. 22-A IS TO BE BUILT IN ITS ENTIRETY DURING STAGE I CONSTRUCTION.

81+00
 END VT. ROUTE 22-A RELOCATION F 020-1(4)
 RESUME PROJECT S 0159(2)

76+25
 850' VC
 359.17
 K=327
 +0.5954%

+3.1940%

STAGE I CONSTRUCTION

72 532 F020-1(4)

16