


PLAN	DATE
BY	
CHECKED	
DATE	
NO.	

PROFILE	DATE
BY	
CHECKED	
DATE	
NO.	

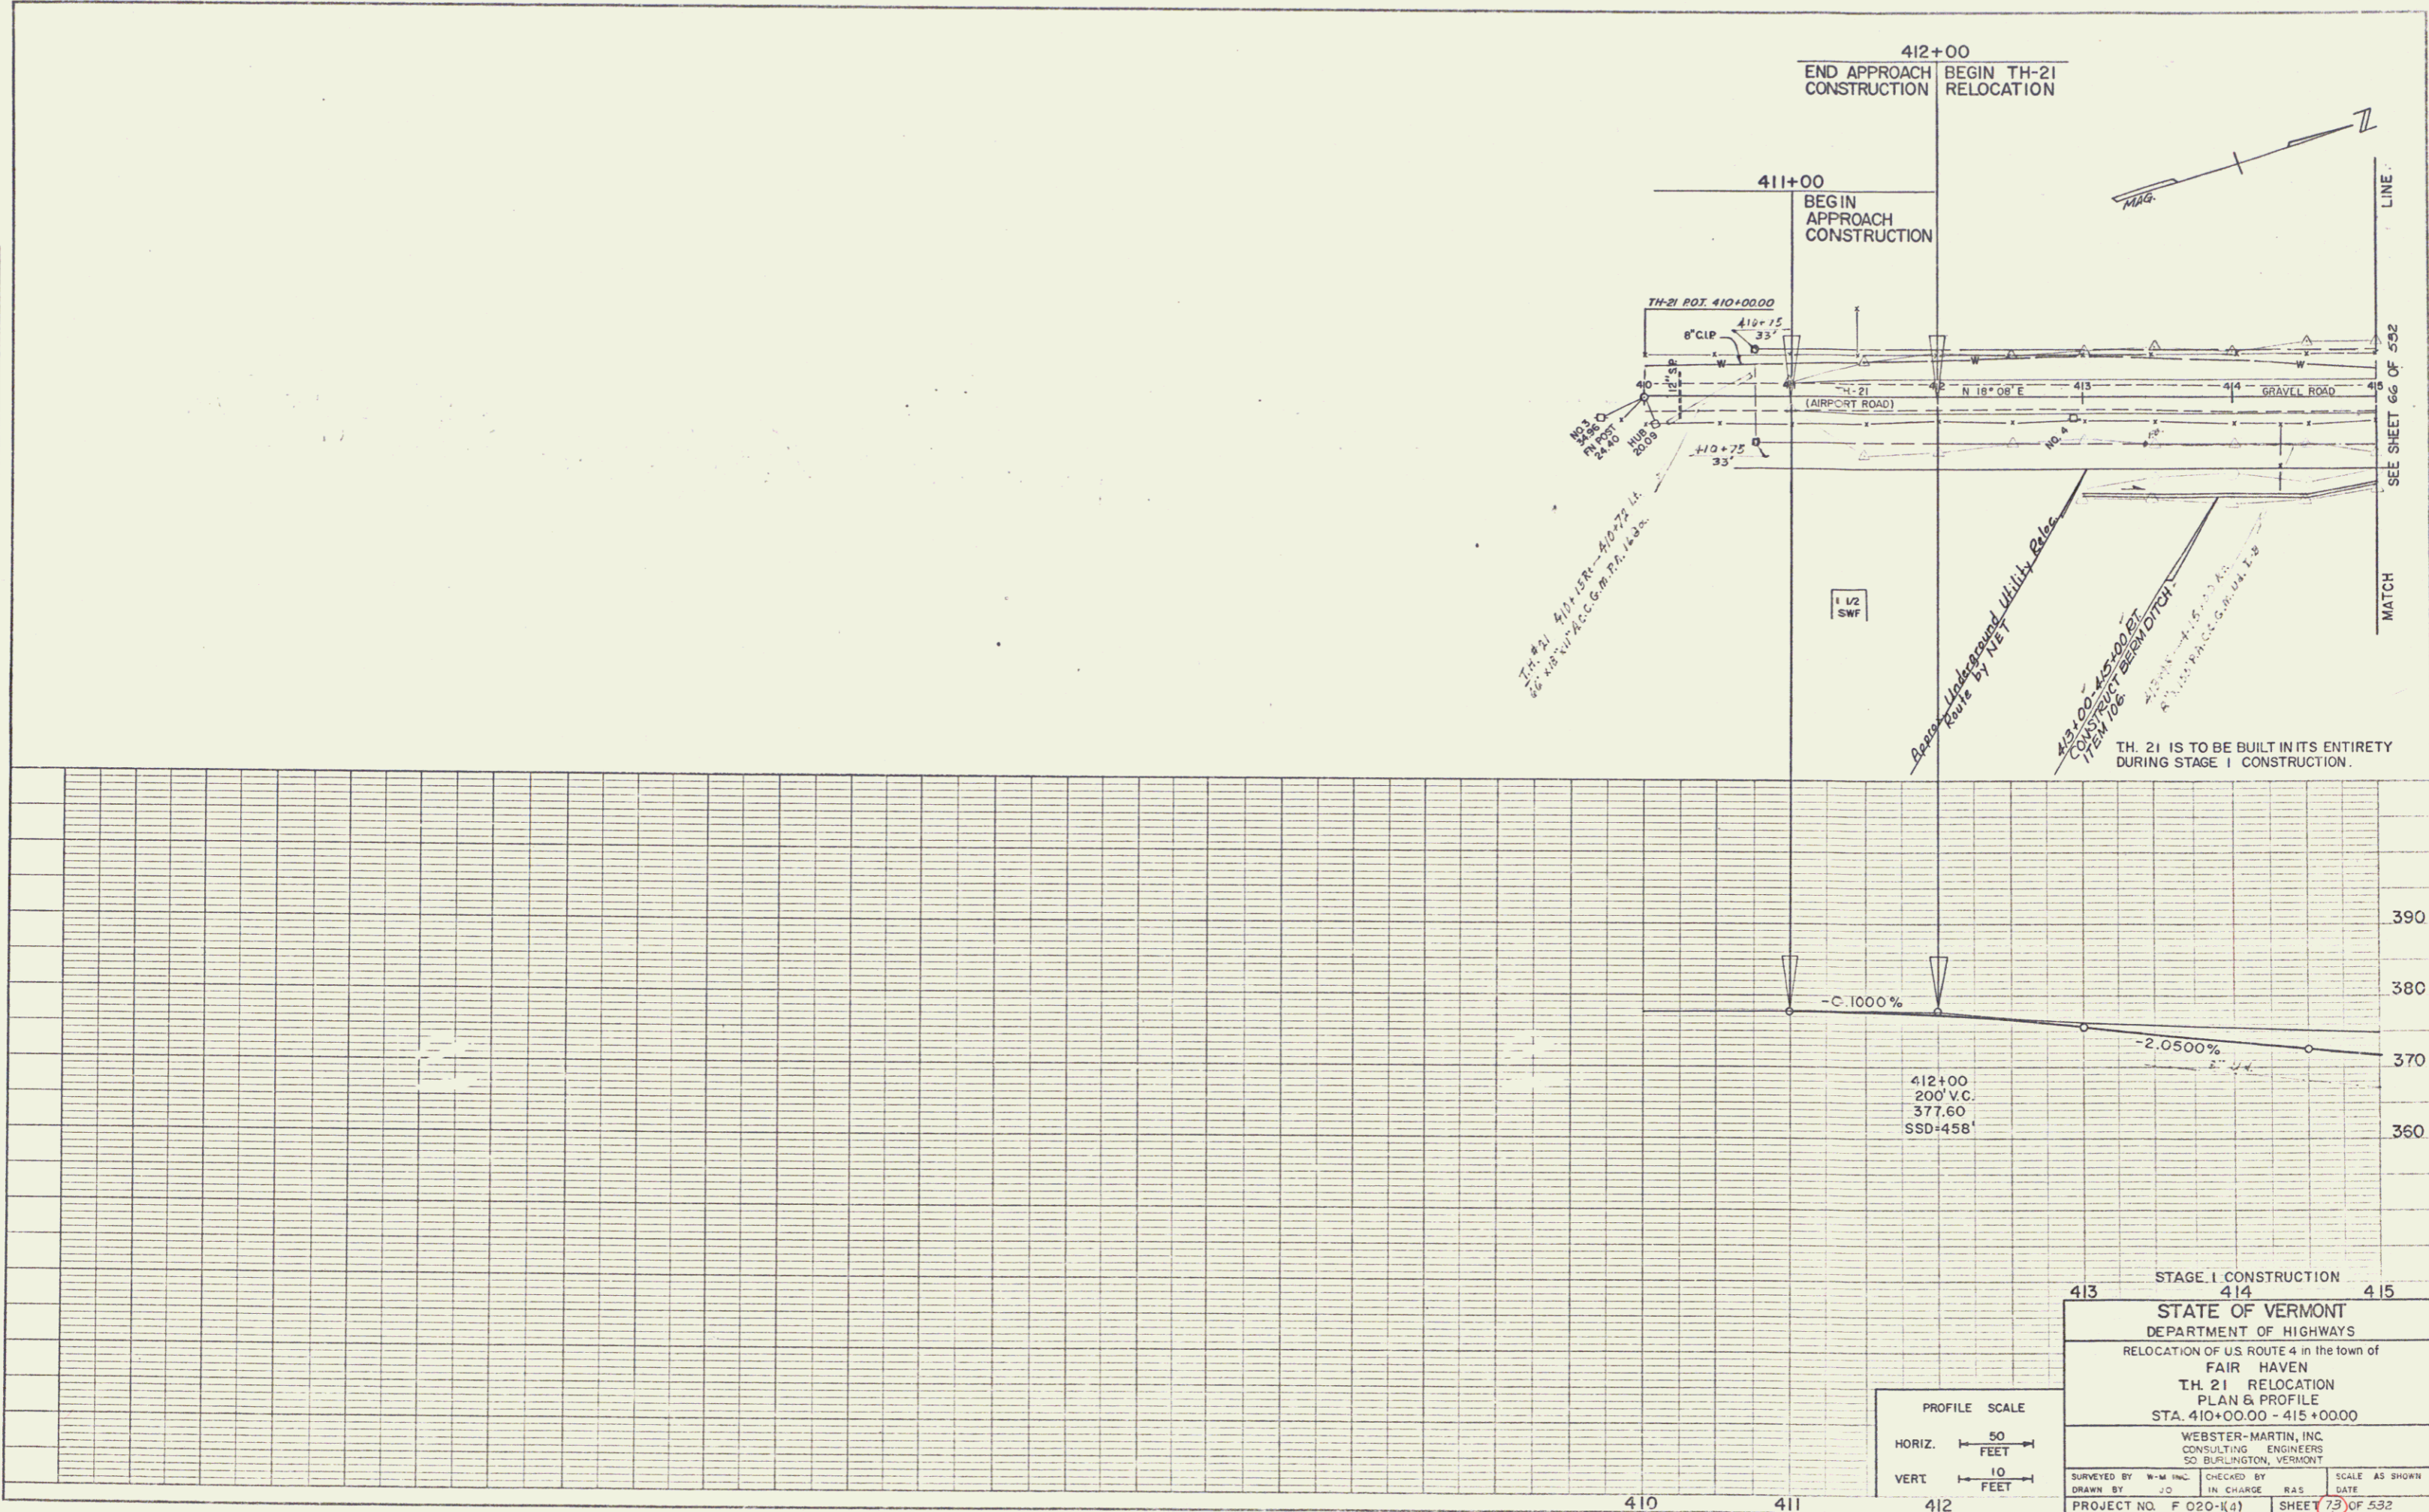

STAGE I CONSTRUCTION
413 414 415

STATE OF VERMONT
DEPARTMENT OF HIGHWAYS
RELOCATION OF US ROUTE 4 in the town of
FAIR HAVEN
TH. 21 RELOCATION
PLAN & PROFILE
STA. 410+00.00 - 415+00.00

WEBSTER-MARTIN, INC.
CONSULTING ENGINEERS
50 BURLINGTON, VERMONT

SURVEYED BY	W-M INC.	CHECKED BY	SCALE AS SHOWN		
DRAWN BY	J.O.	IN CHARGE	R.A.S.	DATE	
PROJECT NO.	F 020-1(4)	SHEET	73	OF	532