

STONE FILL FOR SLOPE PROTECTION (LIGHT TYPE) ITEM 512

STATION	POS	STATION	POS
520+00	00	520+25	00
520+25	00	520+50	00

CHAIN LINK FENCE 6' HIGH

STATION	POS	STATION	POS
520+00	00	520+25	00
520+25	00	520+50	00

TREATED TIMBER CURB ITEM 568

STATION	POS	STATION	POS
520+00	00	520+25	00
520+25	00	520+50	00

THREE CABLE GUARD RAIL WITH STEEL POSTS ITEM 542

STATION	POS	STATION	POS
520+00	00	520+25	00
520+25	00	520+50	00

CONSTRUCT DRIVE

STATION	POS	STATION	POS
524+00	00	524+25	00
524+25	00	524+50	00


\* JUTE MATTING ITEM 623

STATION	POS	STATION	POS
520+00	00	520+25	00
520+25	00	520+50	00

DEMOLITION AND DISPOSAL OF BUILDING ITEM 586

STATION	POS	STATION	POS
520+00	00	520+25	00
520+25	00	520+50	00

Excavation & Removal of Road Surfaces and Pavements  
524+33 - 526+00

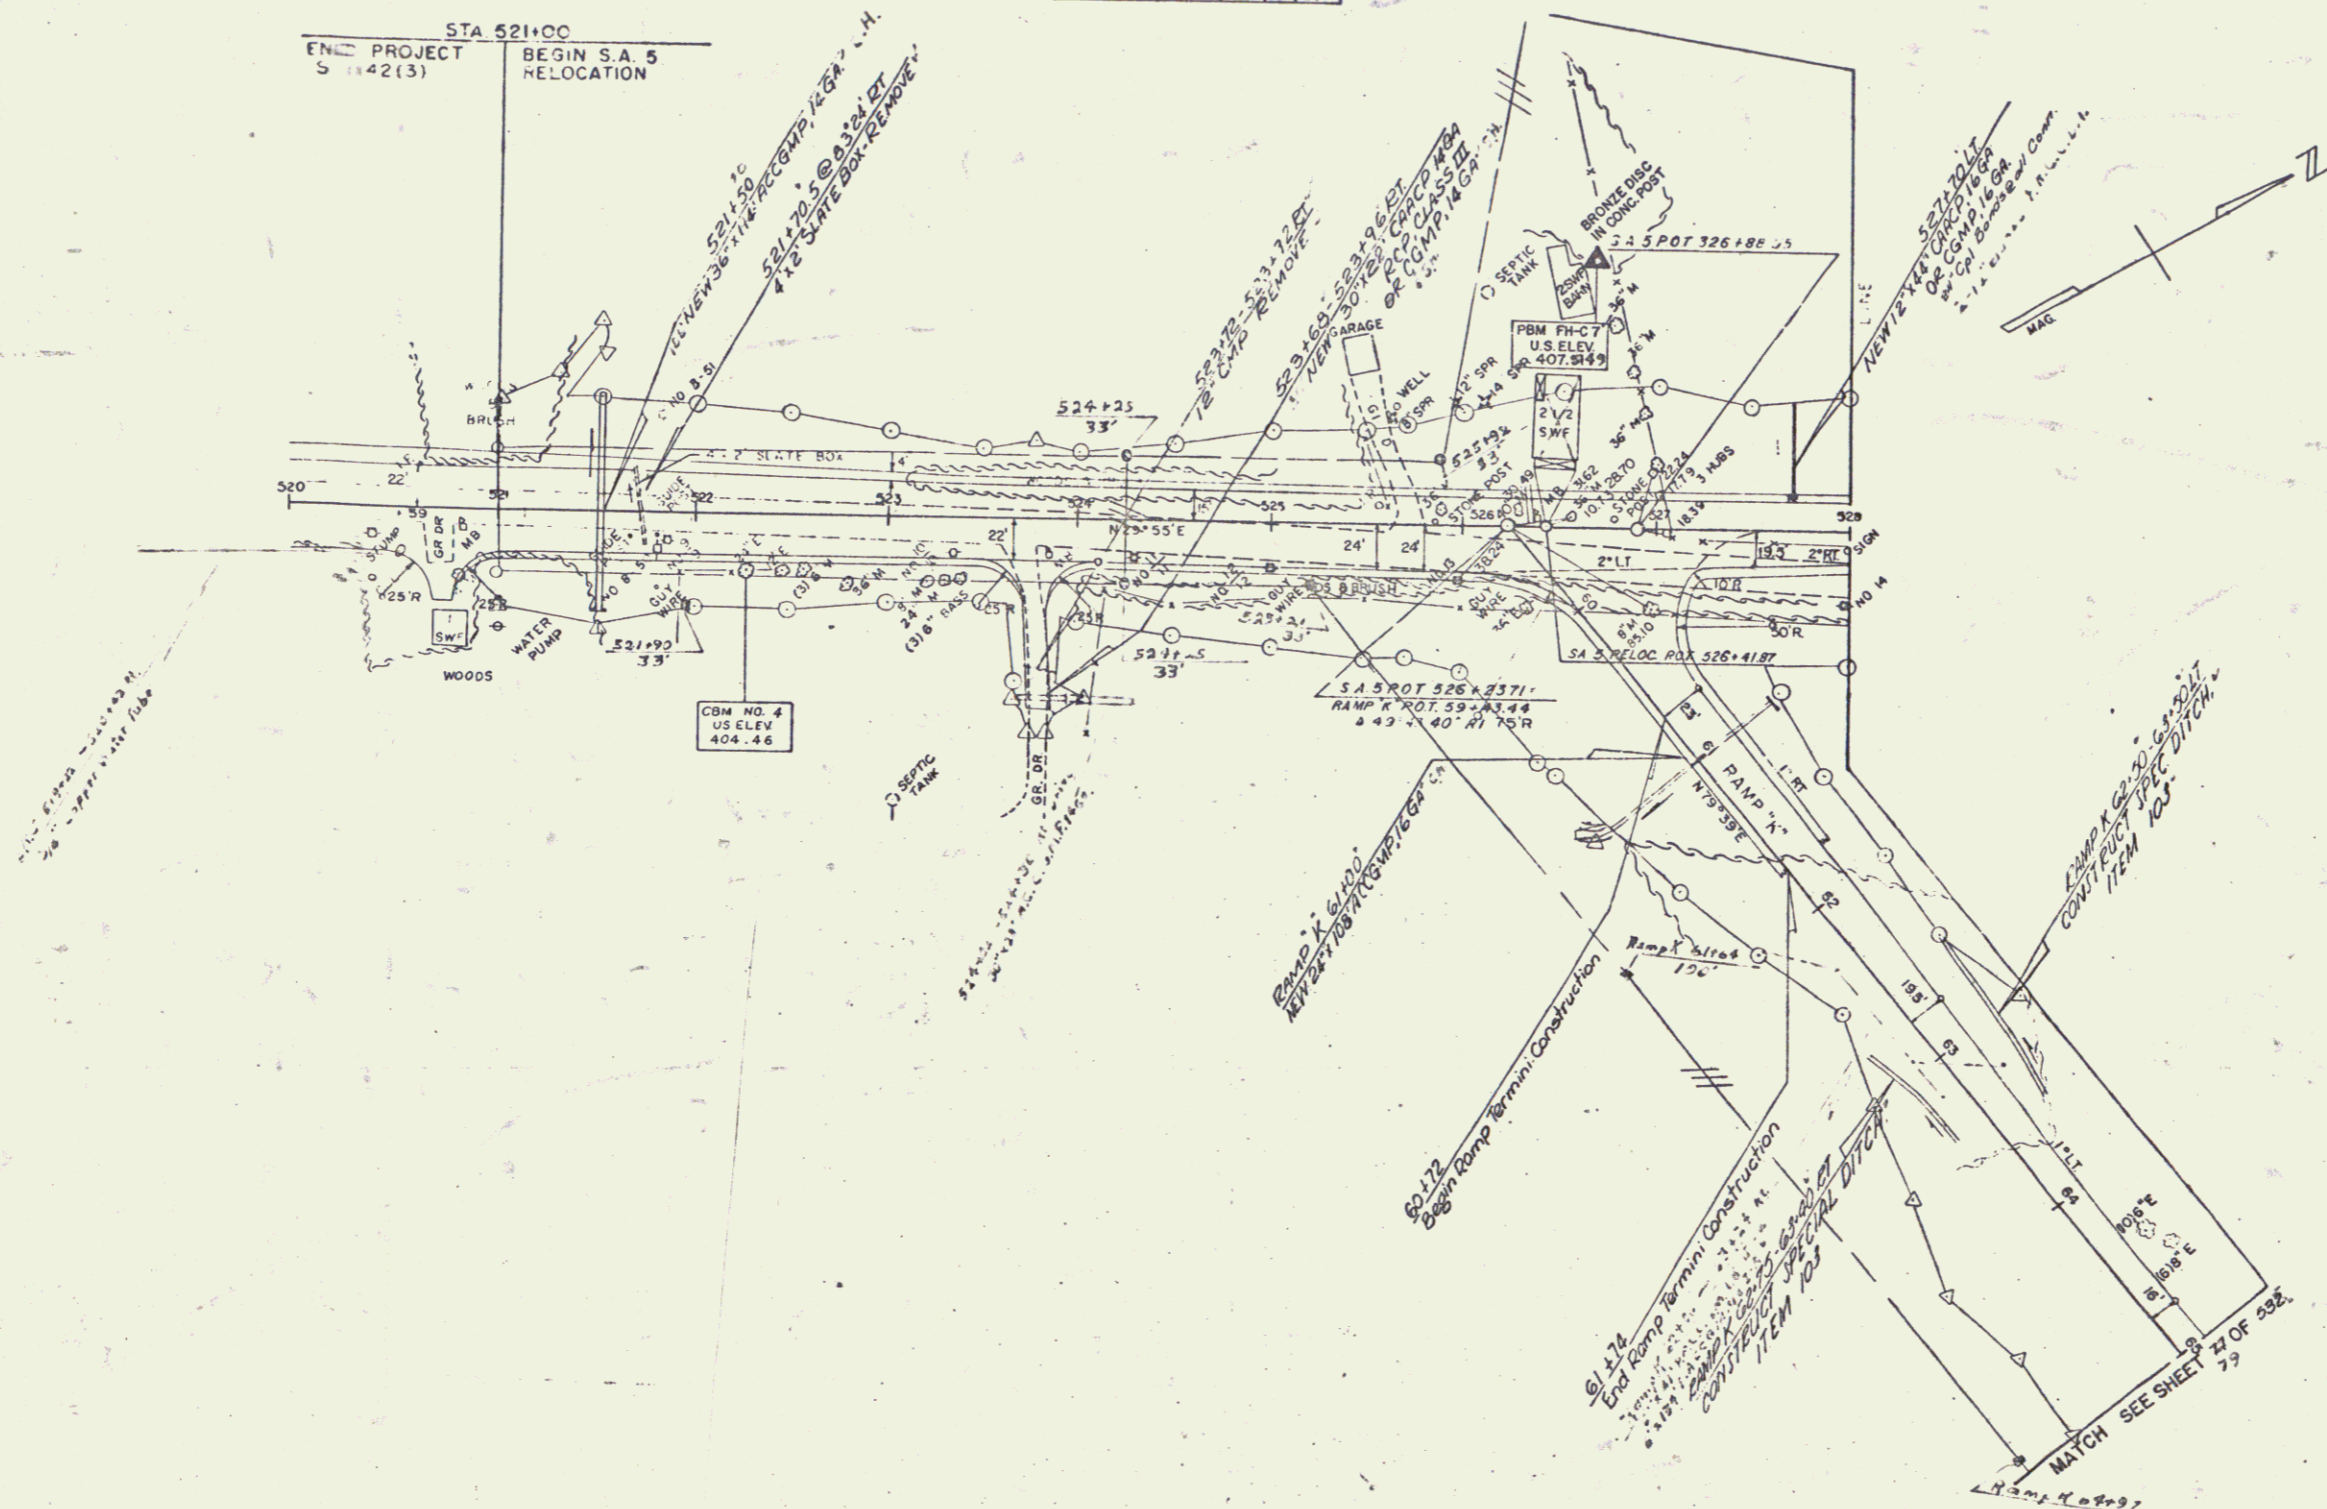

SA-5 IS TO BE BUILT IN ITS ENTIRETY DURING STAGE I CONSTRUCTION.

STAGE 2 CONSTRUCTION	
STATE OF VERMONT DEPARTMENT OF HIGHWAYS	
RELOCATION OF FAIR HAVEN ROUTE 4 WITH THE FAIR HAVEN PLAN STA. 520+00.00-528+00.00	
WEBSTER-MARTIN, INC. CONSULTING ENGINEERS 50 BURLINGTON, VERMONT	
DESIGNED BY: W.M.C.	CHECKED BY: RAB
DRAWN BY: J.D.	IN CHARGE: RAB
PROJECT NO.: F-020-R(4)07	SHEET 22 OF 50

