


PROPERTY LINE FENCE WITH STEEL POSTS ITEM 583-II MOD.		
STATION	STATION	POS
1174+00	1175+00	00
1175+00	1176+00	00
1176+00	1177+00	00

JUTE MATTING ITEM 623		
STATION	STATION	POS
1174+00	1175+00	00
1175+00	1176+00	00
1176+00	1177+00	00

STONE FILL FOR SLOPE PROTECTION (LIGHT TYPE) ITEM 512		
STATION	STATION	POS
1174+00	1175+00	00
1175+00	1176+00	00
1176+00	1177+00	00

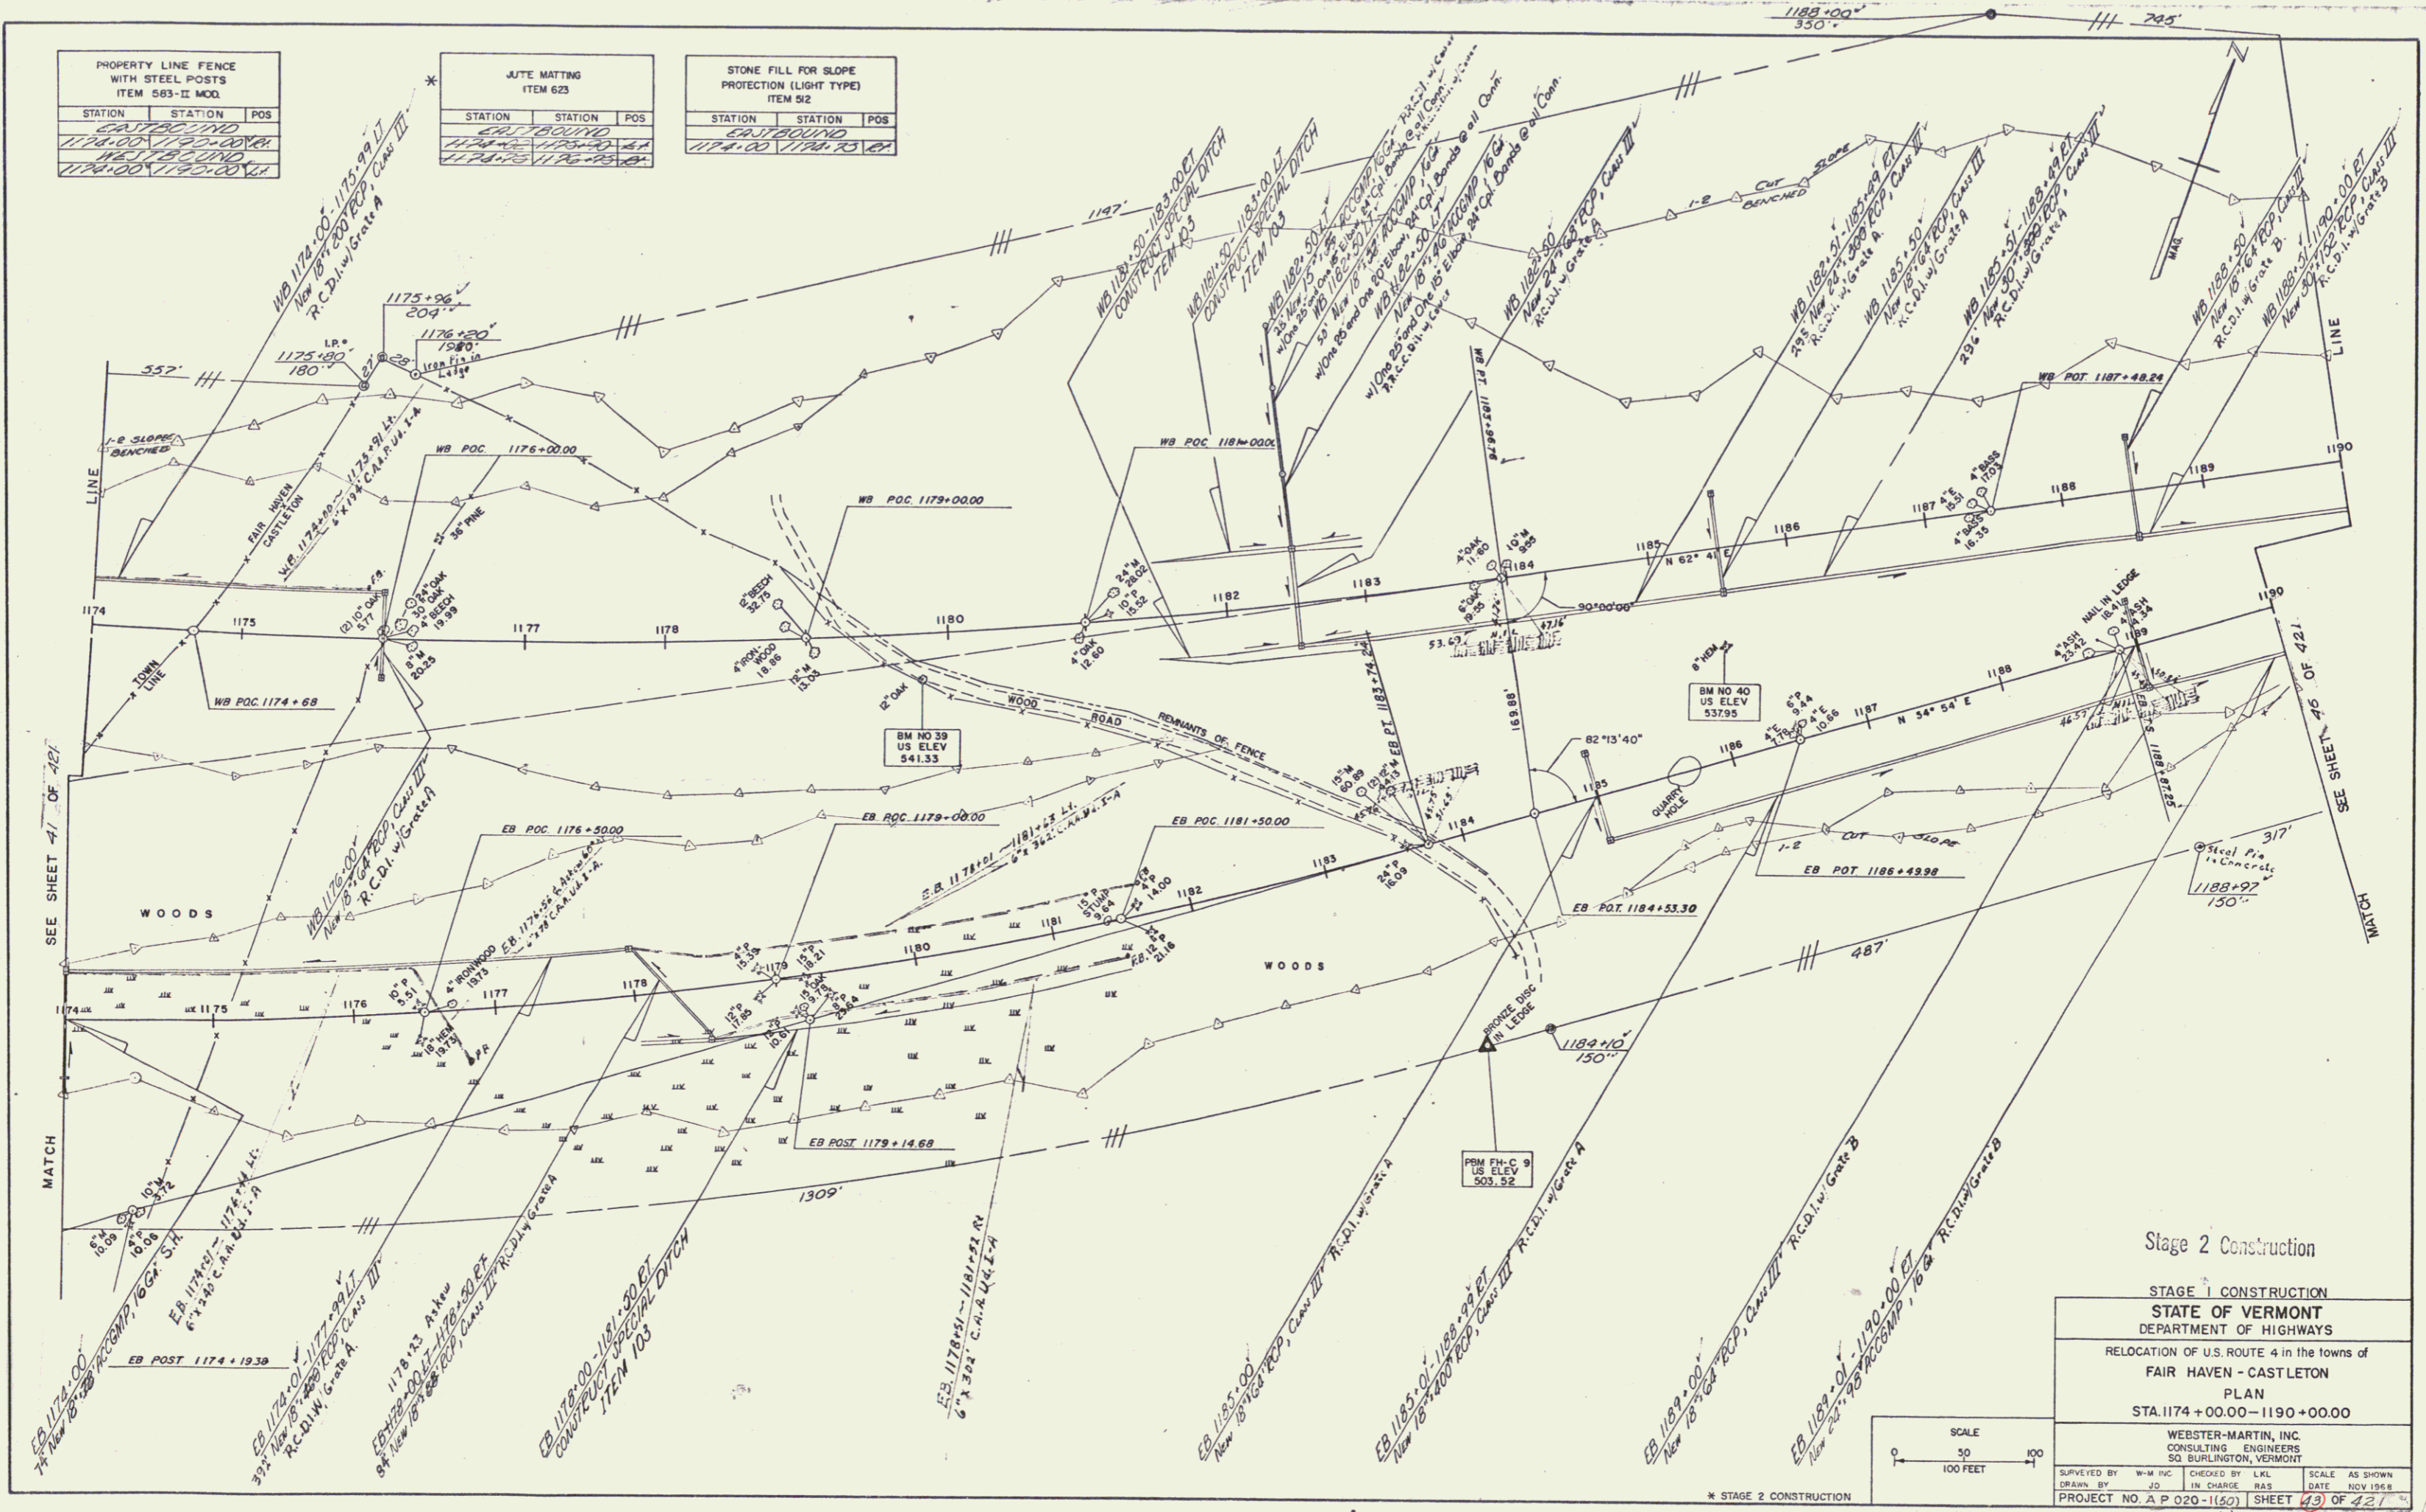


SEE SHEET 41 OF 421

MATCH

SEE SHEET 45 OF 421

Stage 2 Construction

STAGE 1 CONSTRUCTION	
STATE OF VERMONT DEPARTMENT OF HIGHWAYS	
RELOCATION OF U.S. ROUTE 4 in the towns of FAIR HAVEN - CASTLETON	
PLAN STA. 1174+00.00 - 1190+00.00	
WEBSTER-MARTIN, INC. CONSULTING ENGINEERS 50 BURLINGTON, VERMONT	
SURVEYED BY: W-M INC.	CHECKED BY: LKL
DRAWN BY: JQ	IN CHARGE: RAS
PROJECT NO. A P 020-1160	SHEET 49 OF 421
SCALE AS SHOWN DATE: NOV 1958	

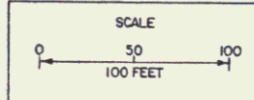

Sheet 88 of 255 Sheets