
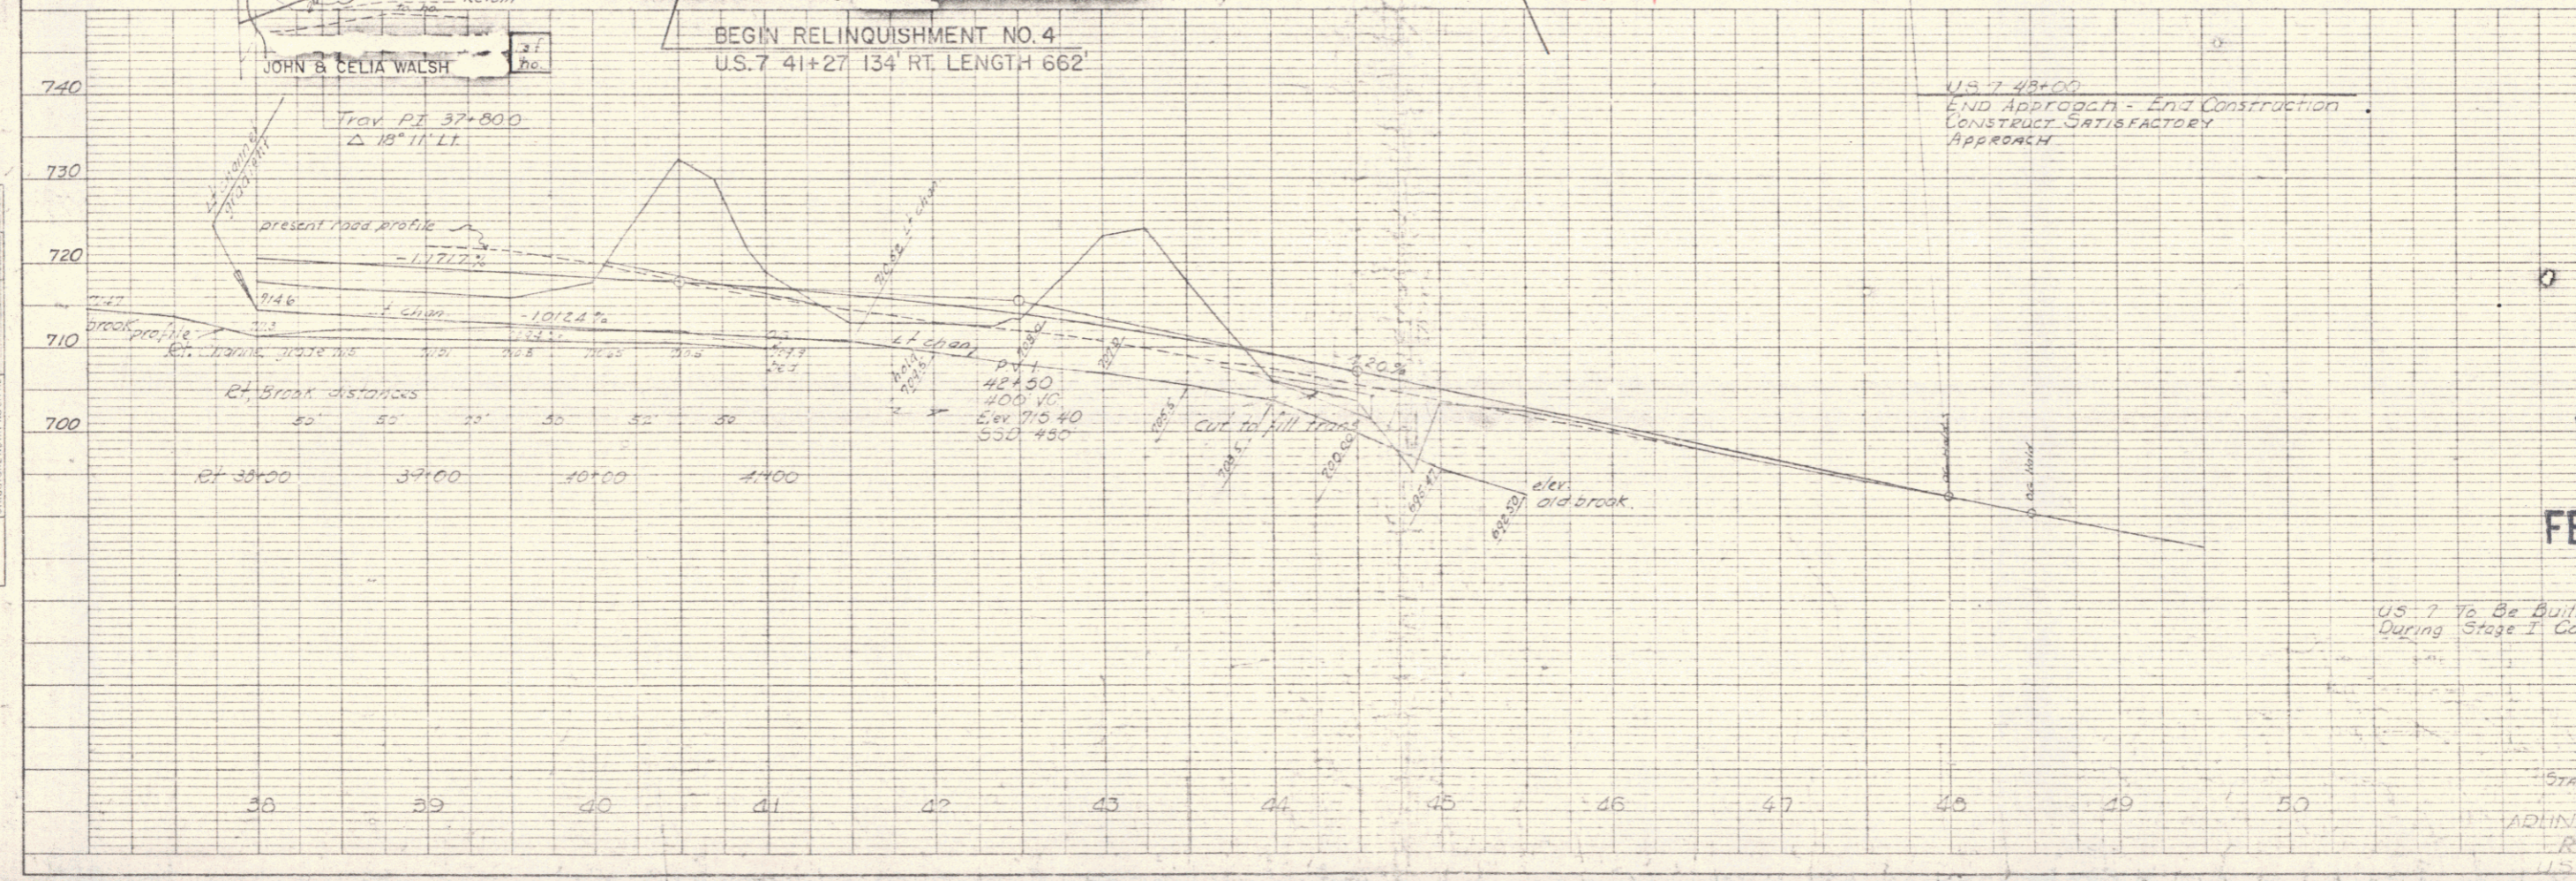


POOR ORIGINAL COPY

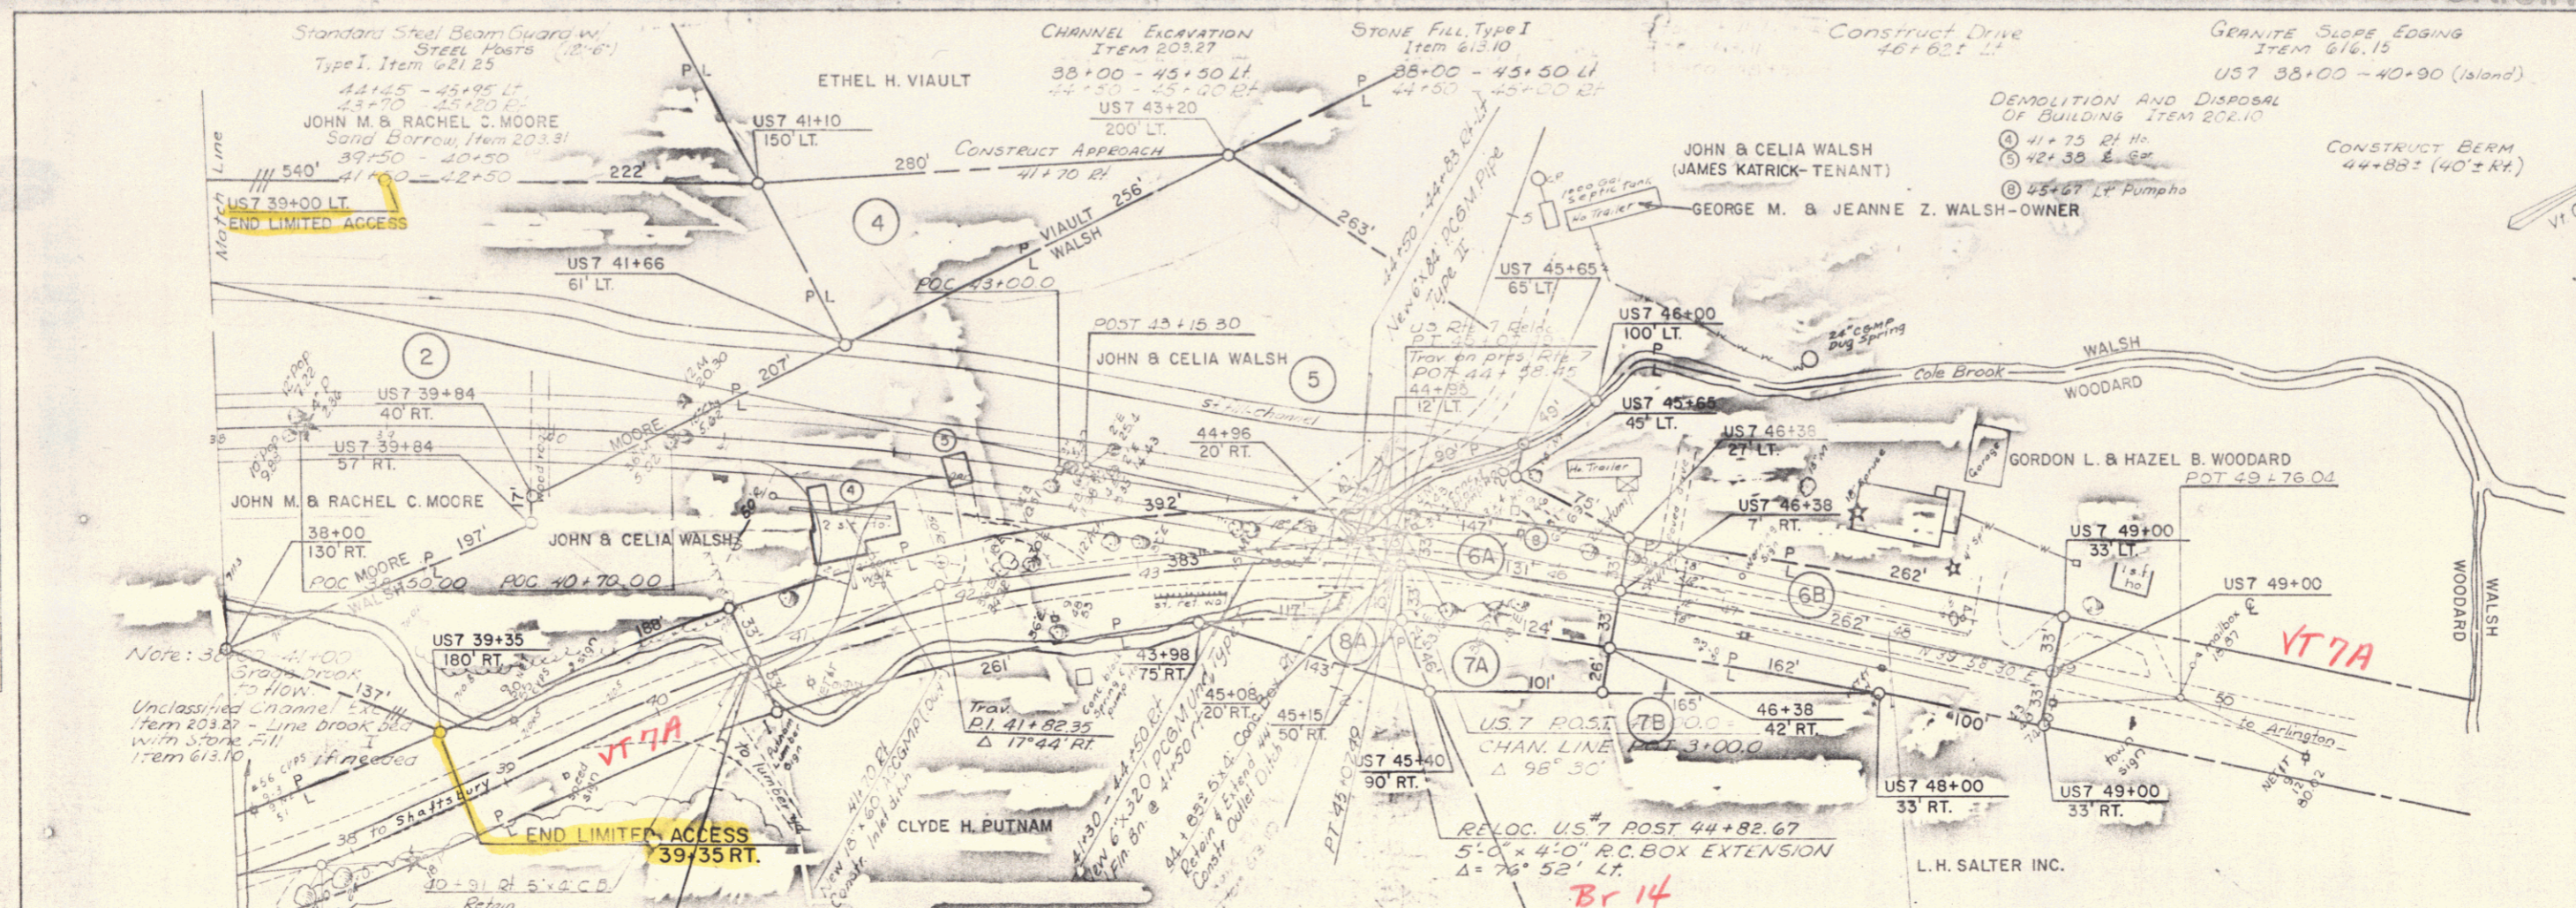

PLAN

DATE	
BY	
CHECKED	
APPROVED	
NOTE BOOK	
NO.	

PROFILE

DATE	
BY	
CHECKED	
APPROVED	
NOTE BOOK	
NO.	

FEB 25 1980

FEB 25 1980