


POOR ORIGINAL COPY

DATE: 1/27/87  
 BY: JEP  
 CHECKED: PH  
 PLAN  
 SURVEYED: JEP  
 NOTE BOOK: JEP  
 ADJUSTMENT CHECKED: PH  
 RECALCULATED: PH

DATE: 2-27-87  
 BY: JEP  
 CHECKED: PH  
 PROFILE  
 SURVEYED: JEP  
 NOTE BOOK: JEP  
 ADJUSTMENT CHECKED: PH  
 RECALCULATED: PH

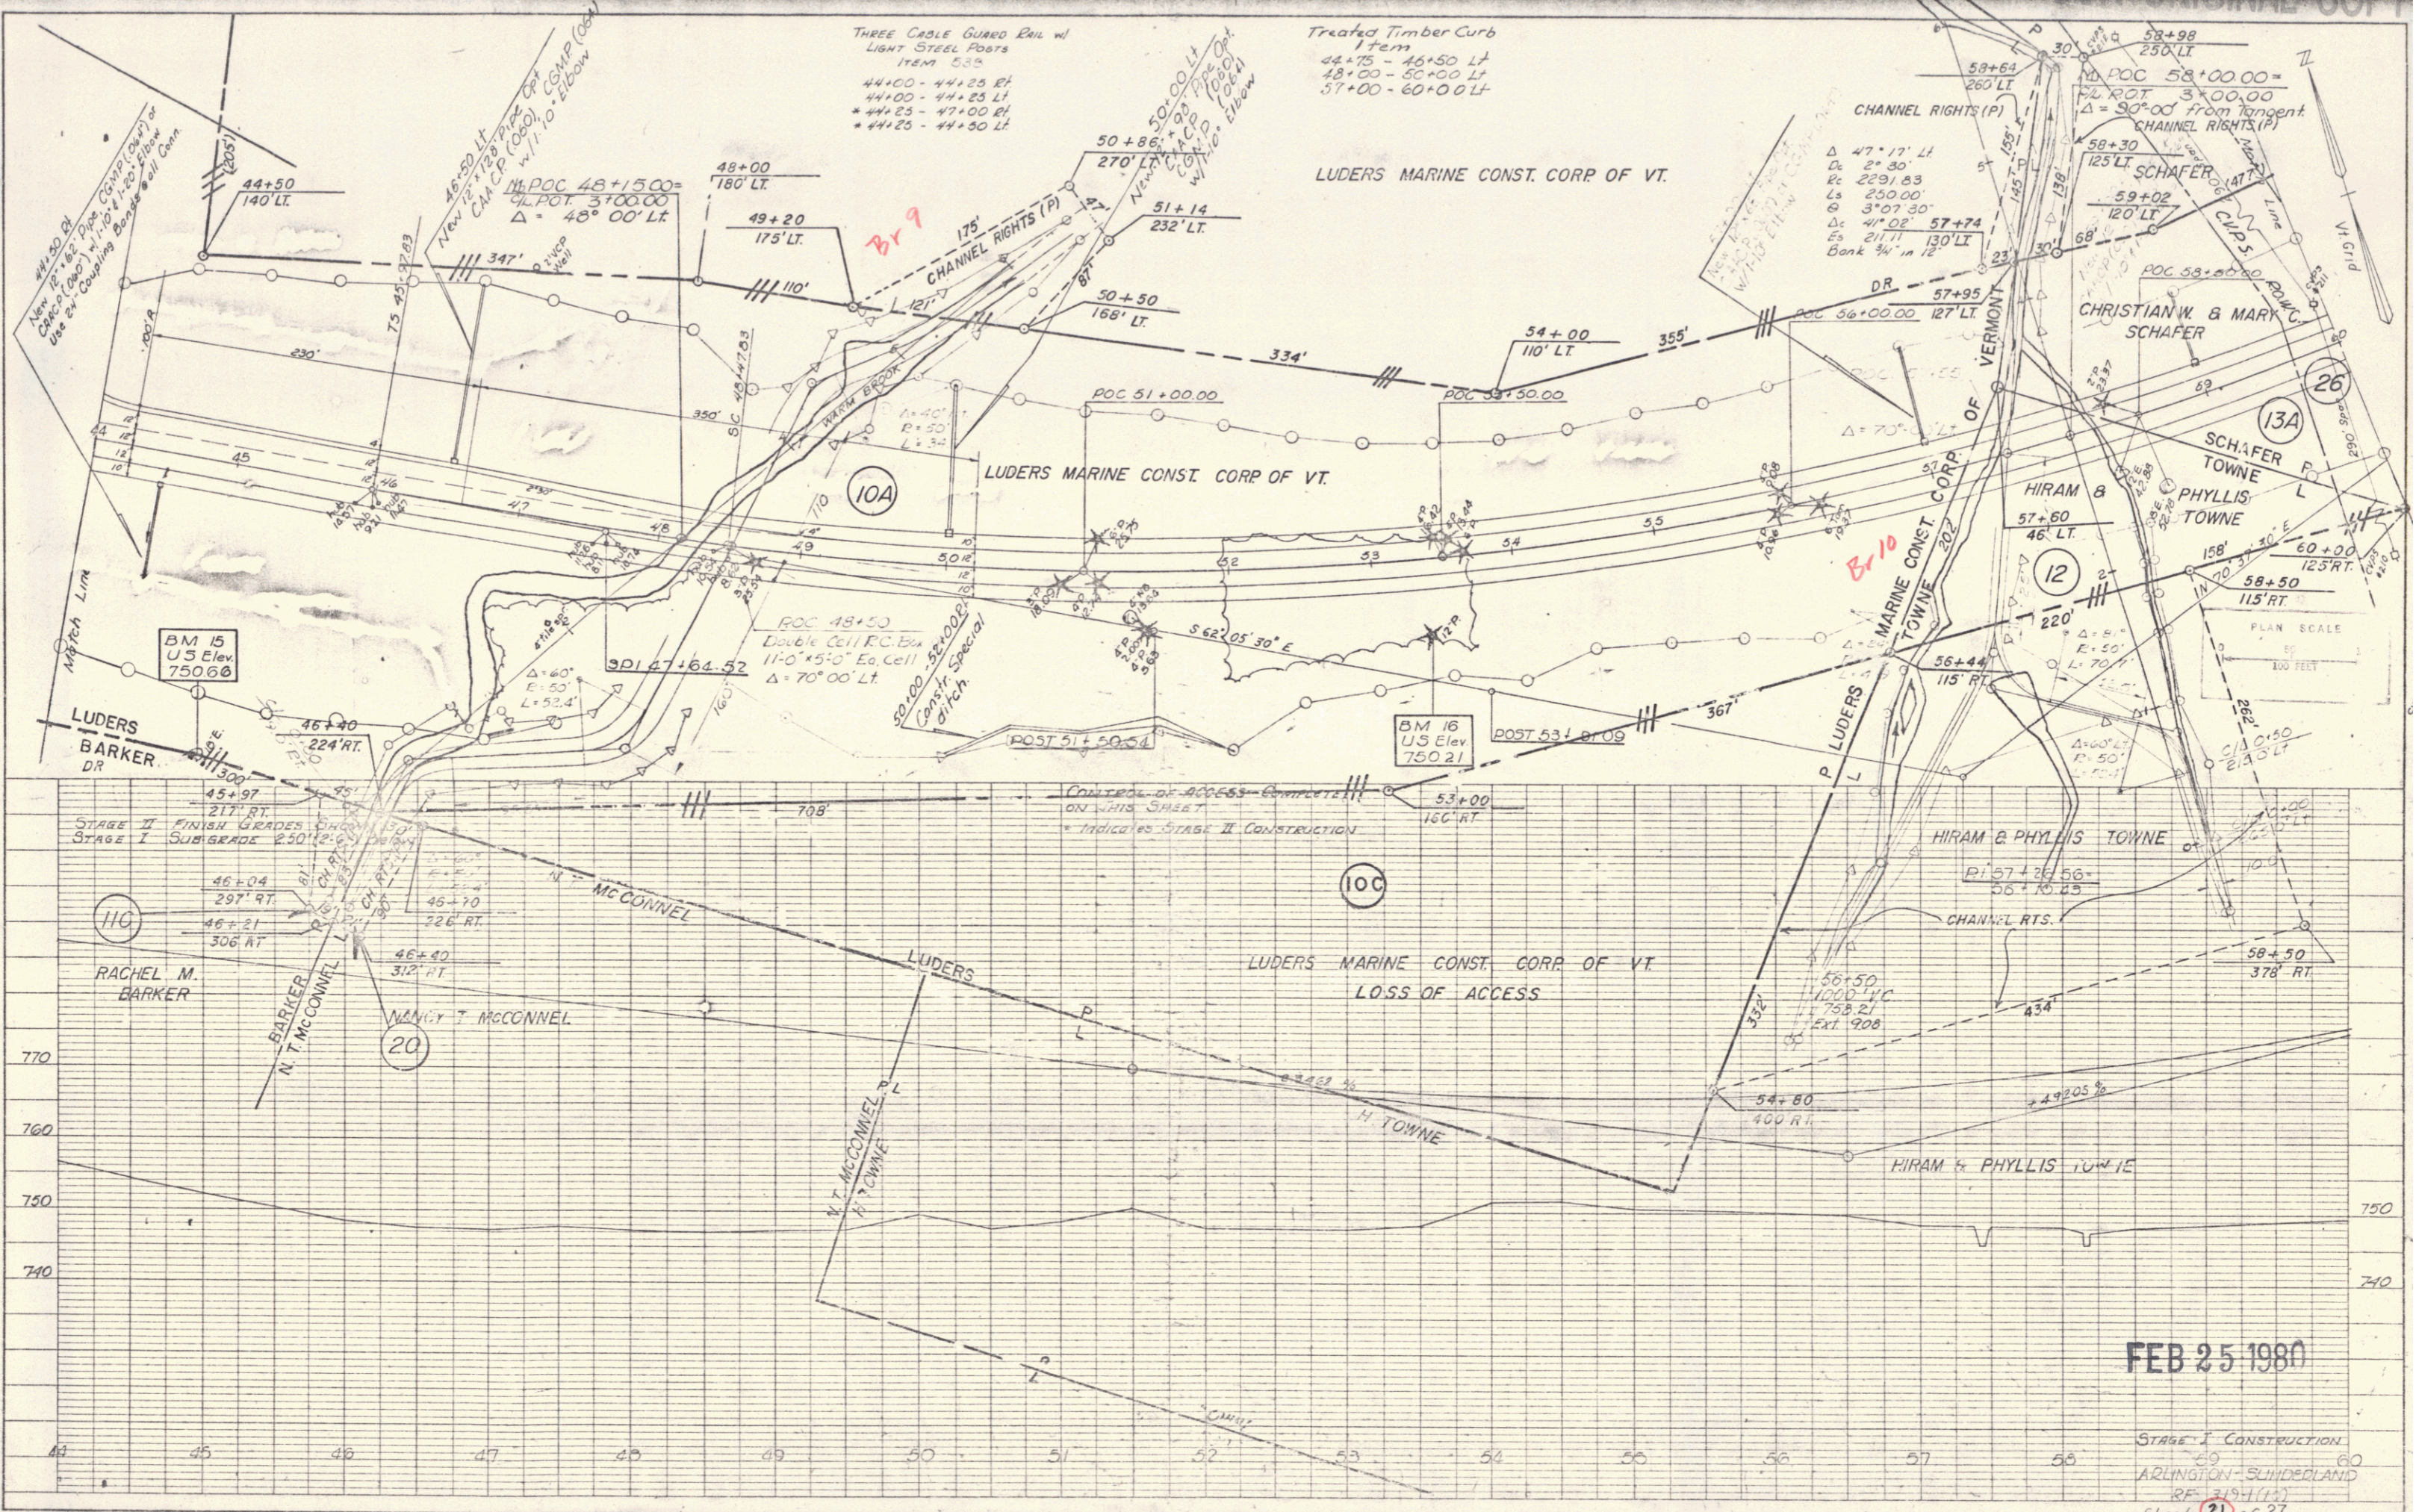

FEB 25 1987

STAGE I CONSTRUCTION  
 ARLINGTON-SUNDERLAND  
 RE: 19-1(11)  
 Sheet 21 of 27

PLATE 1, PLAN/PROFILE