
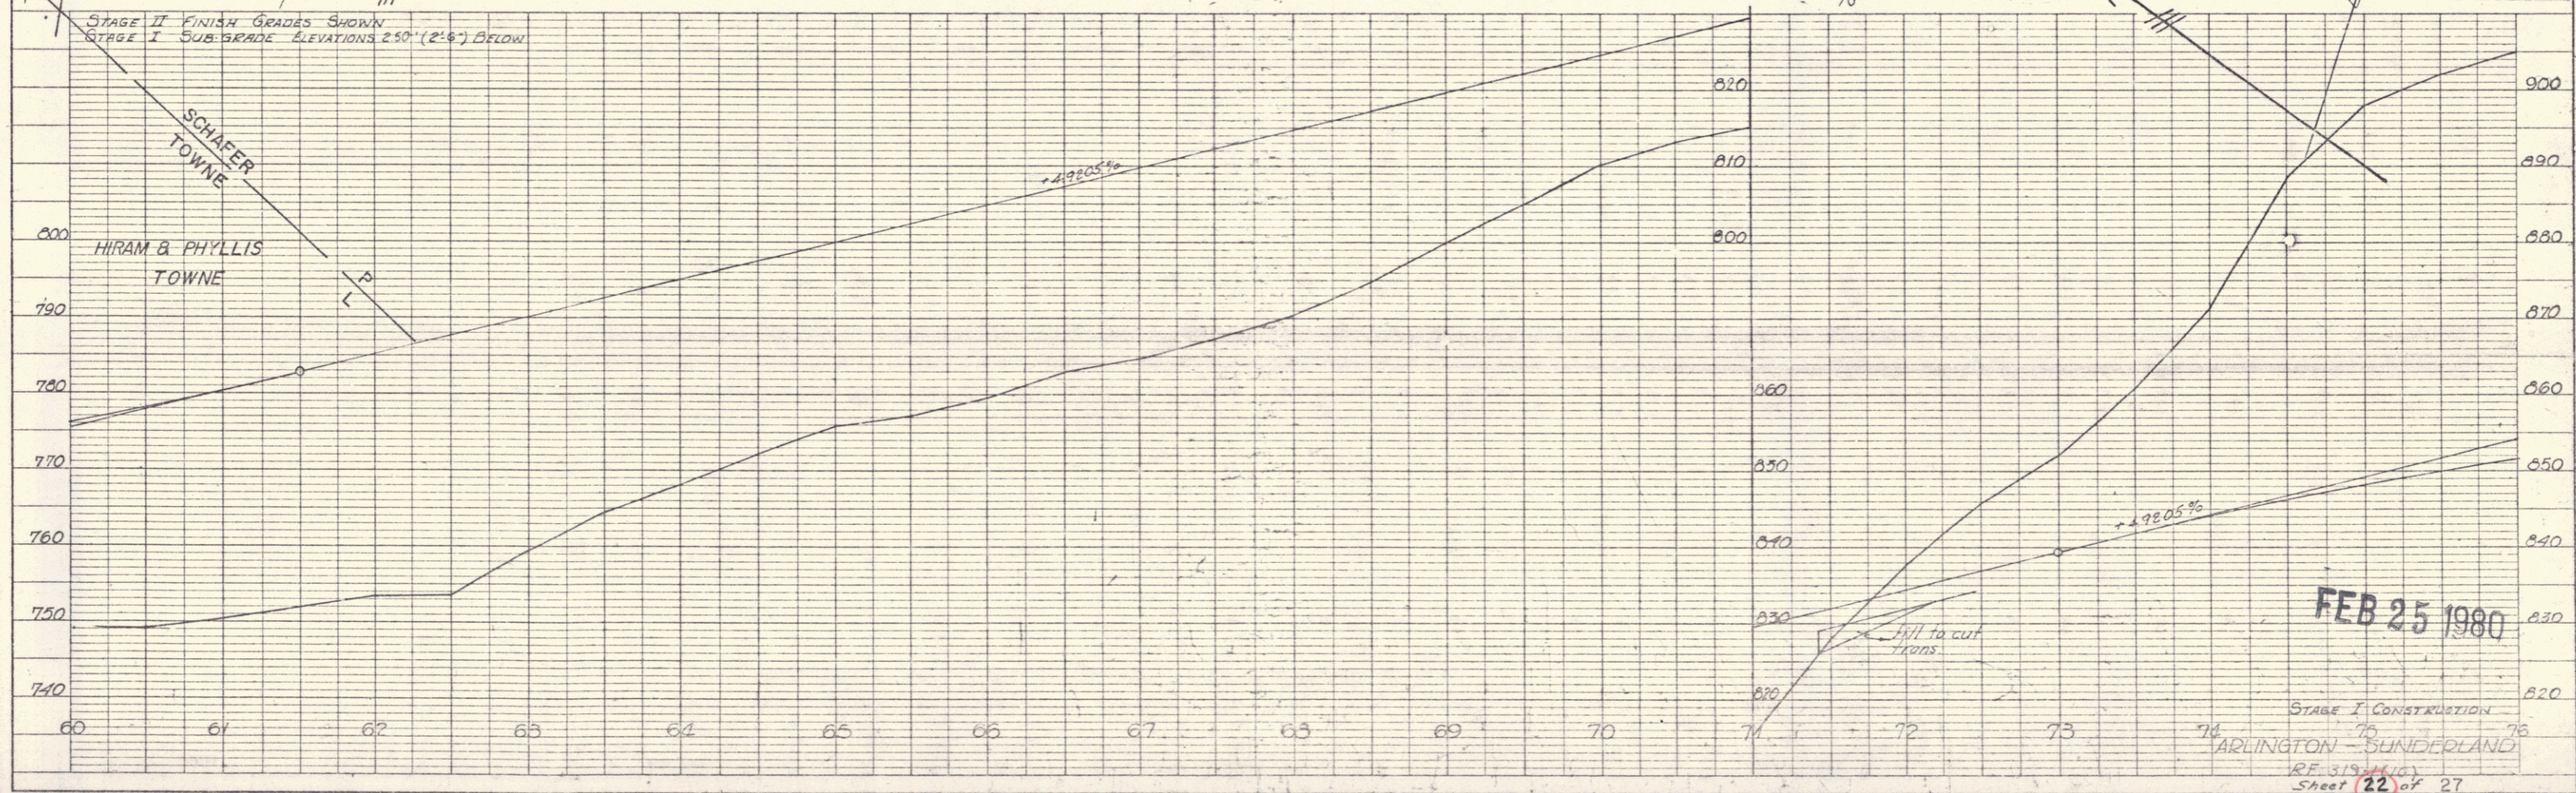


POOR ORIGINAL COPY

PLAN	DATE	BY
DESIGNED	4/85	JEF
PLOTTED		JEF
CHECKED		PW
DATE		
NO.		

PROFILE	DATE	BY
DESIGNED	2/85	JEF
PLOTTED		JEF
CHECKED		PW
DATE		
NO.		

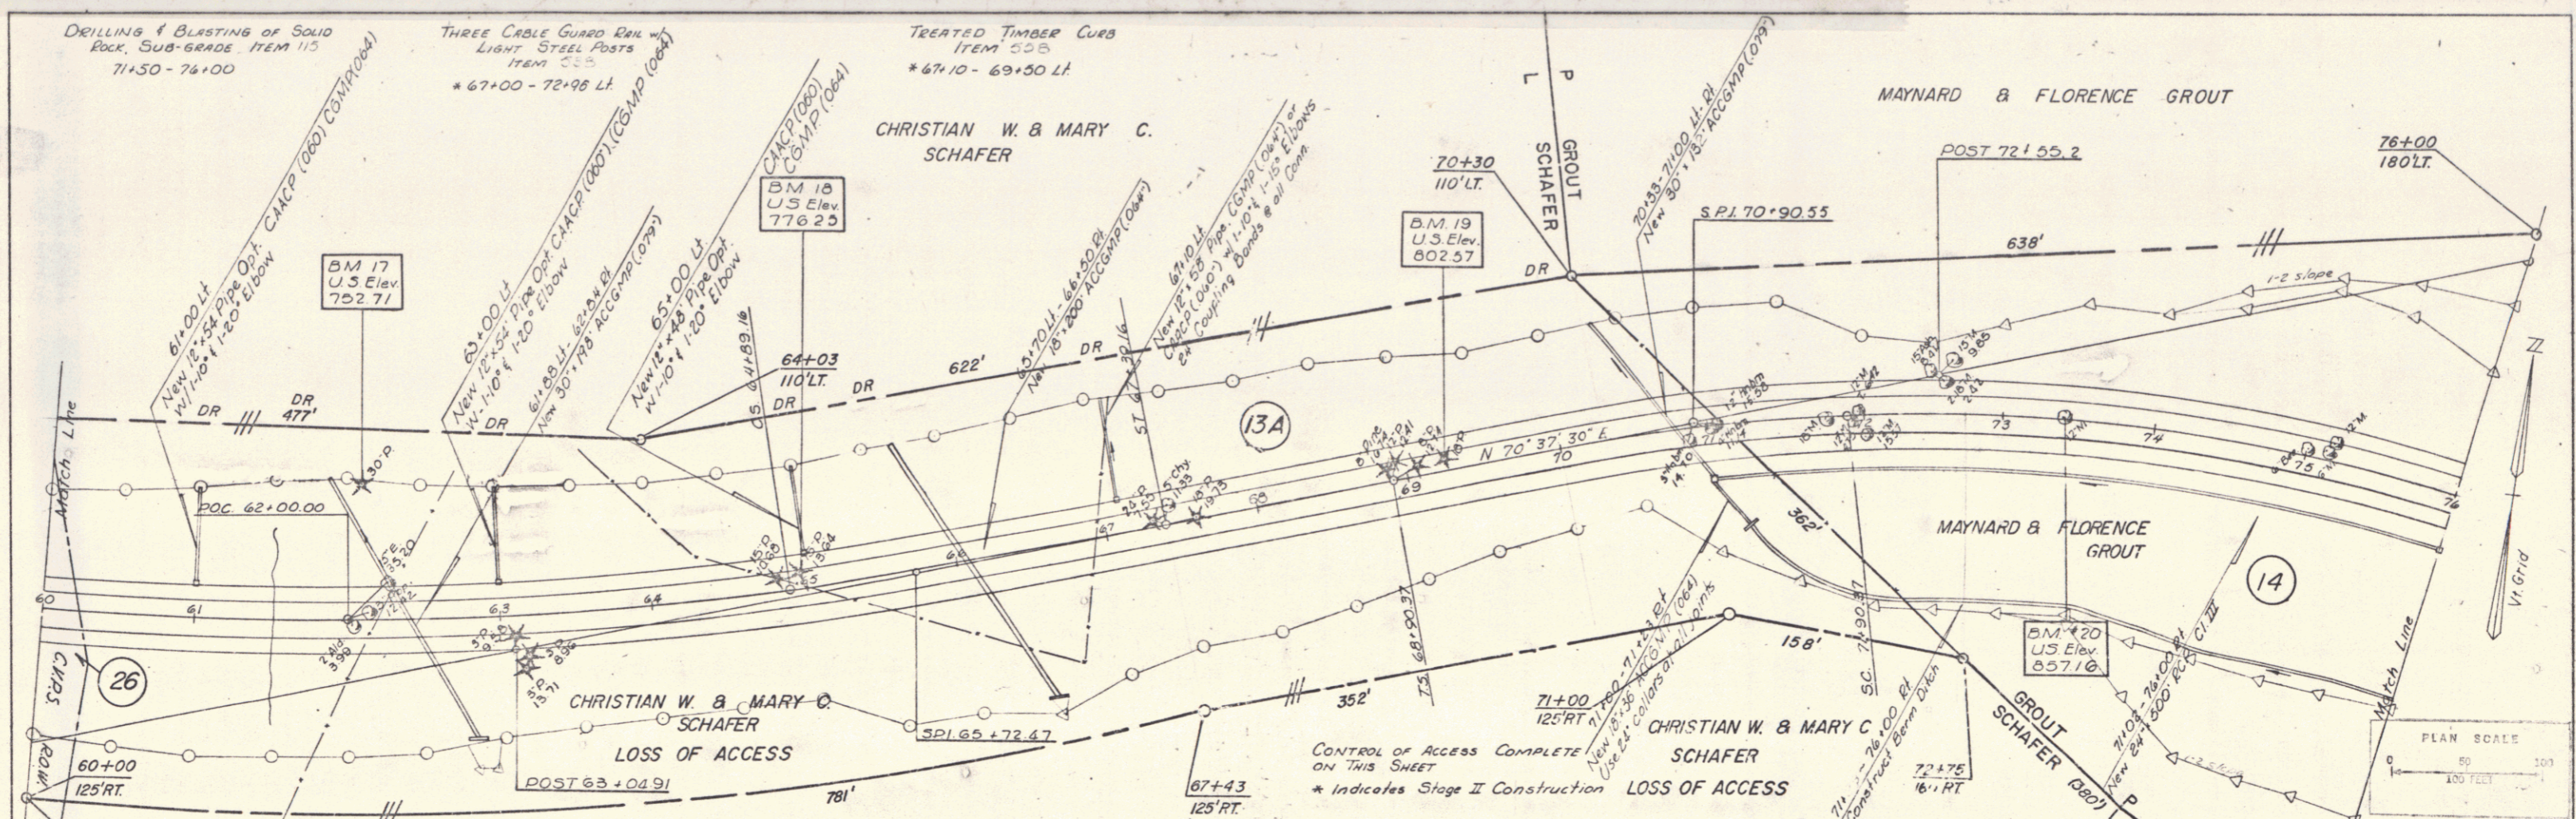

FEB 25 1980

STAGE I CONSTRUCTION TO ARLINGTON SUNDERLAND RE 319 (10) Sheet 22 of 27