


DRILLING & BLASTING OF
SOLID ROCK-SUBGRADE
ITEM
N.B. 739+00-740+00

DRILLING & BLASTING OF
SOLID ROCK, ITEM
N.B. 739+00-740+00

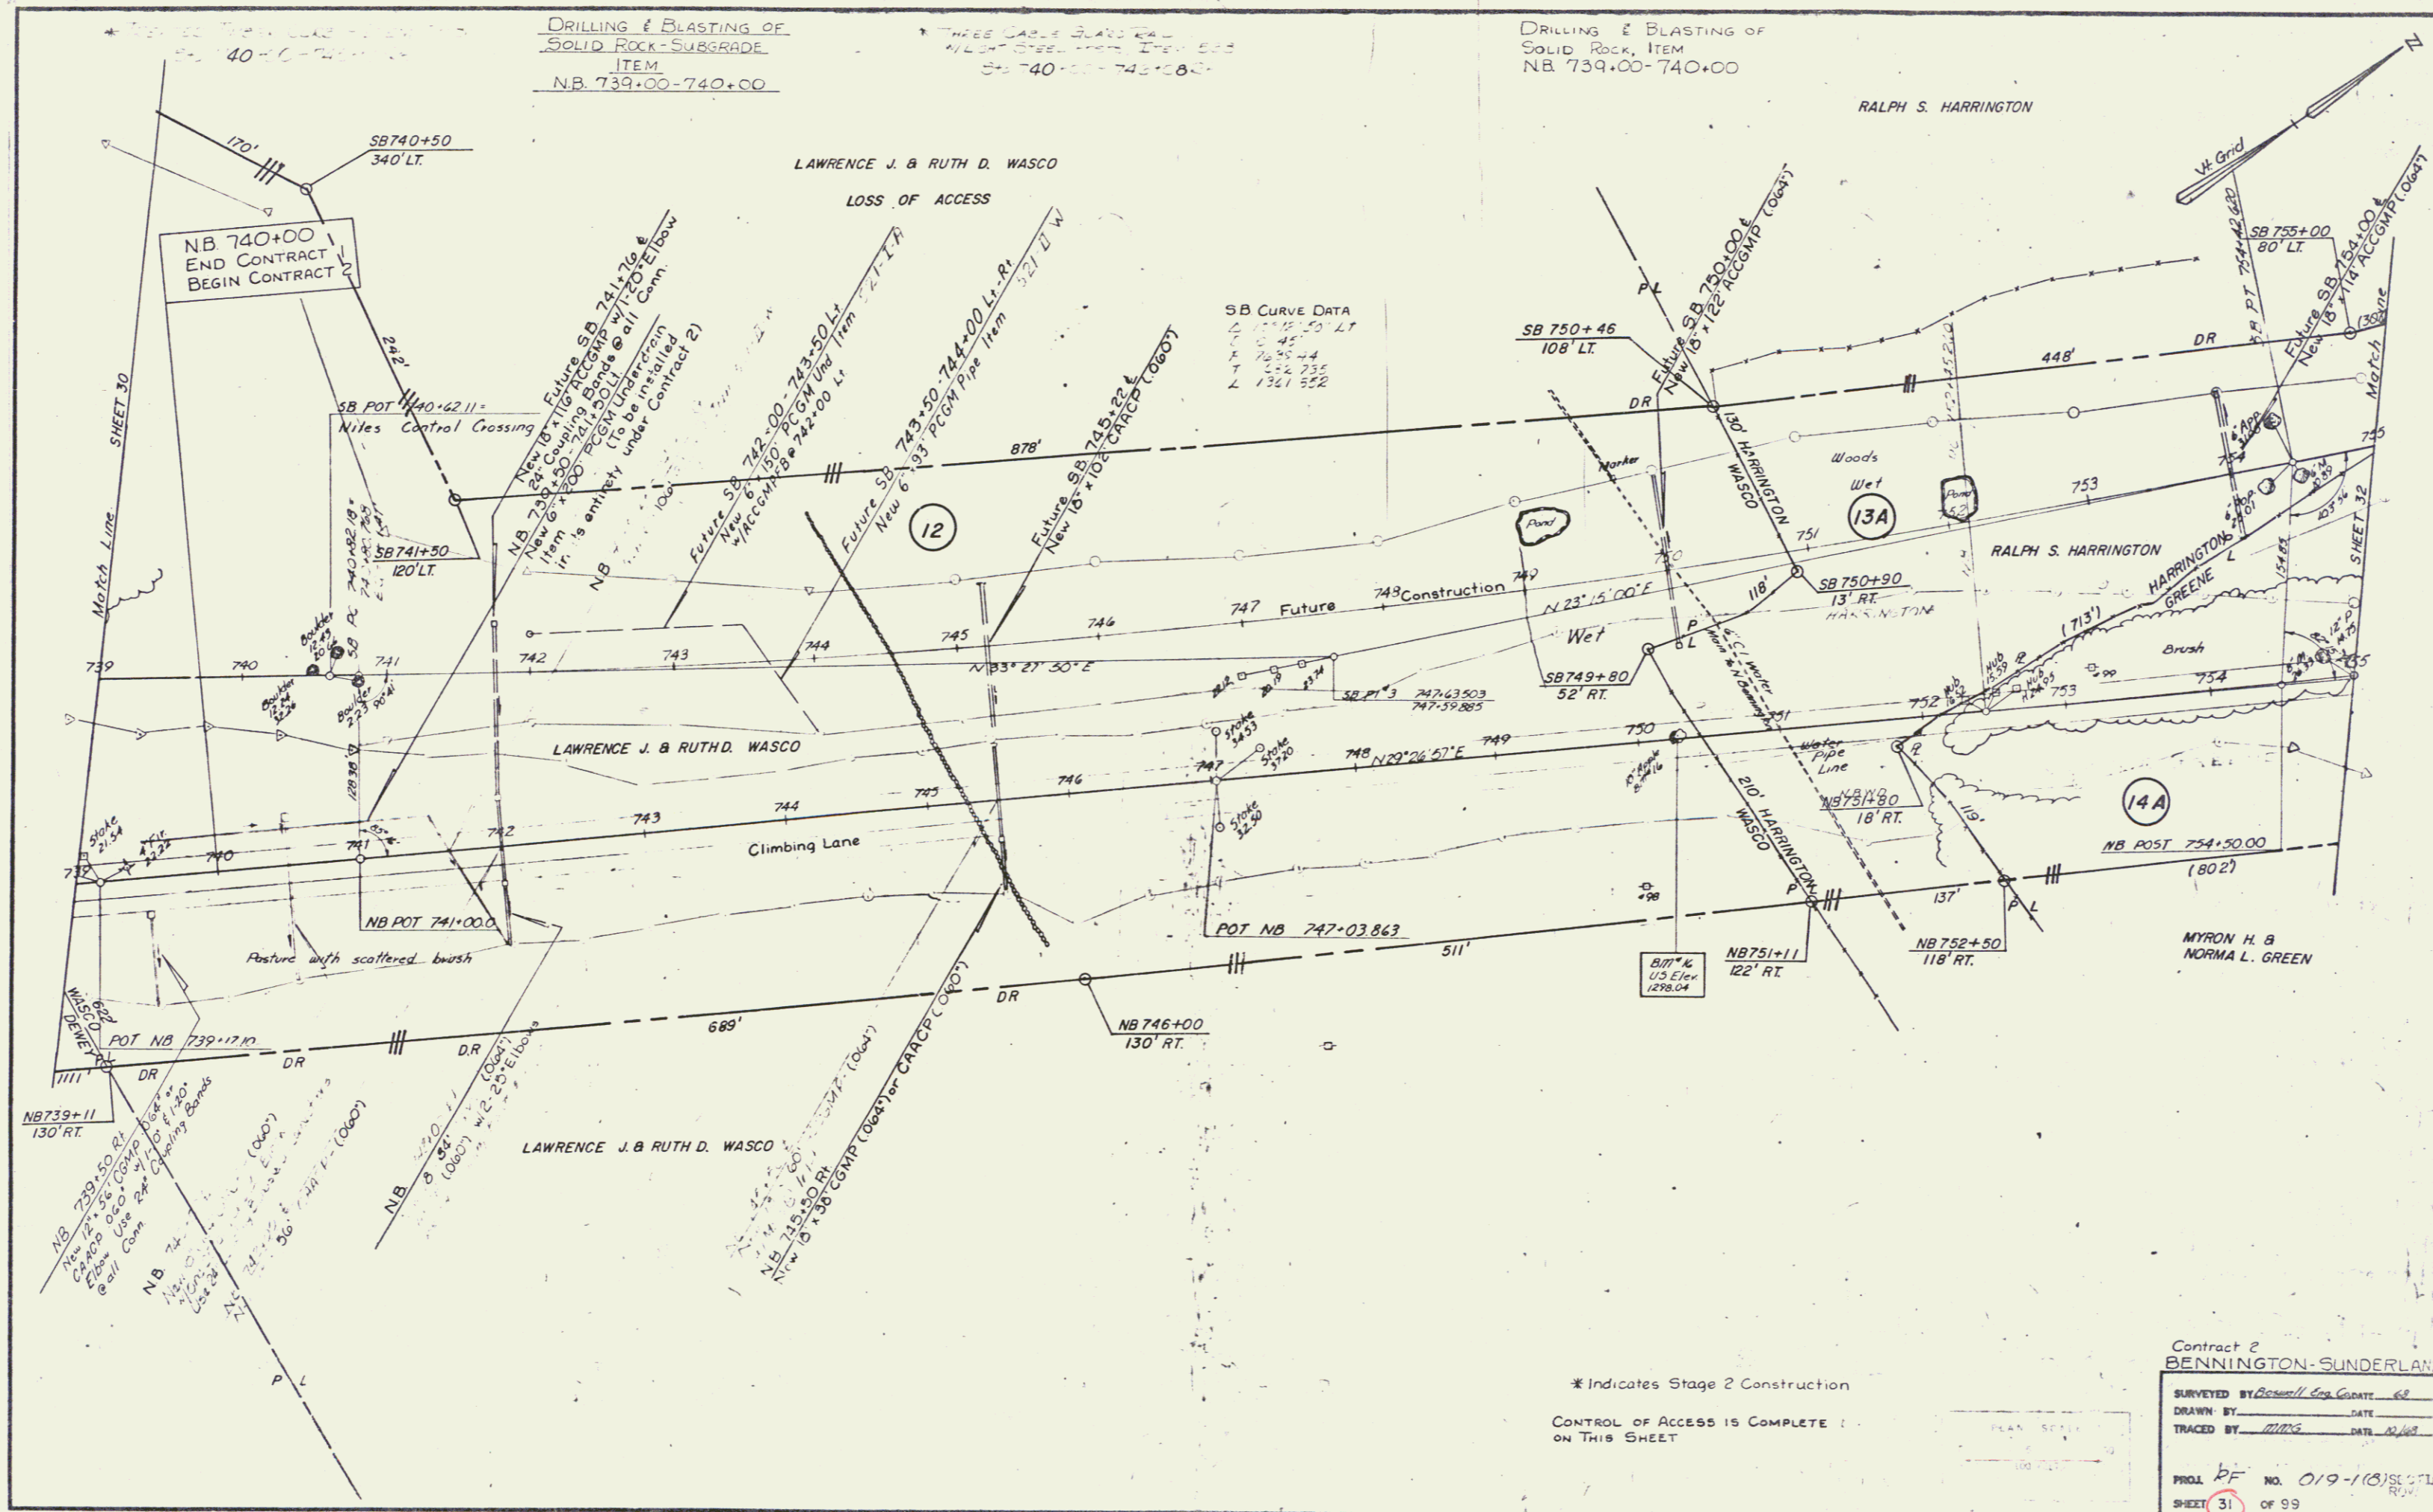

* Indicates Stage 2 Construction

CONTROL OF ACCESS IS COMPLETE
ON THIS SHEET

Contract 2
BENNINGTON-SUNDERLAND

SURVEYED BY	DATE
DRAWN BY	DATE
TRACED BY	DATE

PROJ. NO. 019-118

SHEET 31 OF 99