

VERTICAL GRANITE CURB, Item 556-B
 N 371+00 - 351+00 RT
 N 373+00 - 351+00 LT

GRANITE SLOPE EDGING, Item 556-A
 N 365+00 - 351+00 LT & RT

DRILLING AND BLASTING OF SOLID ROCK SUBGRADE, Item 115
 N 367+25 - 371+00
 Skyline 17+00 - 21+50


SUB-BASE OF SAND, Item 202
 N 365+00 - 381+00

STONE FILL FOR SLOPE PROTECTION (LIGHT TYPE), Item 512
 N 366+25 - 367+25 RT
 Skyline 20+21 - 20+51 LT
 Skyline 22+40 - 23+25 LT
 Skyline 16+20 - 22+25 RT

THREE CABLE GUARD RAIL w/ LIGHT STEEL POSTS
 Item 535
 N 365+00 - 368+48 LT

TWO CABLE GUARD RAIL, Item 541
 Skyline 15+00 - 24+83 LT

Δ 33°09'30" Lt
 D 3+50'
 R 1632.02
 T 487.37
 L 947.38
 E 71.06
 Bank 1/4" in 12"

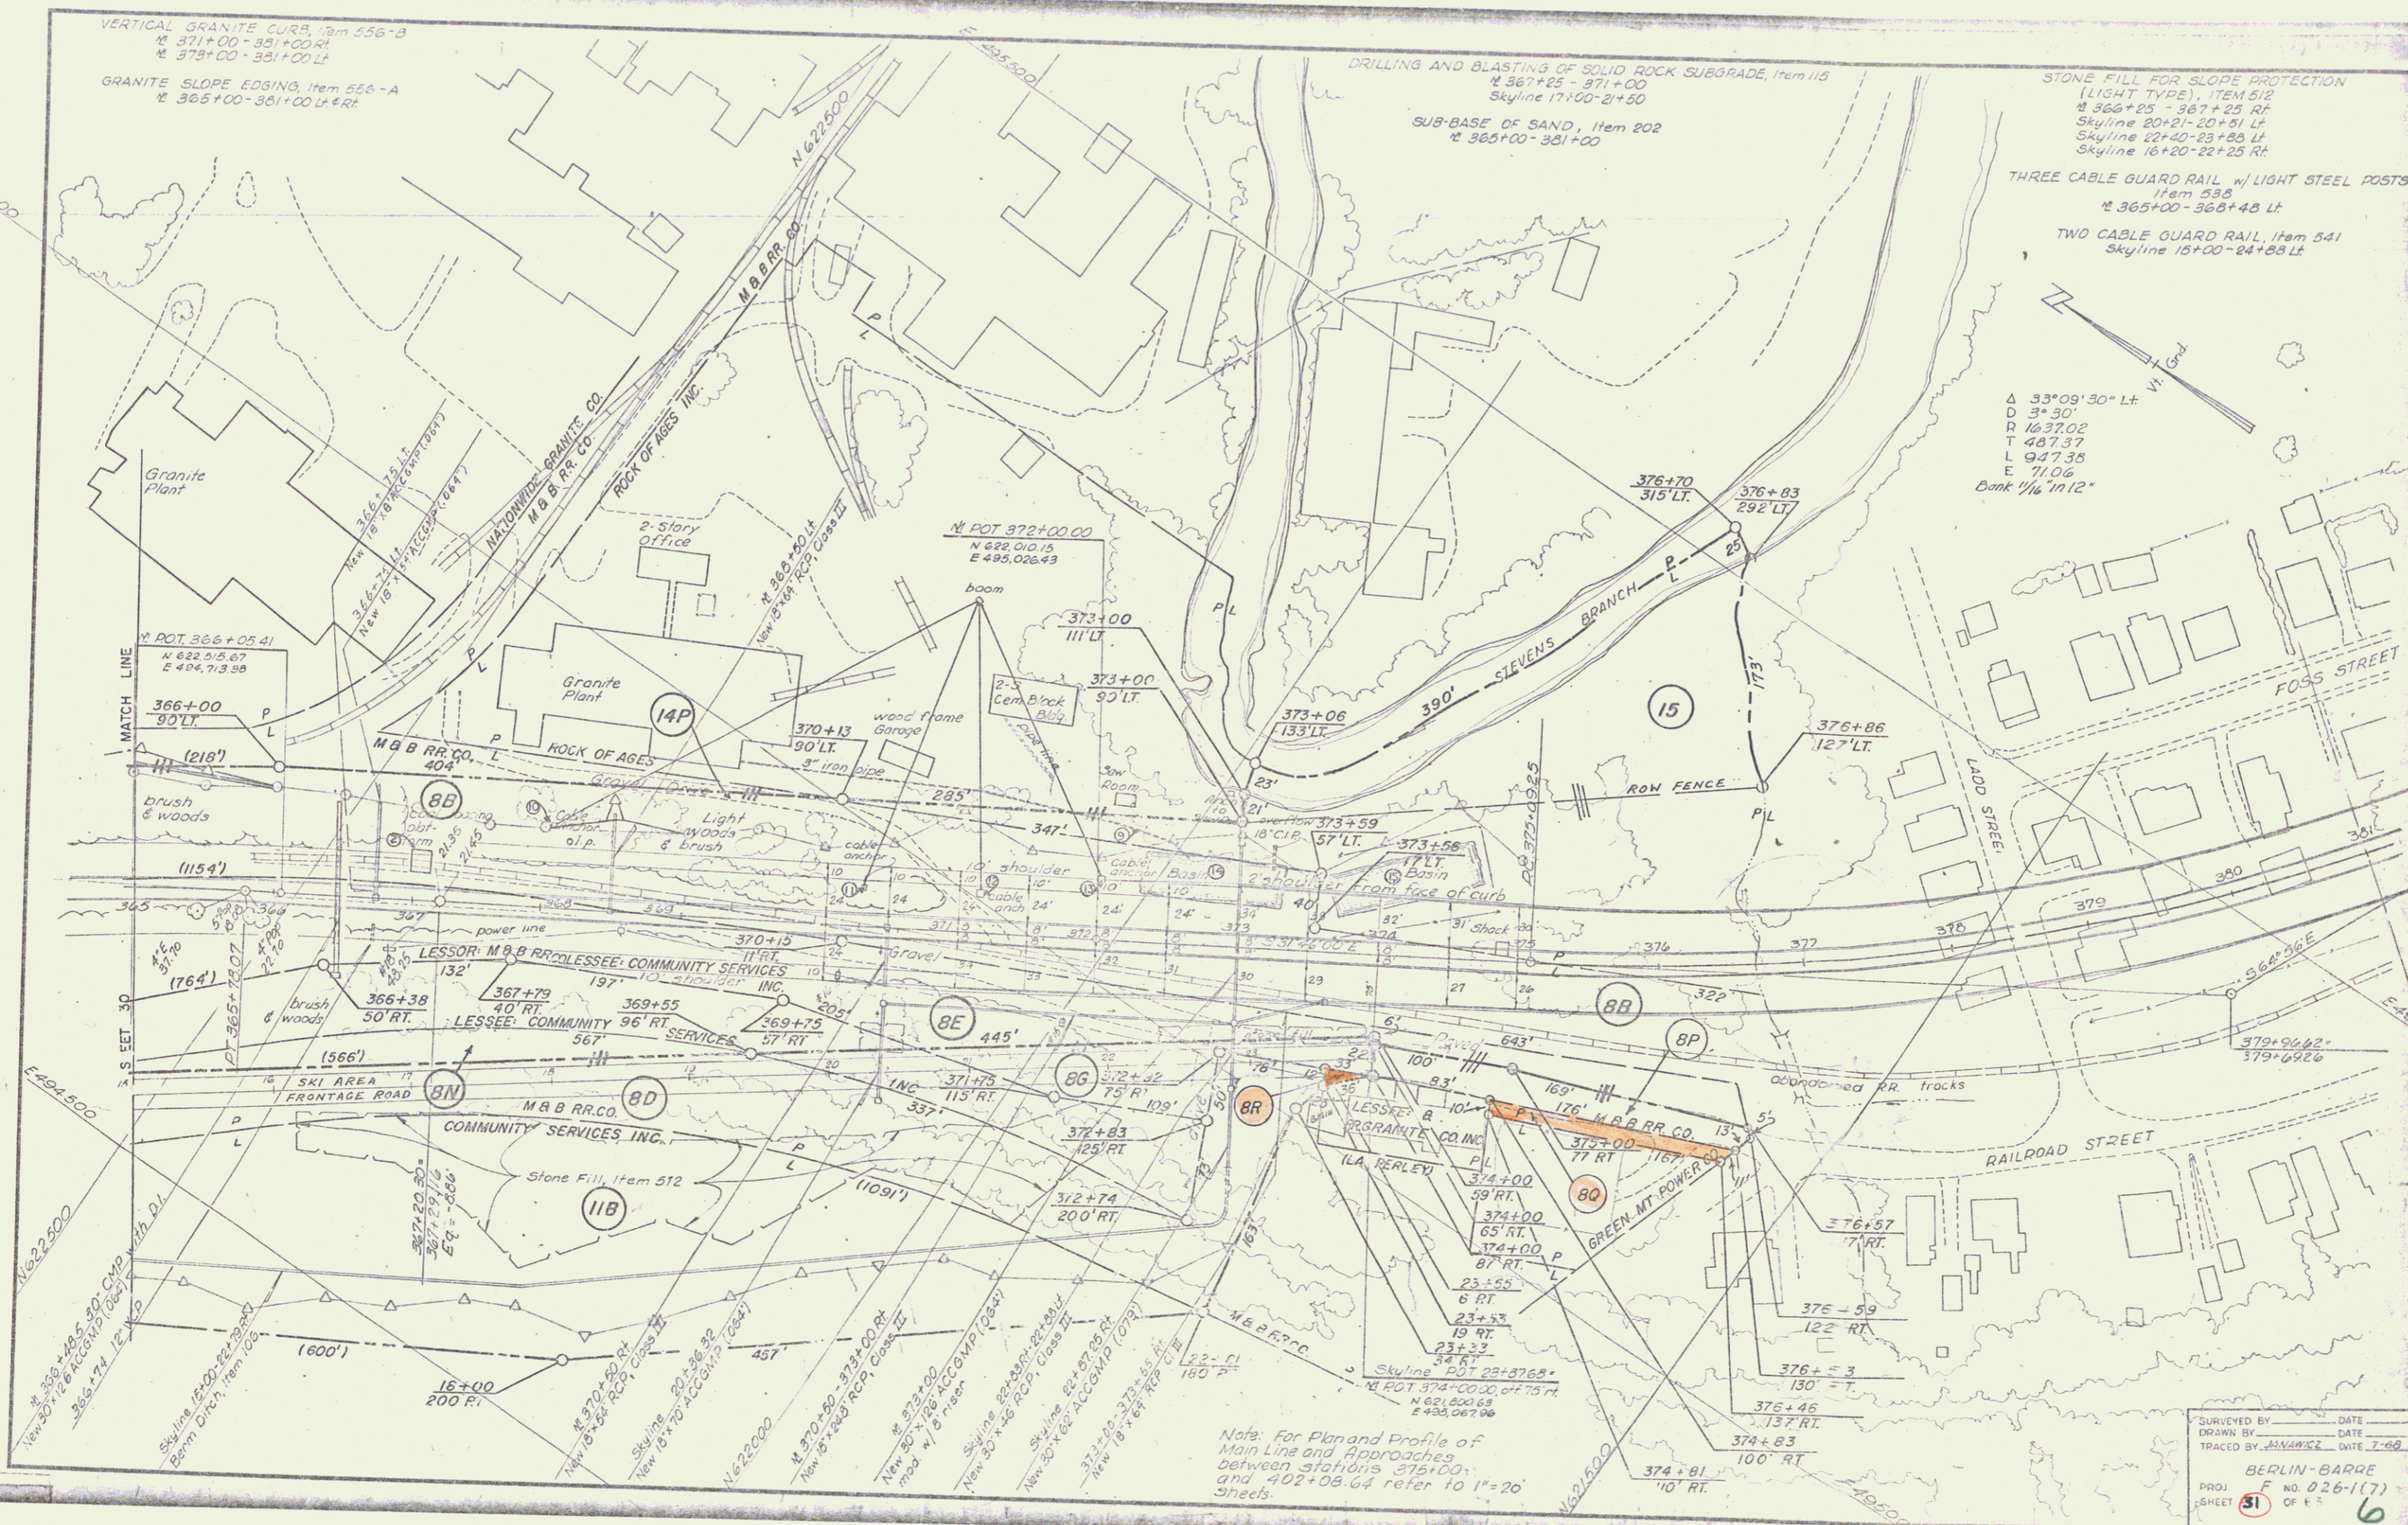

Note: For Plan and Profile of Main Line and Approaches between stations 375+00 and 402+08.64 refer to 1"=20' Sheets.

SURVEYED BY _____ DATE _____
 DRAWN BY _____ DATE _____
 TRACED BY JAWANICK DATE 7-48

BERLIN-BARRE
 F NO 026-1(7)
 SHEET 31 OF 66