
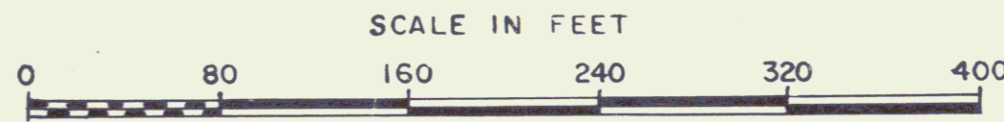
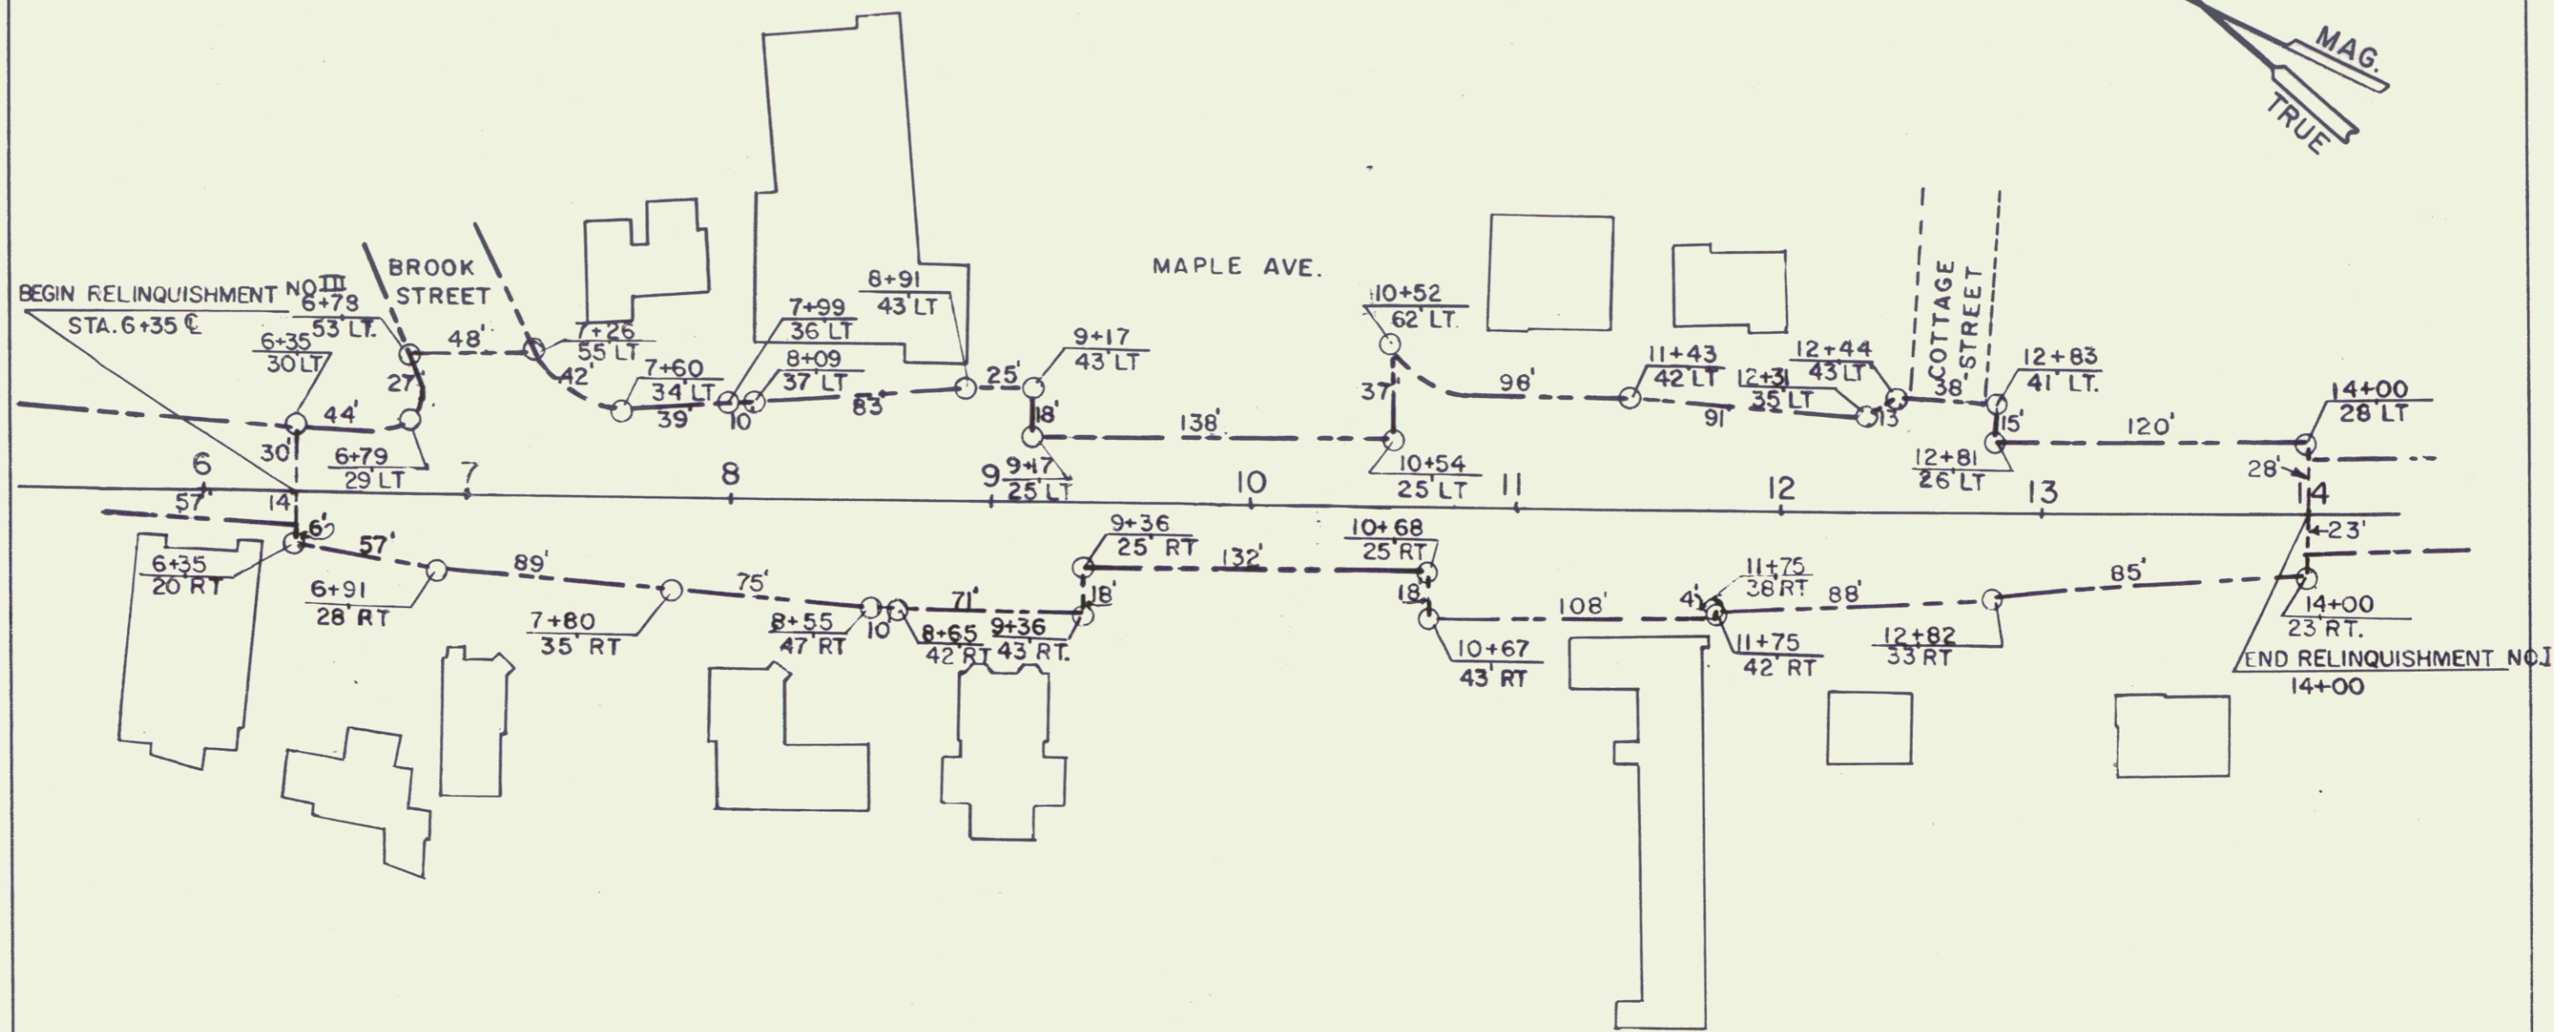


ON FILE IN VT 62
NEED DOCUMENT

SEE SHEET NOS. 39 & 45

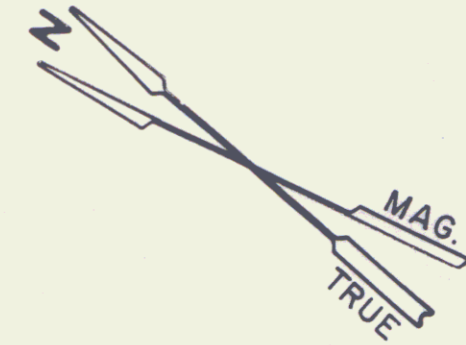

45302

STATE OF VERMONT DEPT. OF HIGHWAYS		
Relinquishment Plat 40A		
City of Barre		
North Main Street 27		
PROJECT BERLIN-BARRE F 026-(7)		
APPROX. SCALE 1"=80'	DATE 3/3/77	DRAWN BY A.G.S.